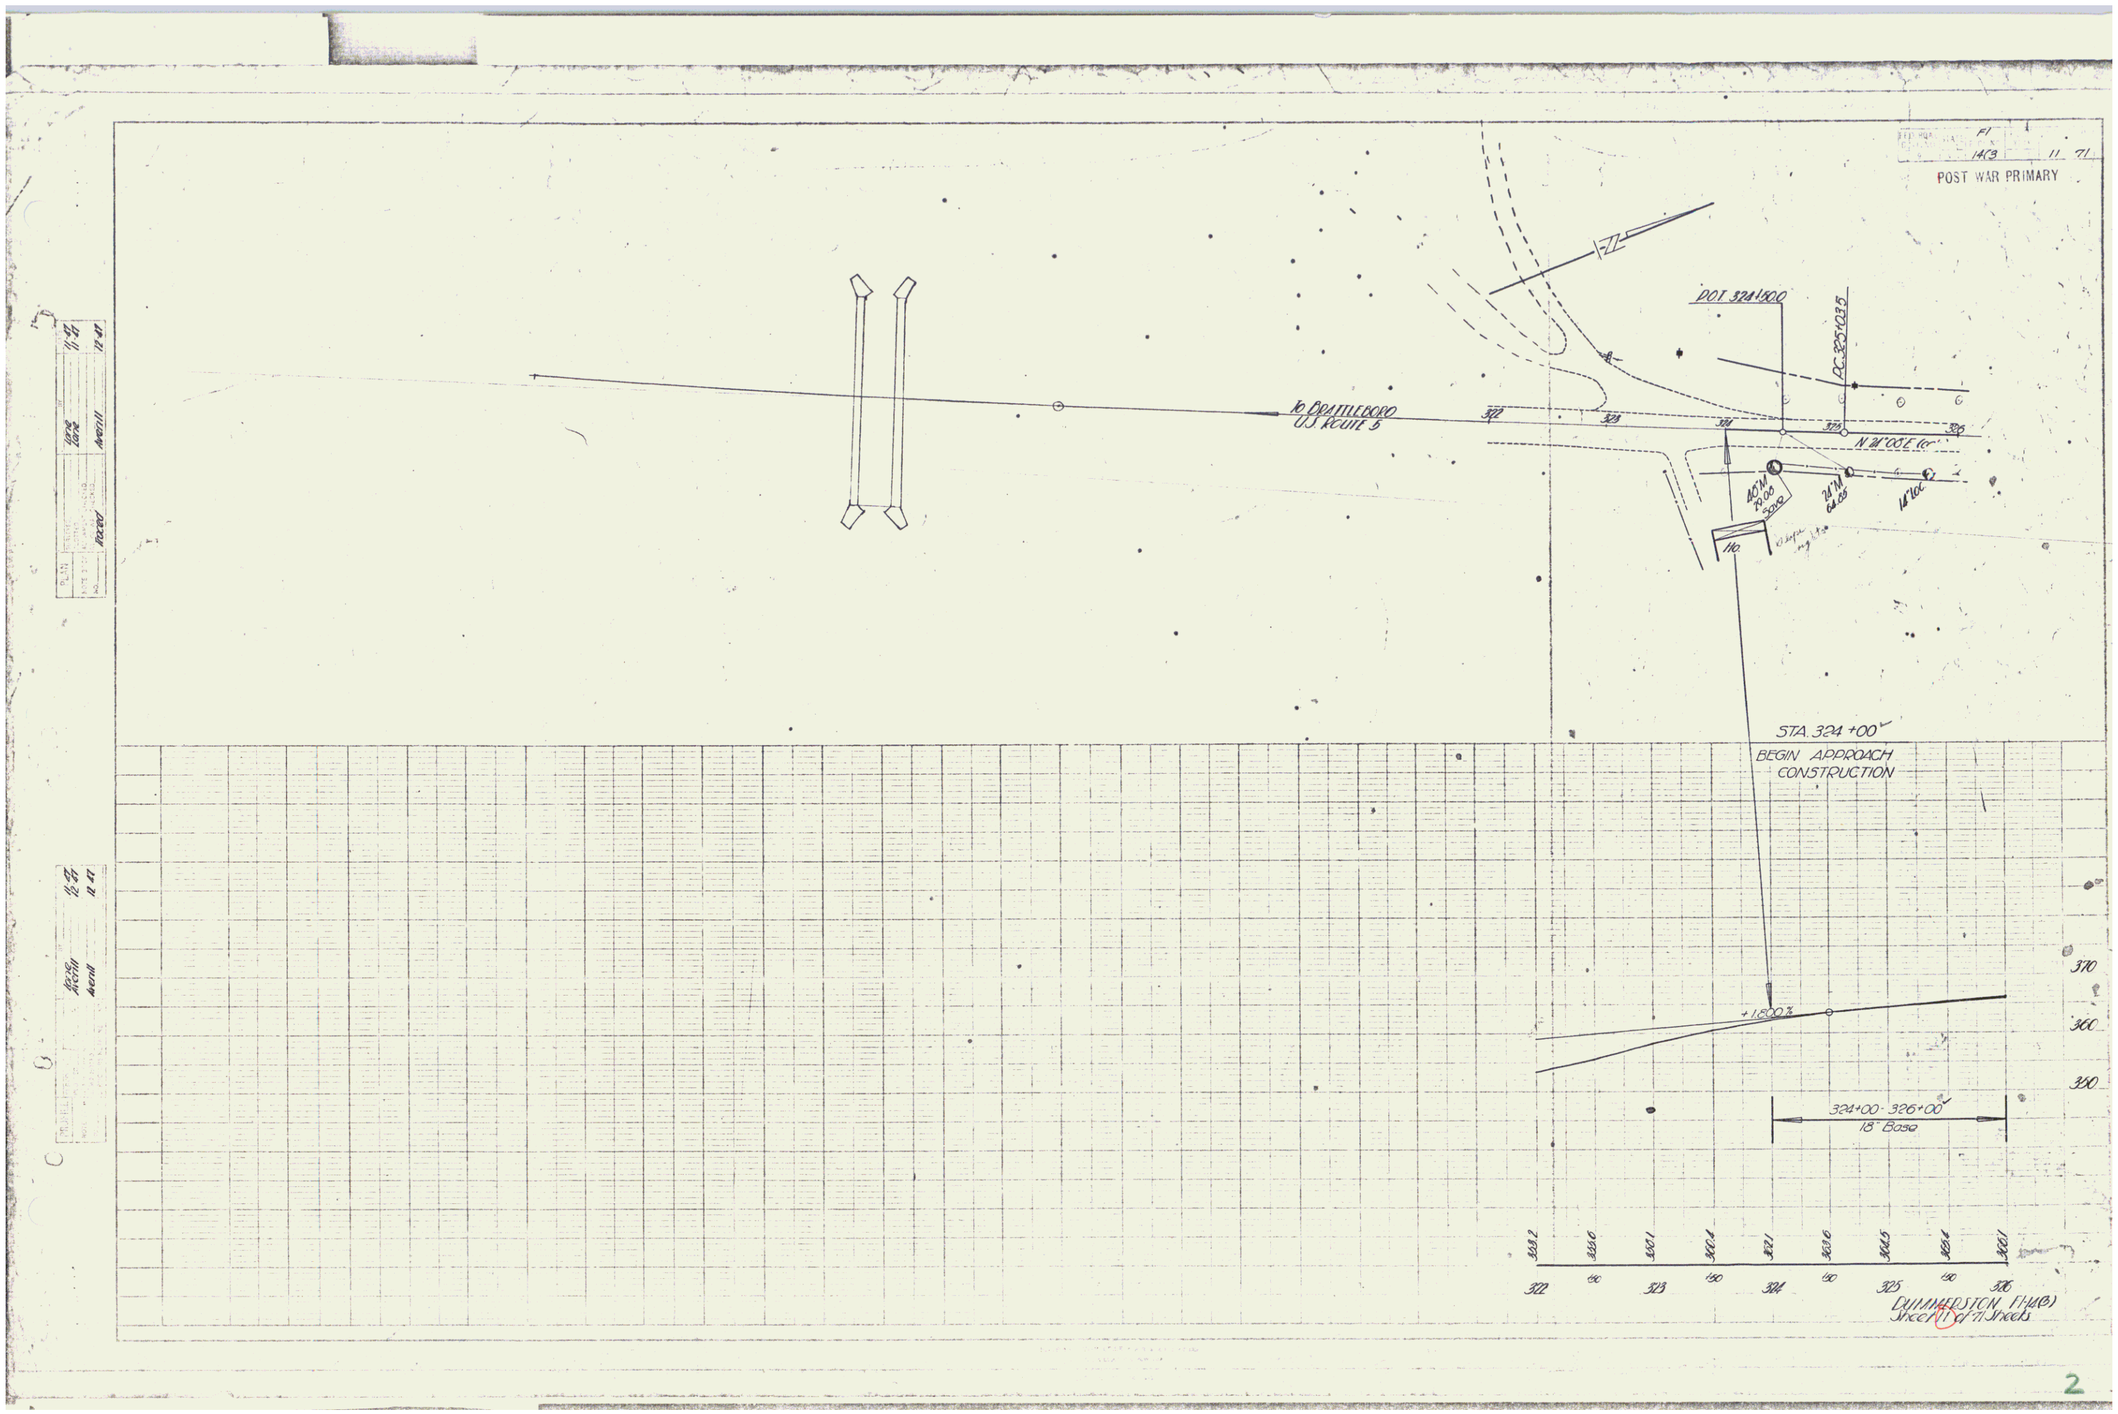
F1
1413 11 71
POST WAR PRIMARY
DOT 324+00.0
PC 325+03.5
To BRATTLEBORO
US ROUTE 5
N 24°00'E 16°
STA. 324 +00
BEGIN APPROACH
CONSTRUCTION
+1.800%
324+00 - 326+00
18" Base
370
360
350
DIMMERSTON F14(8)
Sheet 11 of 11 Sheets

2