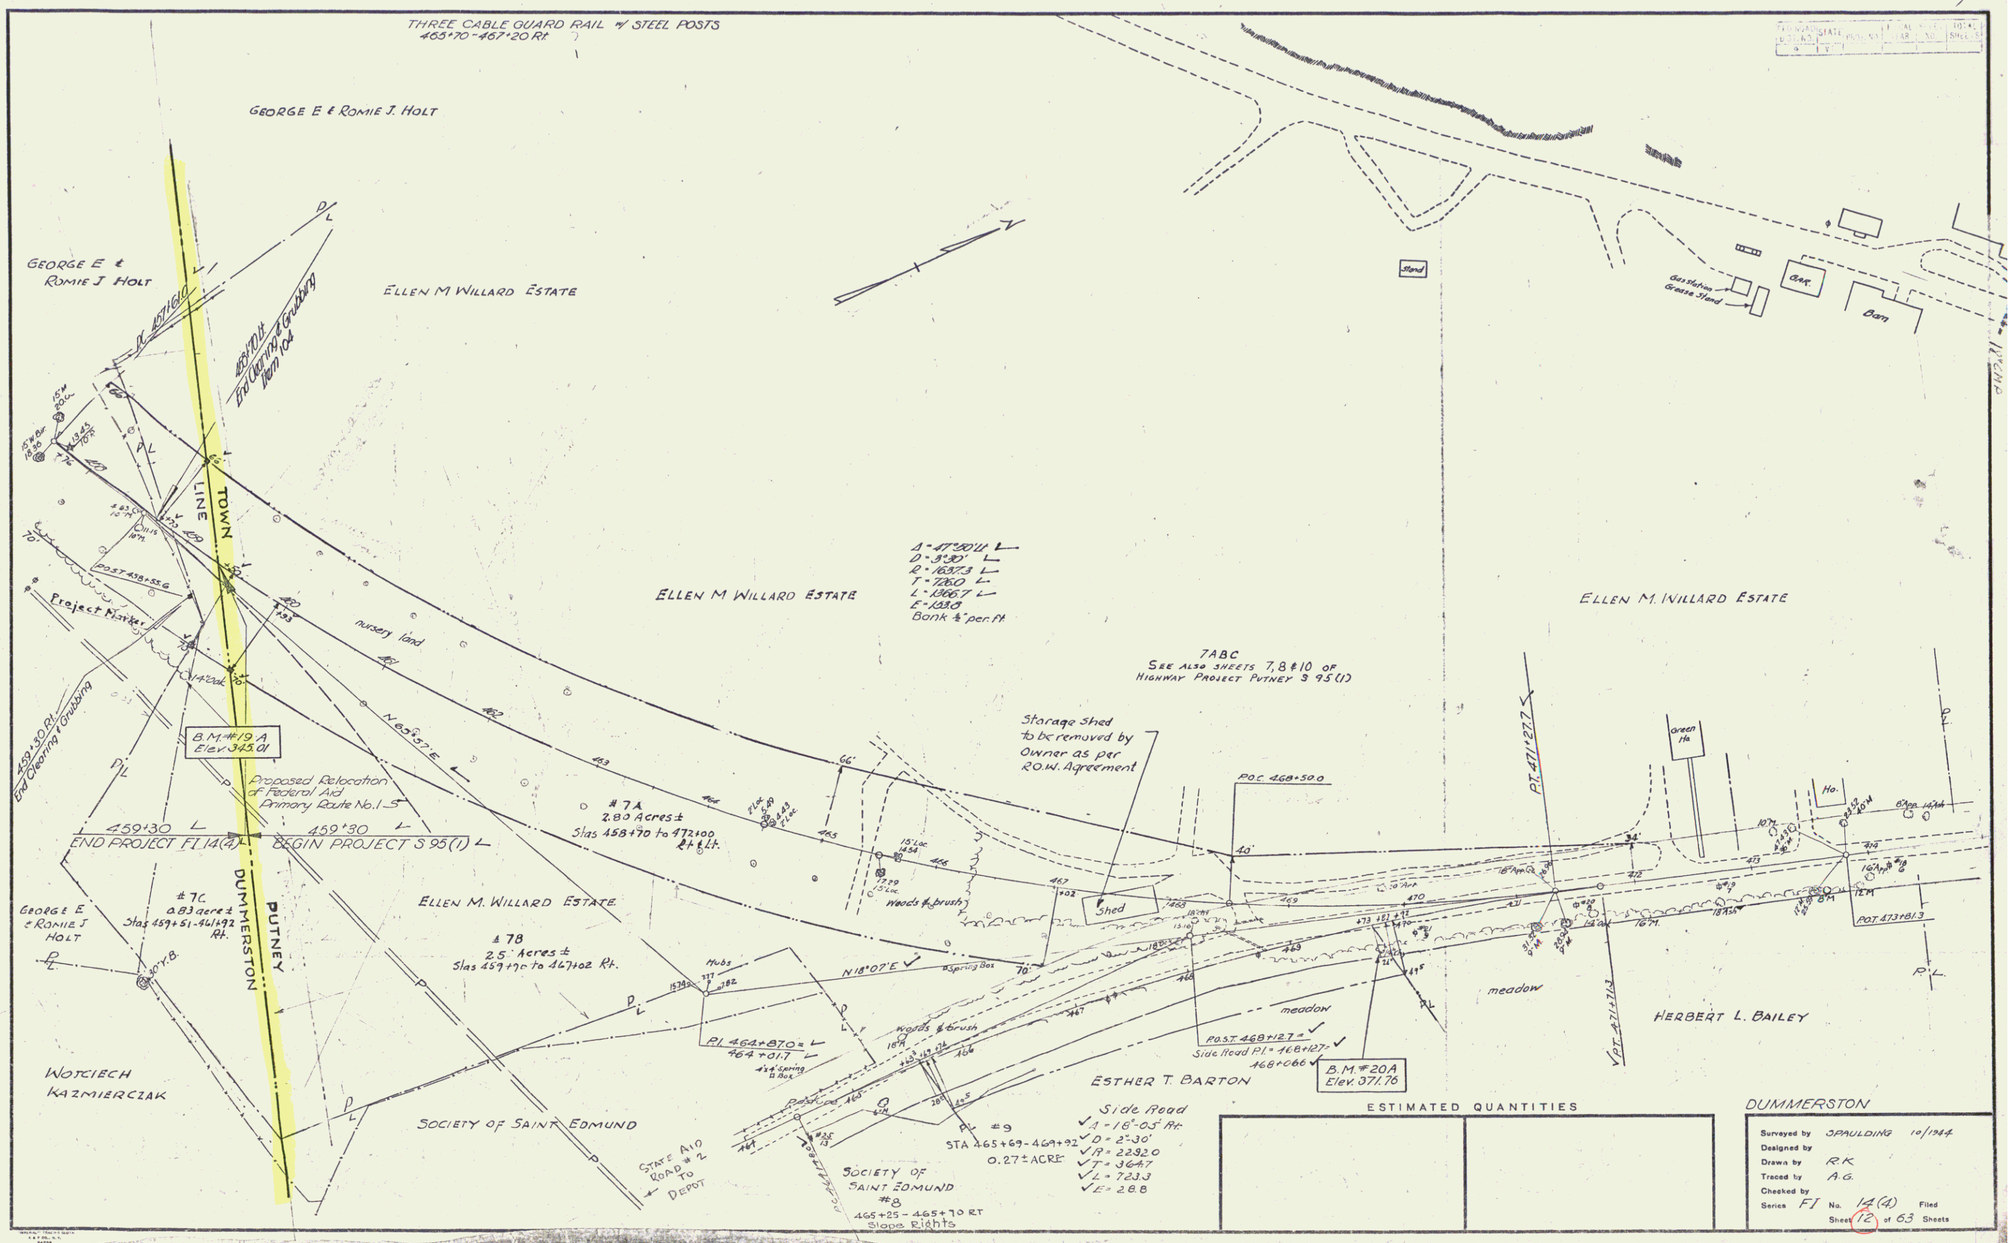
THREE CABLE GUARD RAIL w/ STEEL POSTS
465+70 - 467+20 Rt.
GEORGE E & ROMIE J. HOLT
GEORGE E & ROMIE J. HOLT
ELLEN M WILLARD ESTATE
ELLEN M WILLARD ESTATE
ELLEN M. WILLARD ESTATE
TOWN LINE
Project Marker
nursery land
B.M. #19 A
Elev. 345.01
Proposed Relocation of Federal Aid Primary Route No. I-5
459+30 L
END PROJECT F.I. 14(4)
459+30
BEGIN PROJECT S 95(1)
DUMMERSTON
PUTNEY
#7C
0.83 acres ±
Slas 459+51-461+92 Rt.
GEORGE E & ROMIE J HOLT
WOTCIECH KAZMIERCZAK
SOCIETY OF SAINT EDMUND
#7A
2.80 Acres ±
Slas 458+70 to 472+00 Lt & Rt.
#7B
2.5 Acres ±
Slas 459+70 to 467+02 Rt.
ELLEN M. WILLARD ESTATE
Δ = 47°50'14" L
D = 3°30' L
R = 1637.3 L
T = 726.0 L
L = 1366.7 L
E = 123.0
Bank & per. ft.
7ABC
SEE ALSO SHEETS 7, 8 & 10 OF HIGHWAY PROJECT PUTNEY S 95(1)
Storage Shed to be removed by Owner as per R.O.W. Agreement
Shed
POC 468+50.0
PT. 471+27.7
Green Ho.
Ho.
POT 473+81.3
meadow
meadow
HERBERT L. BAILEY
ESTHER T. BARTON
POST 468+127 ±
Side Road PI = 468+127 = 468+060
B.M. #20A
Elev. 371.76
Gas Station Grade Stand
Stand
Barn
Bank
STATE AID ROAD #2 TO DEPOT
#9
STA 465+69 - 469+92
0.27 ± ACRE
Side Road
Δ = 18°-05' Rt.
D = 2°-30'
R = 2292.0
T = 364.7
L = 723.3
E = 28.8
SOCIETY OF SAINT EDMUND
#8
465+25 - 465+70 RT
Slope Rights
ESTIMATED QUANTITIES
DUMMERSTON
Surveyed by SPAULDING 10/1944
Designed by
Drawn by R.K.
Traced by A.G.
Checked by
Series F.I. No. 14(4) Filed
Sheet 12 of 63 Sheets