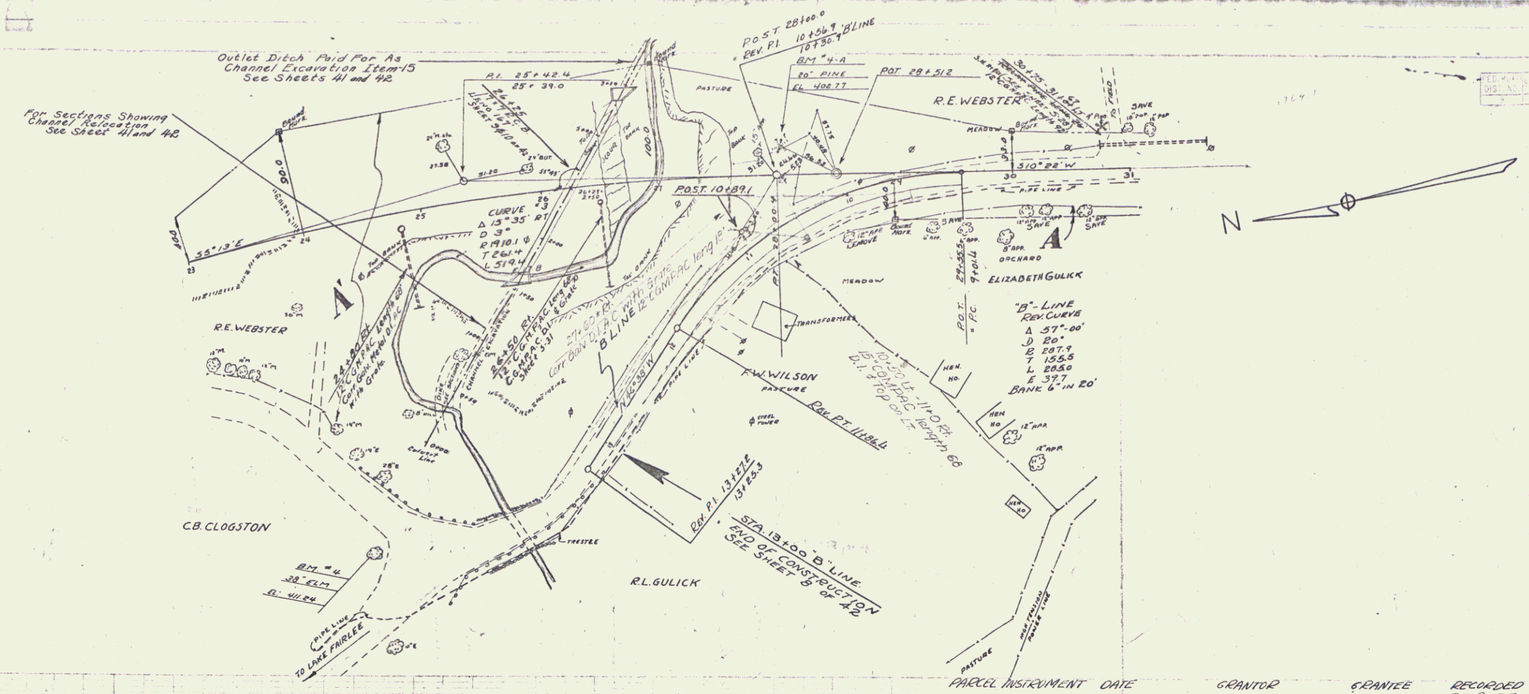

PARCEL	INSTRUMENT	DATE	GRANTOR	GRANTEE	RECORDED FAIRLEE BOOK	PAGE	DATE	REMARKS
A	Q.C.D	5-17-38	ELIZABETH GULICK	ST. OF VT.	18	171-2	5-24-38	
A'	W.D.	7-19-38	IVA T. WEBSTER	"	18	194-5	7-30-38	

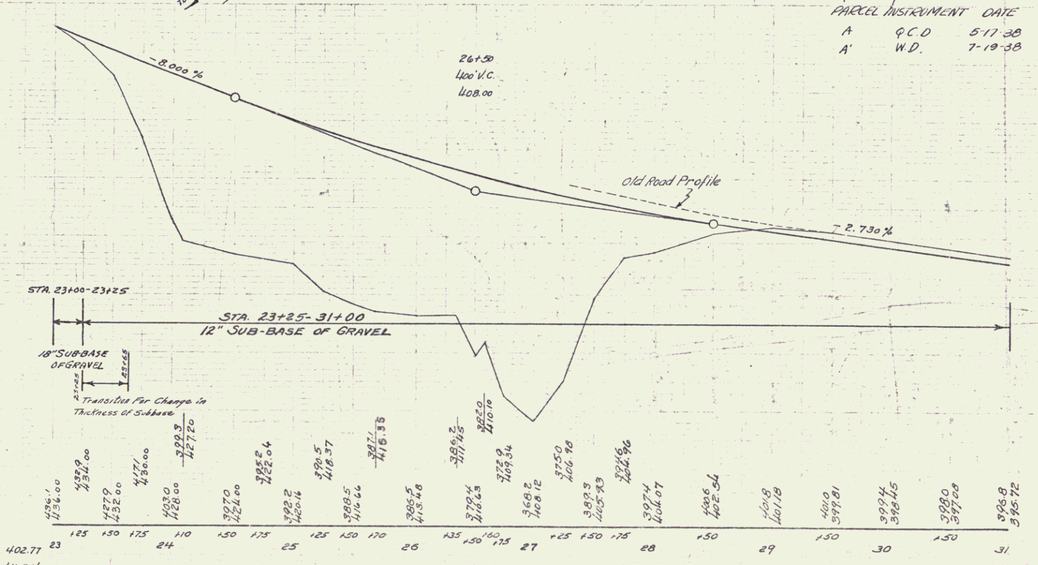

B.M. "4-A SPIKE IN ROOT 20" PINE 23' LT STA. 28+05 EL. 402.77
B.M. #4 SPIKE IN ROOT 38" ELM 285' RT STA. 23+85 EL. 411.24

SERIES FAP NO. 236A
SHEET 6 OF 42

4