F.A.P. No.	STATE	F.A.P. No.	YEAR	SHEET No.	TOTAL SHEETS
7	VT	236-A	1939	7	62

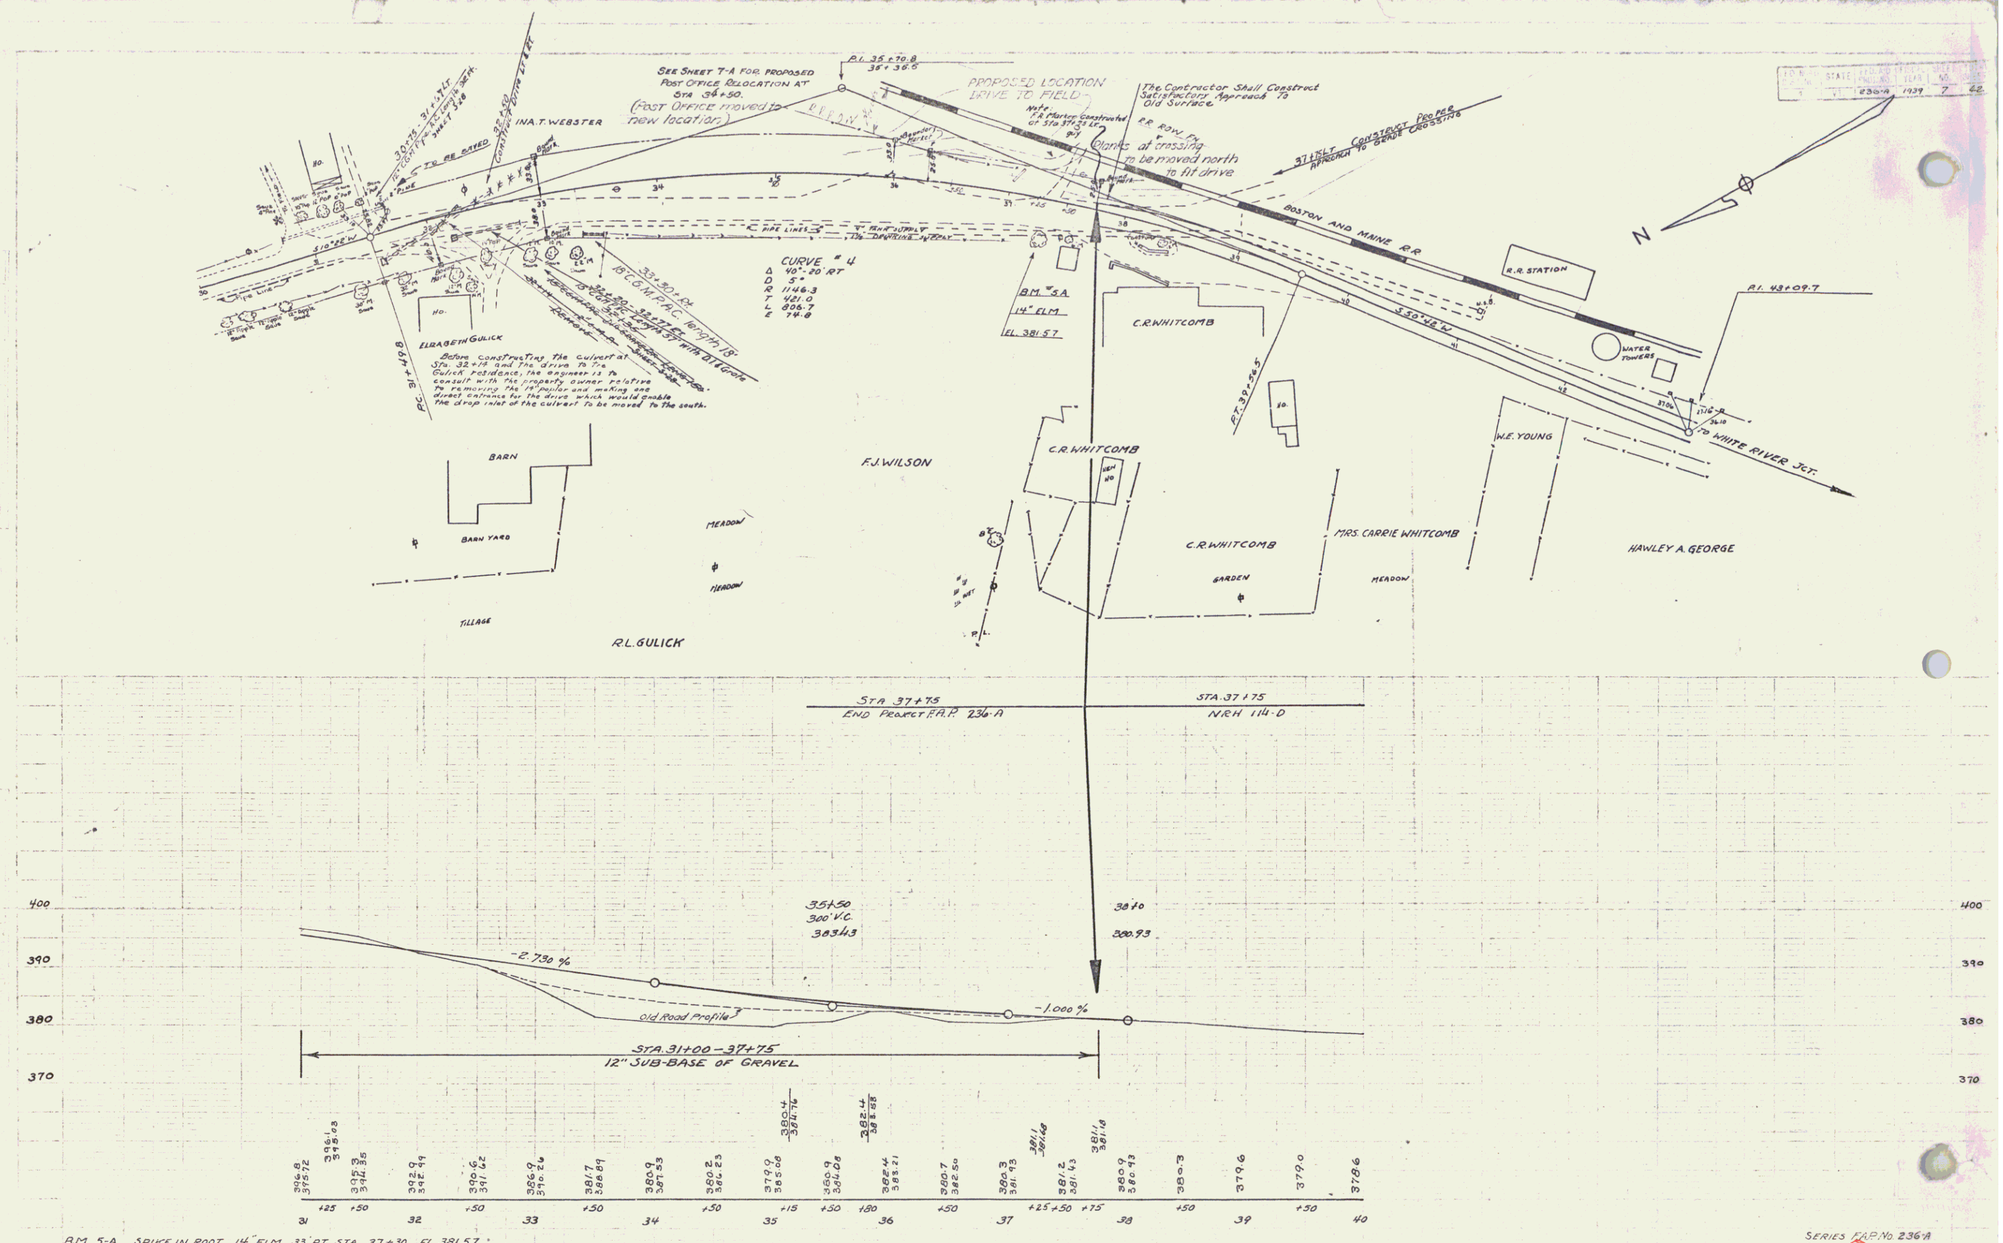

SERIES F.A.P. No 236-A
SHEET 7 OF 62

5