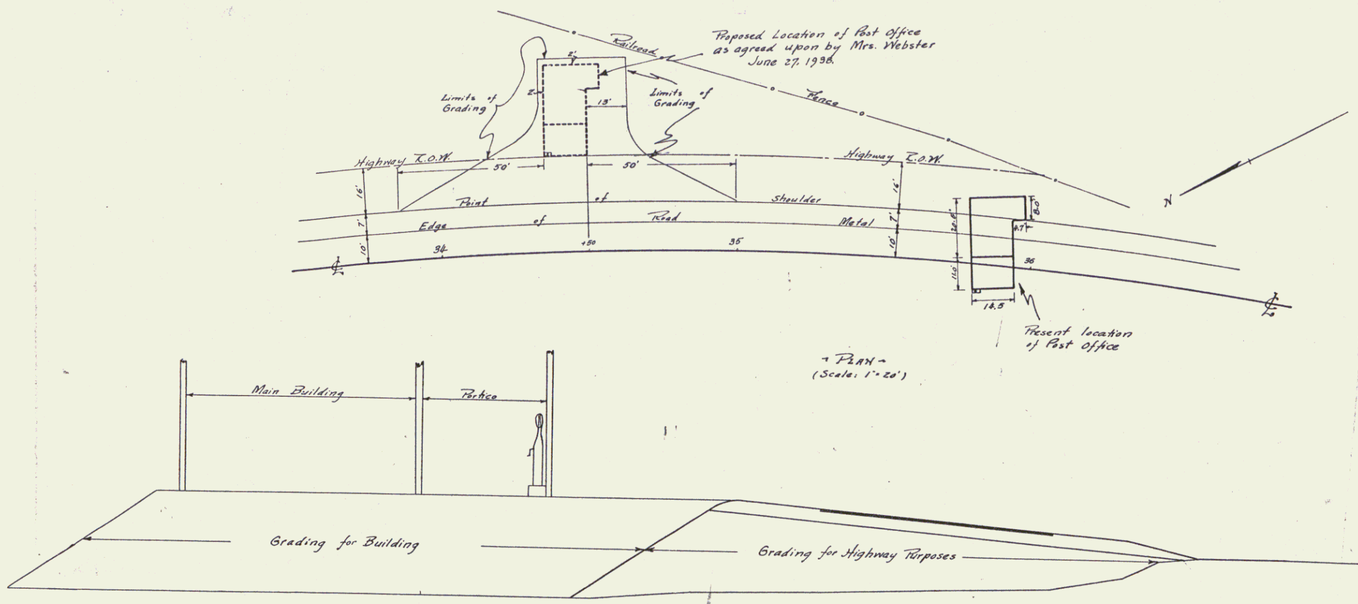

FAIRLEE - 296-A
(Post Office Relocation)
June 28, 1936.

~ SHEET 7-A of 42. ~

7A

6