FED. ROAD DIST. NO.	STATE	PROJECT NO.	FISCAL YEAR	SHEET NO.	TOTAL SHEETS
9	VT.	2368-(1)	1941	5	41

F.A.P.

FAIRLEE

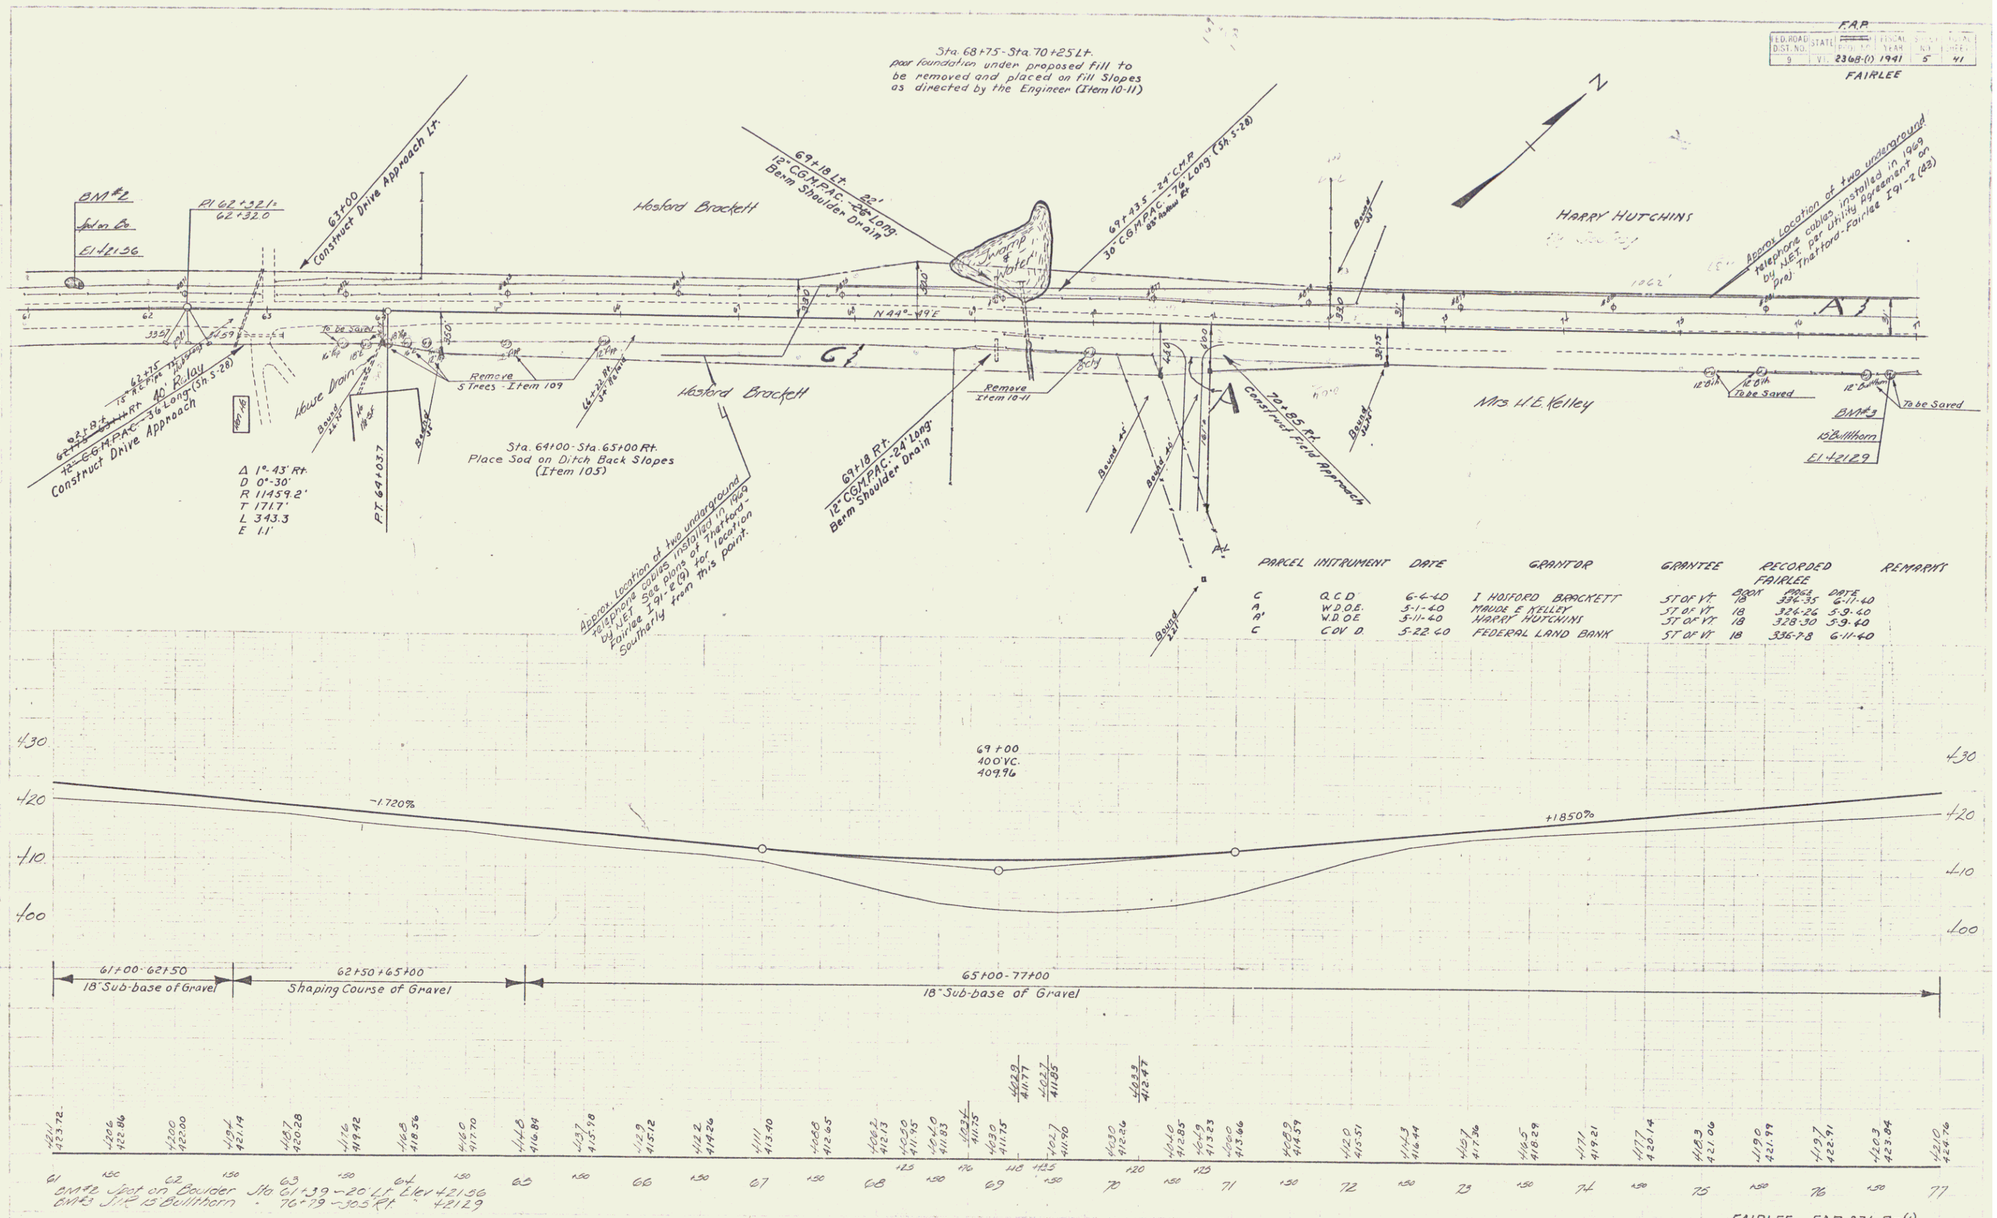
Sta. 68+75 - Sta. 70+25 Lt.
poor foundation under proposed fill to be removed and placed on fill Slopes as directed by the Engineer (Item 10-11)
N
BM #2
Spike on Bo
El 421.36
PI 62+32.1'
62+32.0
Construct Drive Approach Lt.
69+18 Lt.
Berm Shoulder Drain
69+43.5 - 24" CMP
30" CGMPAC - 76' Long (Sh. 5-28)
Hosford Brackett
HARRY HUTCHINS
Approx. location of two underground telephone cables installed in 1969 by NET per utility agreement on proj. Thetford-Fairlee FAP-2 (43)
N 44°-49' E
Remove 5 Trees - Item 109
Remove Item 10-11
House Drain
Bound 2.5'
Bound 1.8'
Bound 2.0'
Bound 2.5'
Bound 2.0'
Bound 2.5'
Bound 2.5'
Bound 2.5