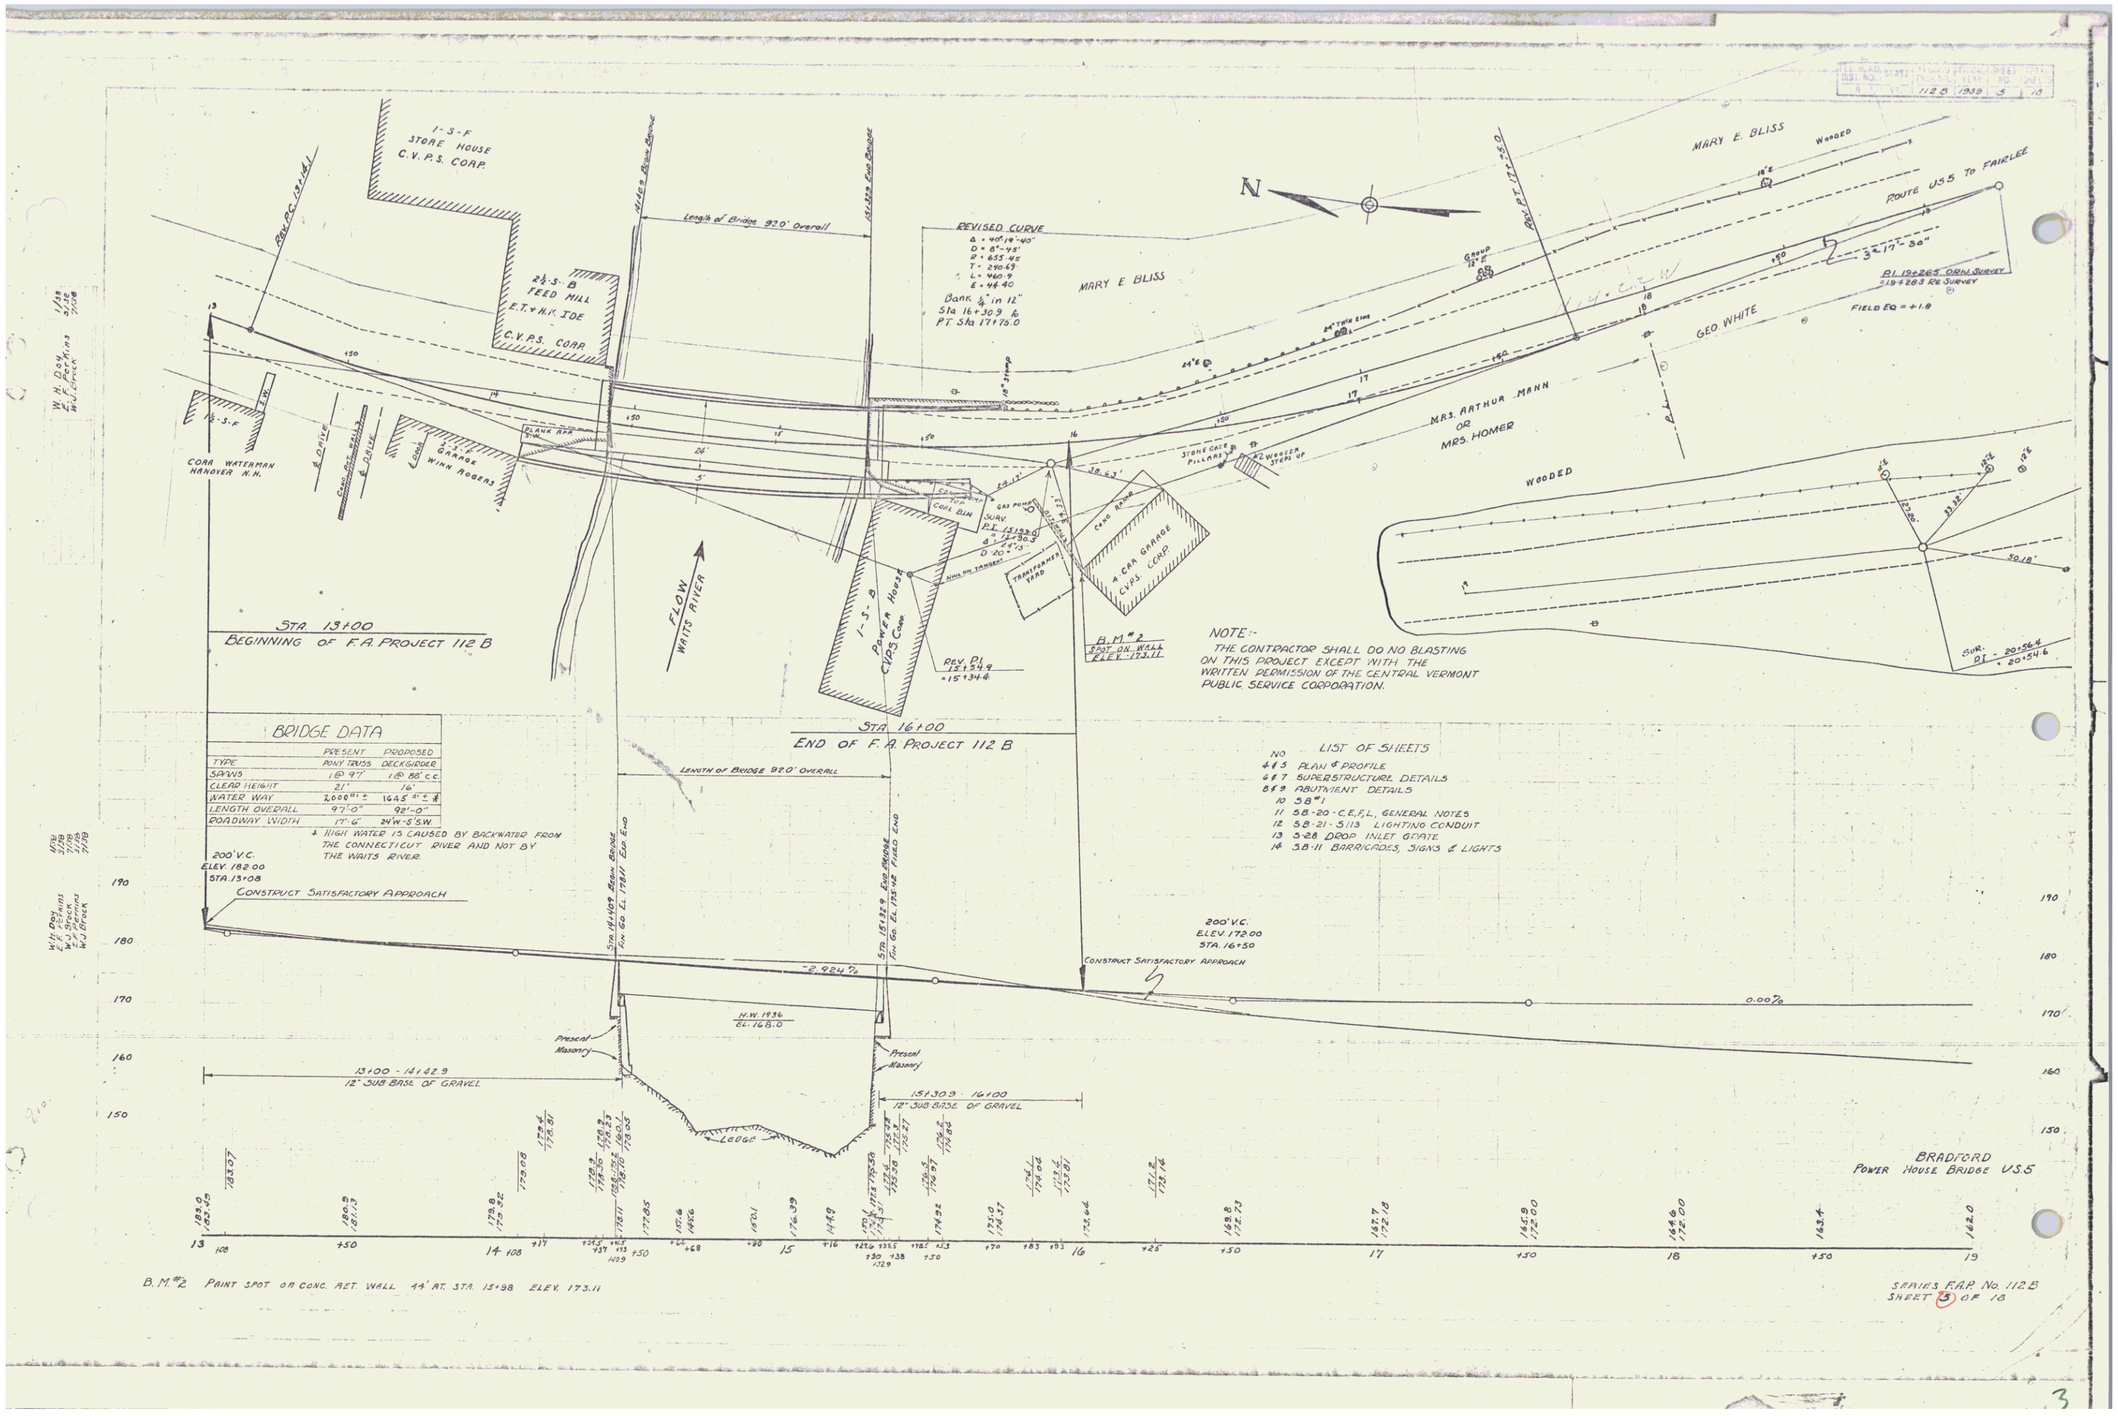


## BRIDGE DATA

| | PRESENT | PROPOSED |
|---|---|---|
| TYPE | PONY TRUSS | DECK GIRDER |
| SPANS | 1 @ 97' | 1 @ 88' c.c. |
| CLEAR HEIGHT | 21' | 16' |
| WATER WAY | 2,000 sq ft ± | 1645 sq ft ± * |
| LENGTH OVERALL | 97'-0" | 92'-0" |
| ROADWAY WIDTH | 17'-6" | 24' W-5' SW |

* HIGH WATER IS CAUSED BY BACKWATER FROM THE CONNECTICUT RIVER AND NOT BY THE WAITS RIVER.

## LIST OF SHEETS

| NO | |
|---|---|
| 8 & 9 | ABUTMENT DETAILS |
| 10 | S.B. #1 |
| 11 | S.B.-20-C.E.F.L. GENERAL NOTES |
| 12 | S.B.-21-S.113 LIGHTING CONDUIT |
| 13 | S.B. DROP INLET GRATE |
| 14 | S.B.-11 BARRICADES, SIGNS & LIGHTS |