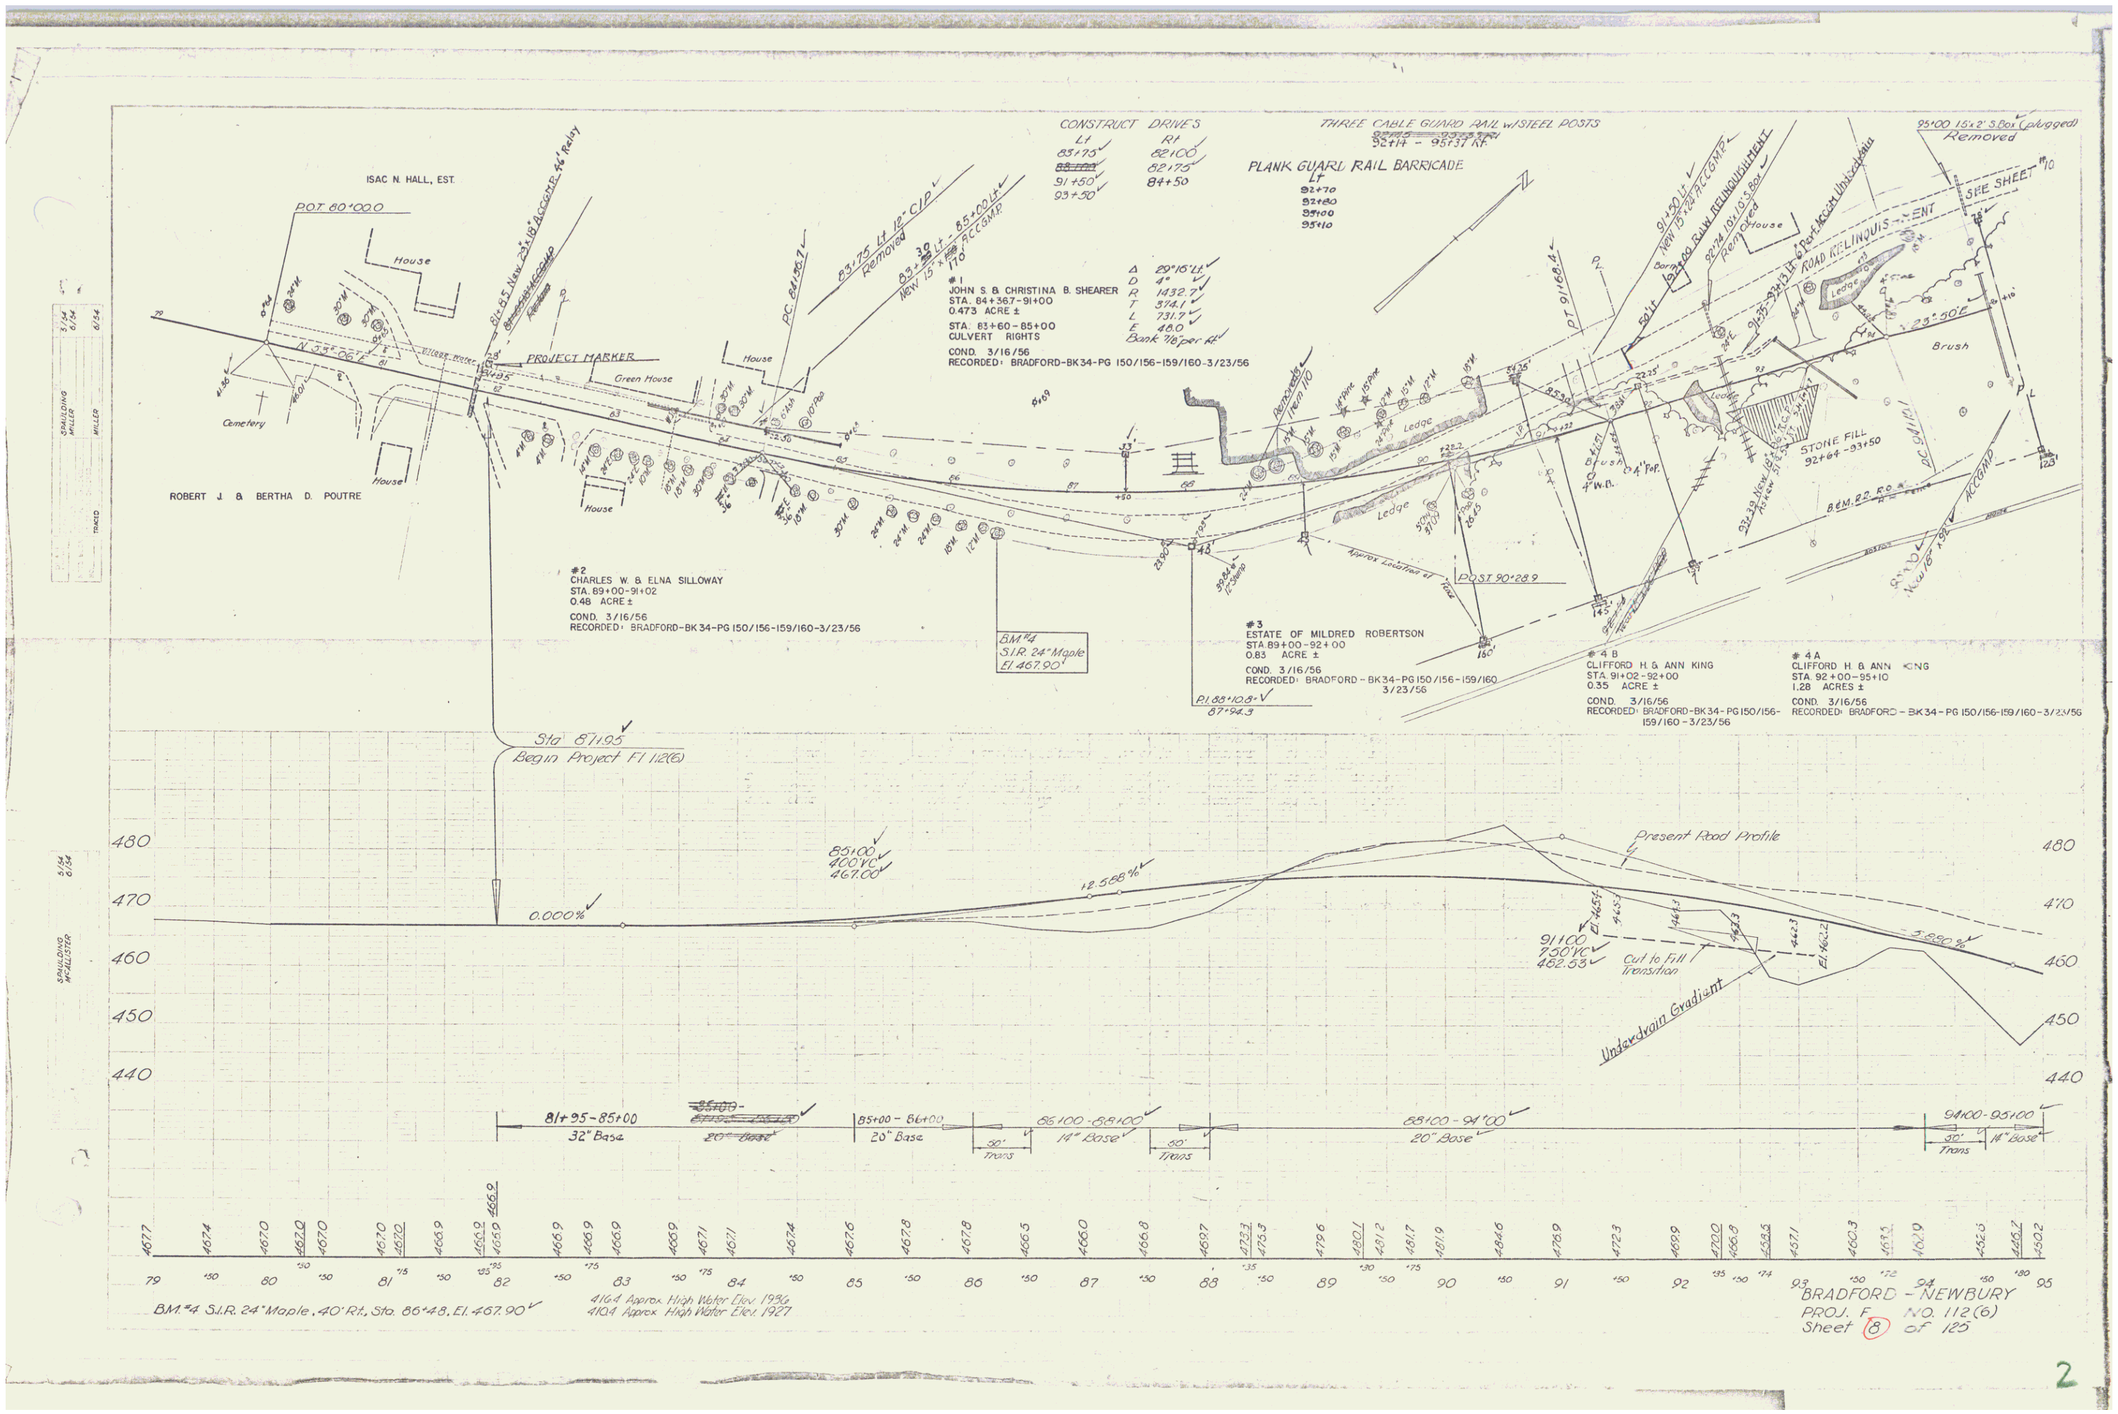
ISAC N. HALL, EST.
POT 80+00.0
House
Cemetery
ROBERT J. & BERTHA D. POUTRE
PROJECT MARKER
Green House
CONSTRUCT DRIVES
Lt 83+75 91+50 93+50
Rt 82+00 82+75 84+50
THREE CABLE GUARD RAIL w/STEEL POSTS
92+14 - 95+31 Rt.
PLANK GUARD RAIL BARRICADE
Lt 92+70 92+80 95+00 95+10
#1
JOHN S. & CHRISTINA B. SHEARER
STA. 84+567-91+00
0.473 ACRE ±
STA. 83+60-85+00
CULVERT RIGHTS
COND. 3/16/56
RECORDED: BRADFORD-BK34-PG 150/156-159/160-3/23/56
Δ 29°16'Lt
D 4°
R 1432.7'
T 374.1'
L 731.7'
E 48.0'
Bank 7/8 per Rt
#2
CHARLES W. & ELNA SILLOWAY
STA. 89+00-91+02
0.48 ACRE ±
COND. 3/16/56
RECORDED: BRADFORD-BK34-PG 150/156-159/160-3/23/56
BM #4
S.I.R. 24" Maple
El 467.90'
#3
ESTATE OF MILDRED ROBERTSON
STA. 89+00-92+00
0.83 ACRE ±
COND. 3/16/56
RECORDED: BRADFORD-BK34-PG 150/156-159/160 3/23/56
#4 B
CLIFFORD H. & ANN KING
STA. 91+02-92+00
0.35 ACRE ±
COND. 3/16/56
RECORDED: BRADFORD-BK34-PG 150/156-159/160-3/23/56
#4 A
CLIFFORD H. & ANN KING
STA. 92+00-95+10
1.28 ACRES ±
COND. 3/16/56
RECORDED: BRADFORD-BK34-PG 150/156-159/160-3/23/56
95+00 15"x2' S.Box (plugged)
Removed
SEE SHEET #10
ROAD RELINQUISHMENT
Ledge
Brush
STONE FILL
92+64-93+50
POST 90+28.9
Sta 81+95
Begin Project F 112(6)
Present Road Profile
Cut to Fill Transition
Underdrain Gradient
81+95-85+00
32" Base
85+00-86+00
20" Base
86+00-88+00
14" Base
88+00-94+00
20" Base
94+00-95+00
14" Base
BM #4 S.I.R. 24" Maple, 40' Rt., Sta. 86+48, El. 467.90
416.4 Approx. High Water Elev. 1936
410.4 Approx. High Water Elev. 1927
BRADFORD - NEWBURY
PROJ. F NO. 112(6)
Sheet 8 of 125

2