PARCEL	INSTRUMENT	DATE	GRANTOR	GRANTEE	RECORDED NEWBURY BOOK	PAGE	DATE	REMARKS
A, B	COND	1-30-42	JOHN & EMILY SMITH	ST OF VT	HIGHWAY	279	1-31-42	
A'	COND	1-30-42	BELLE B CLINE ESTATE	ST OF VT	HIGHWAY	279	1-31-42	

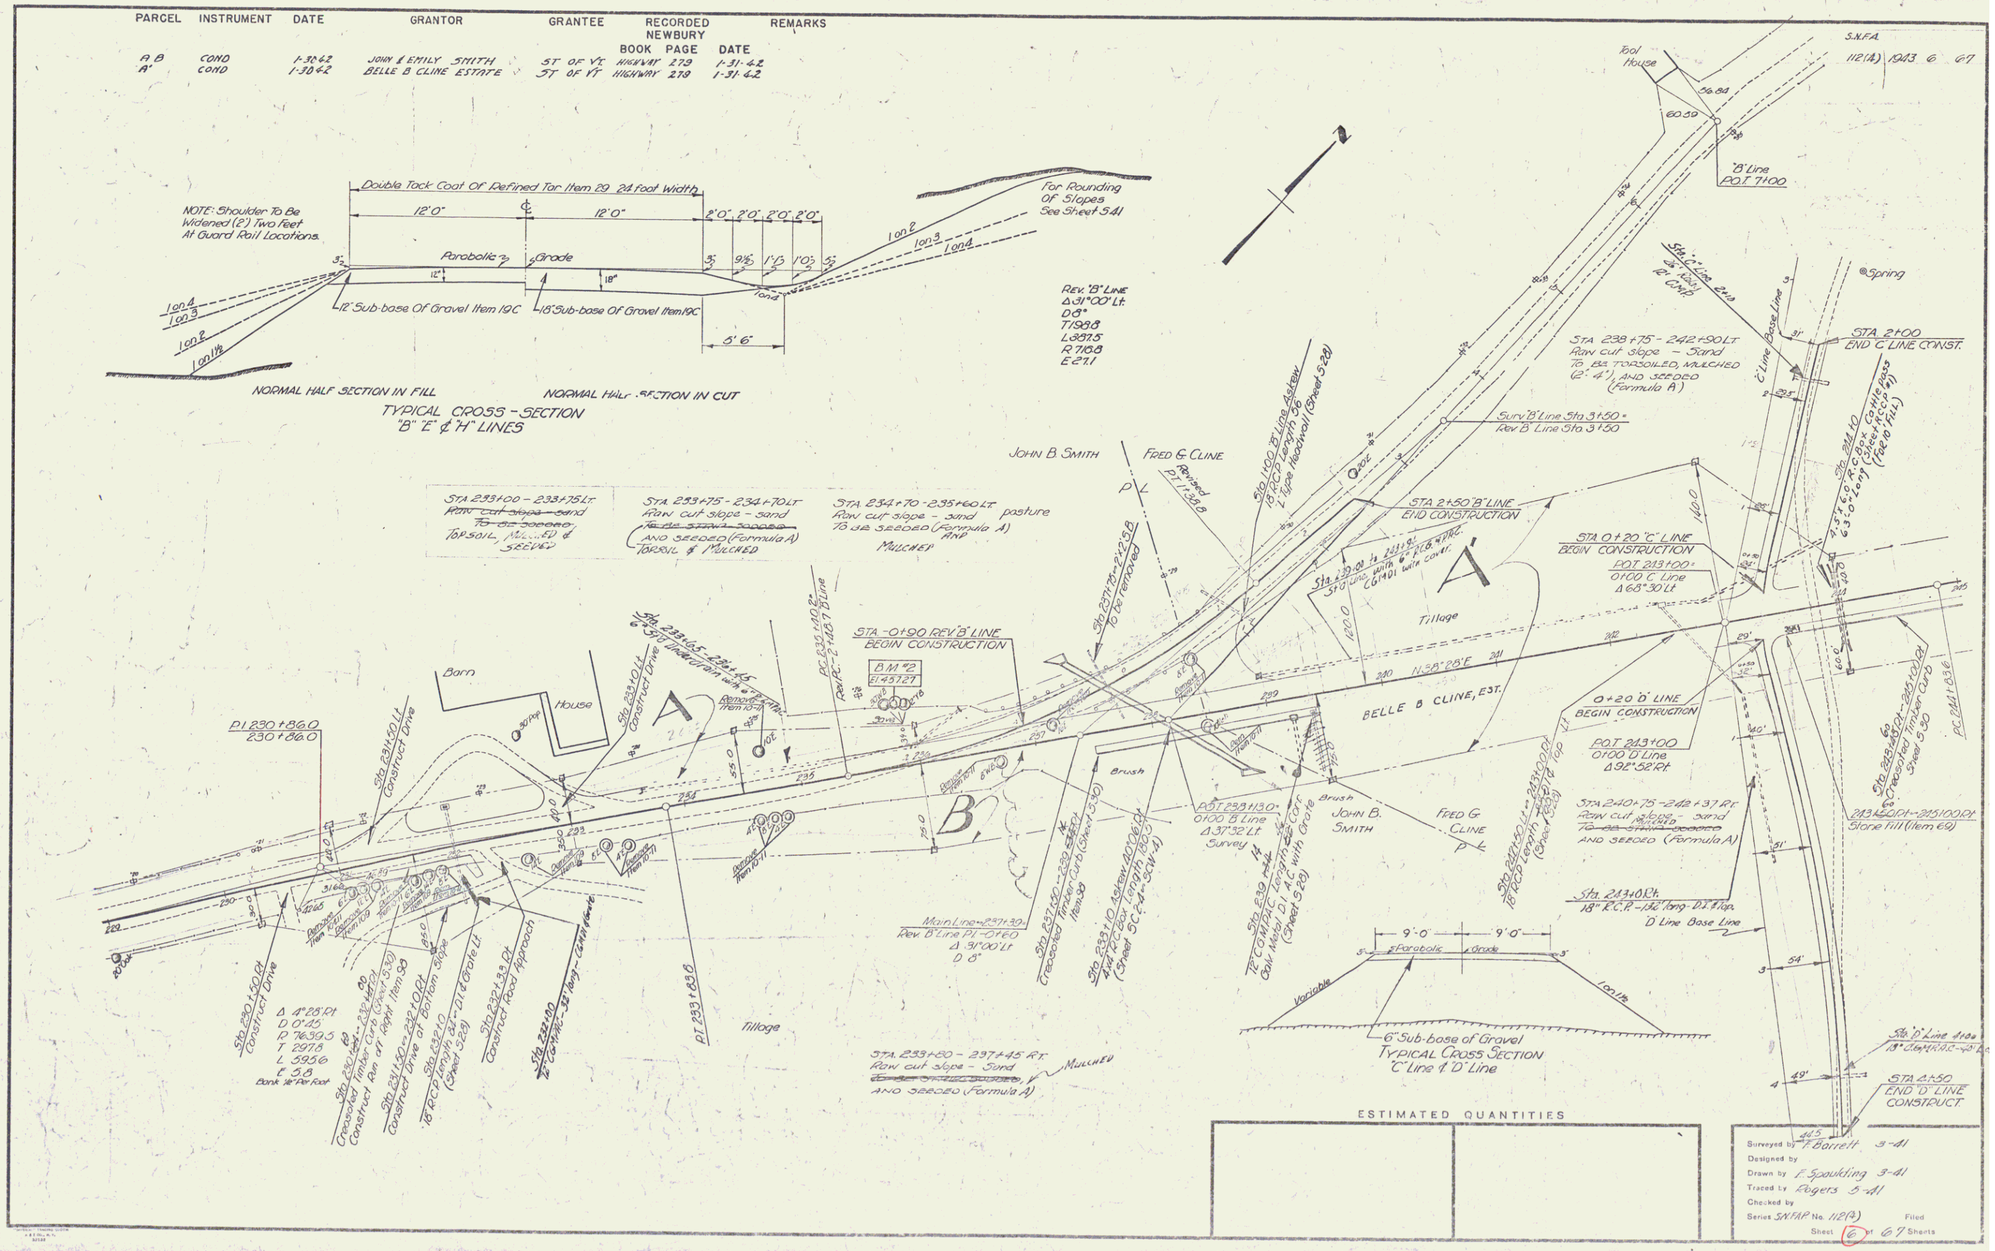

6