


FILE NO.	STATE	FA6H	SHEET TOTAL
112	MA	112	29

Traced R. Bailey May 1971

Scale 1" = 100'

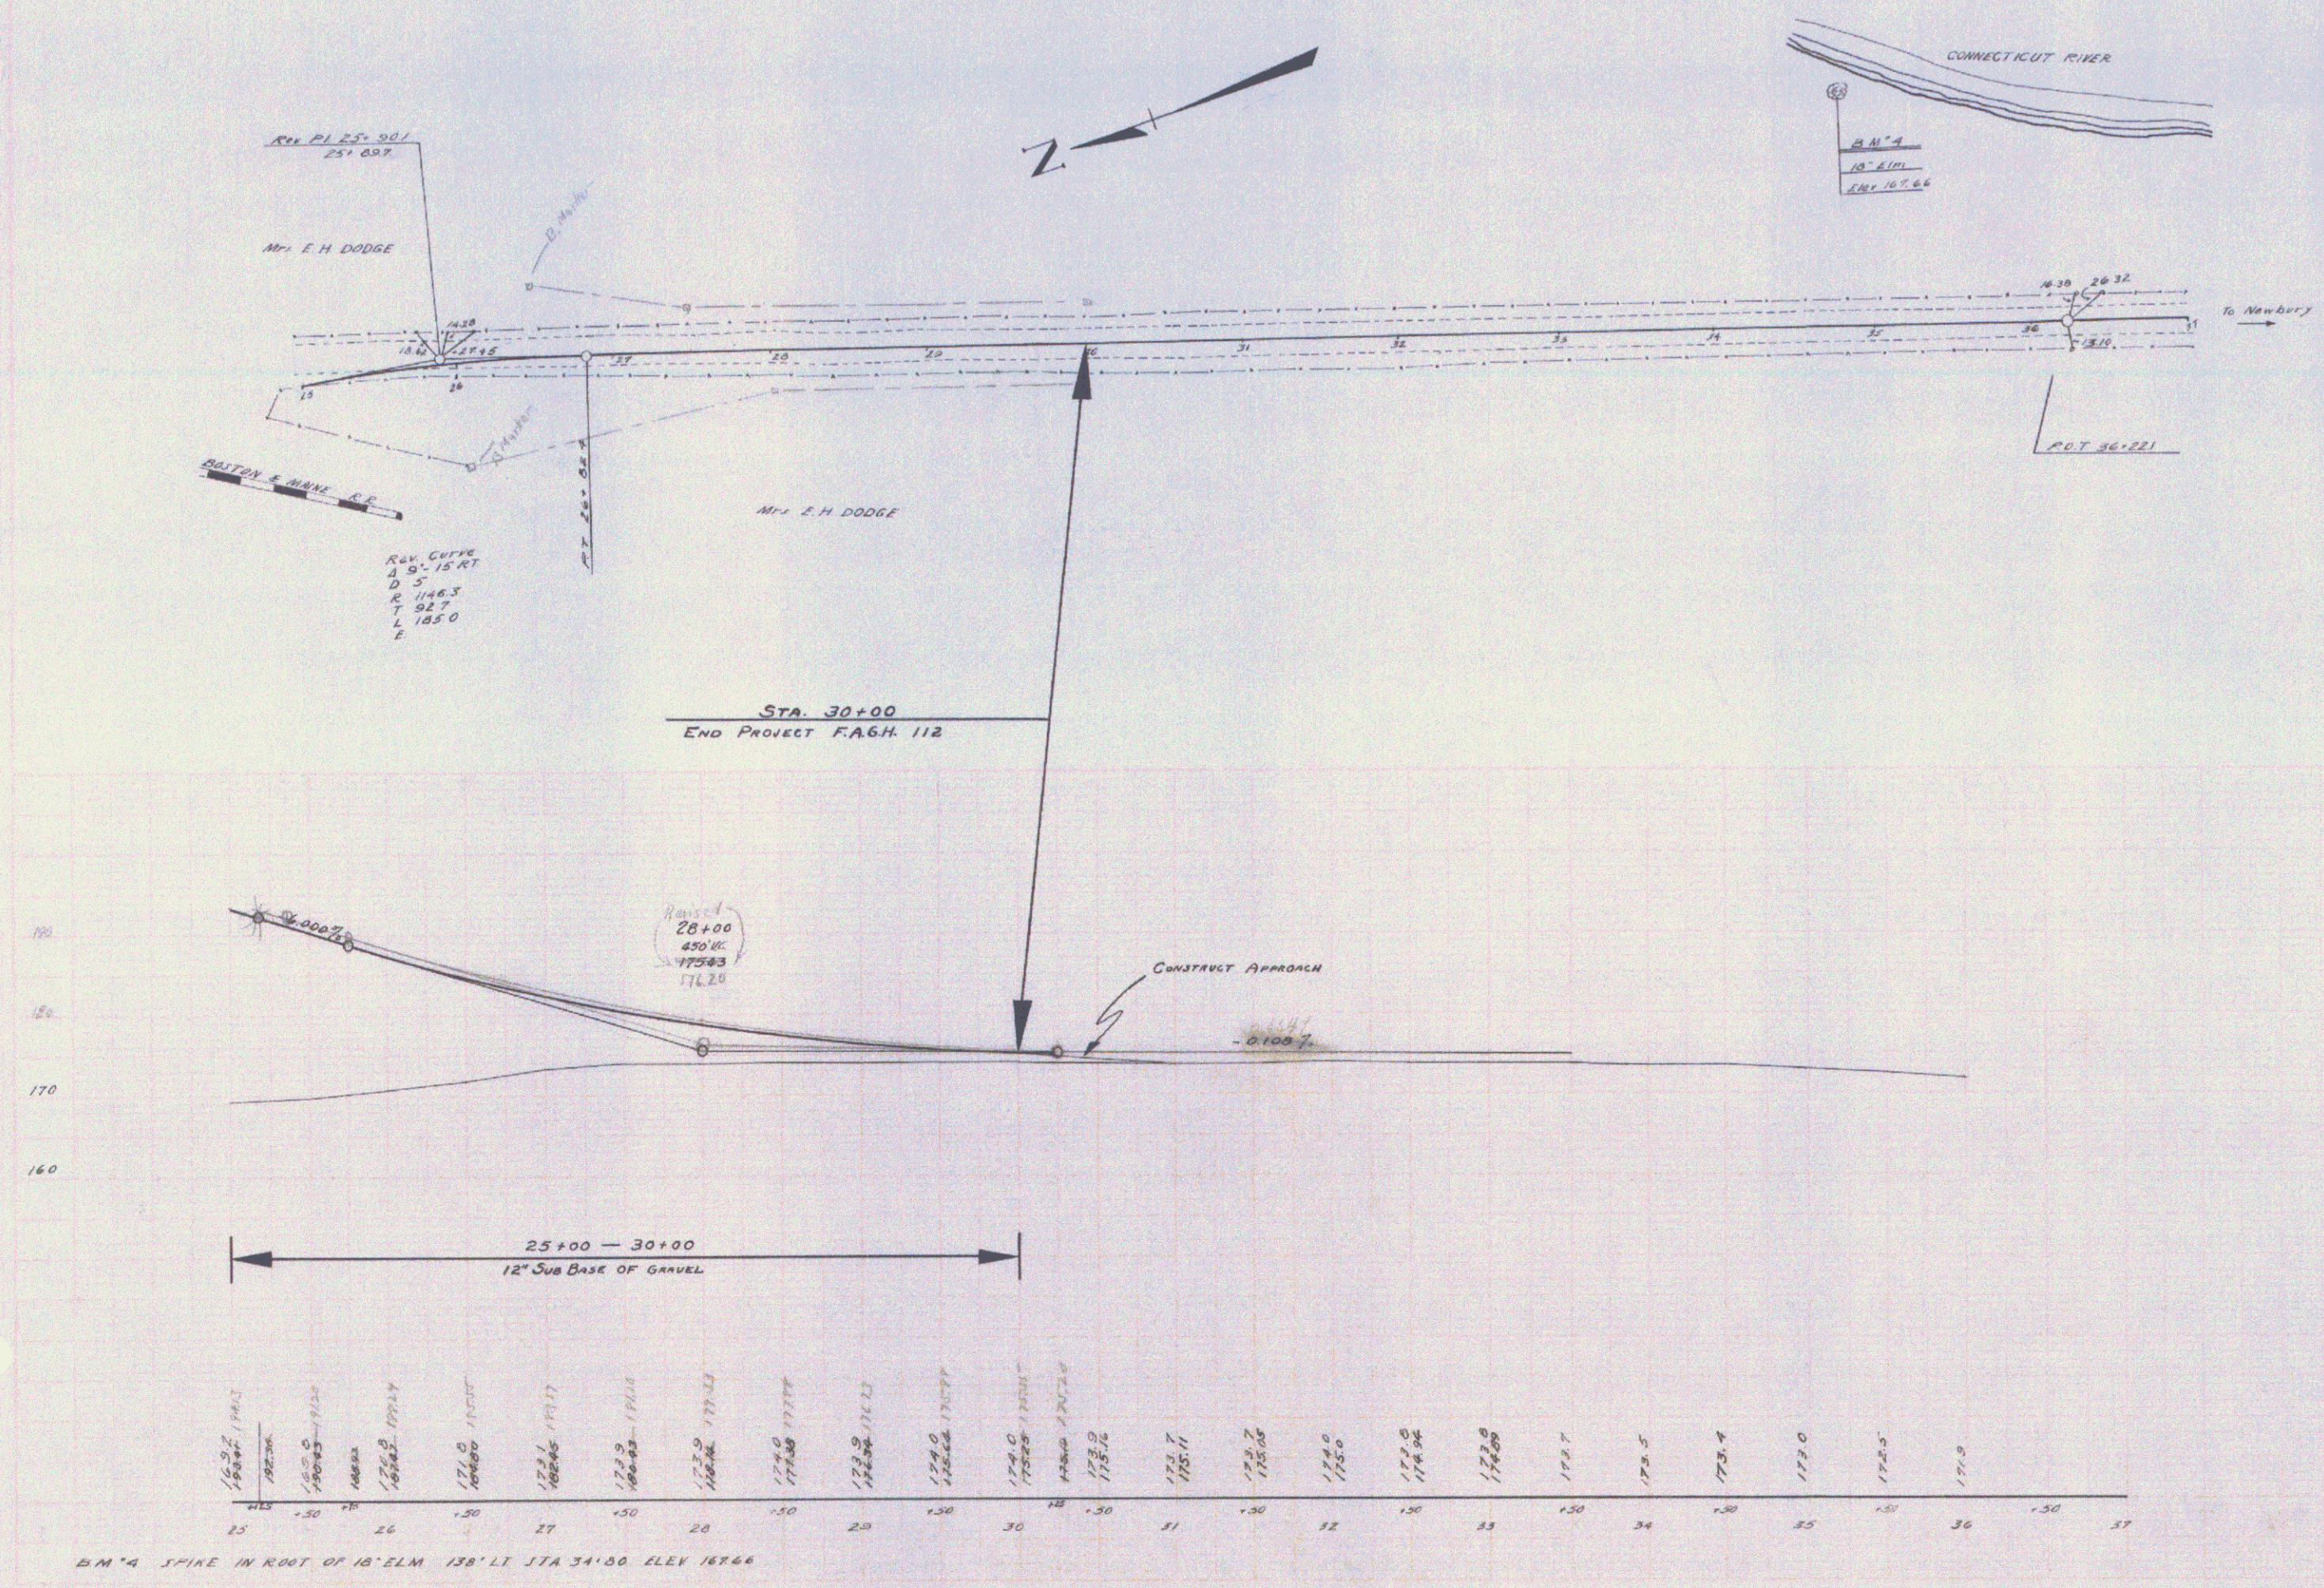

SERIES FA6H NO 112
SHEET 5 OF 29

3