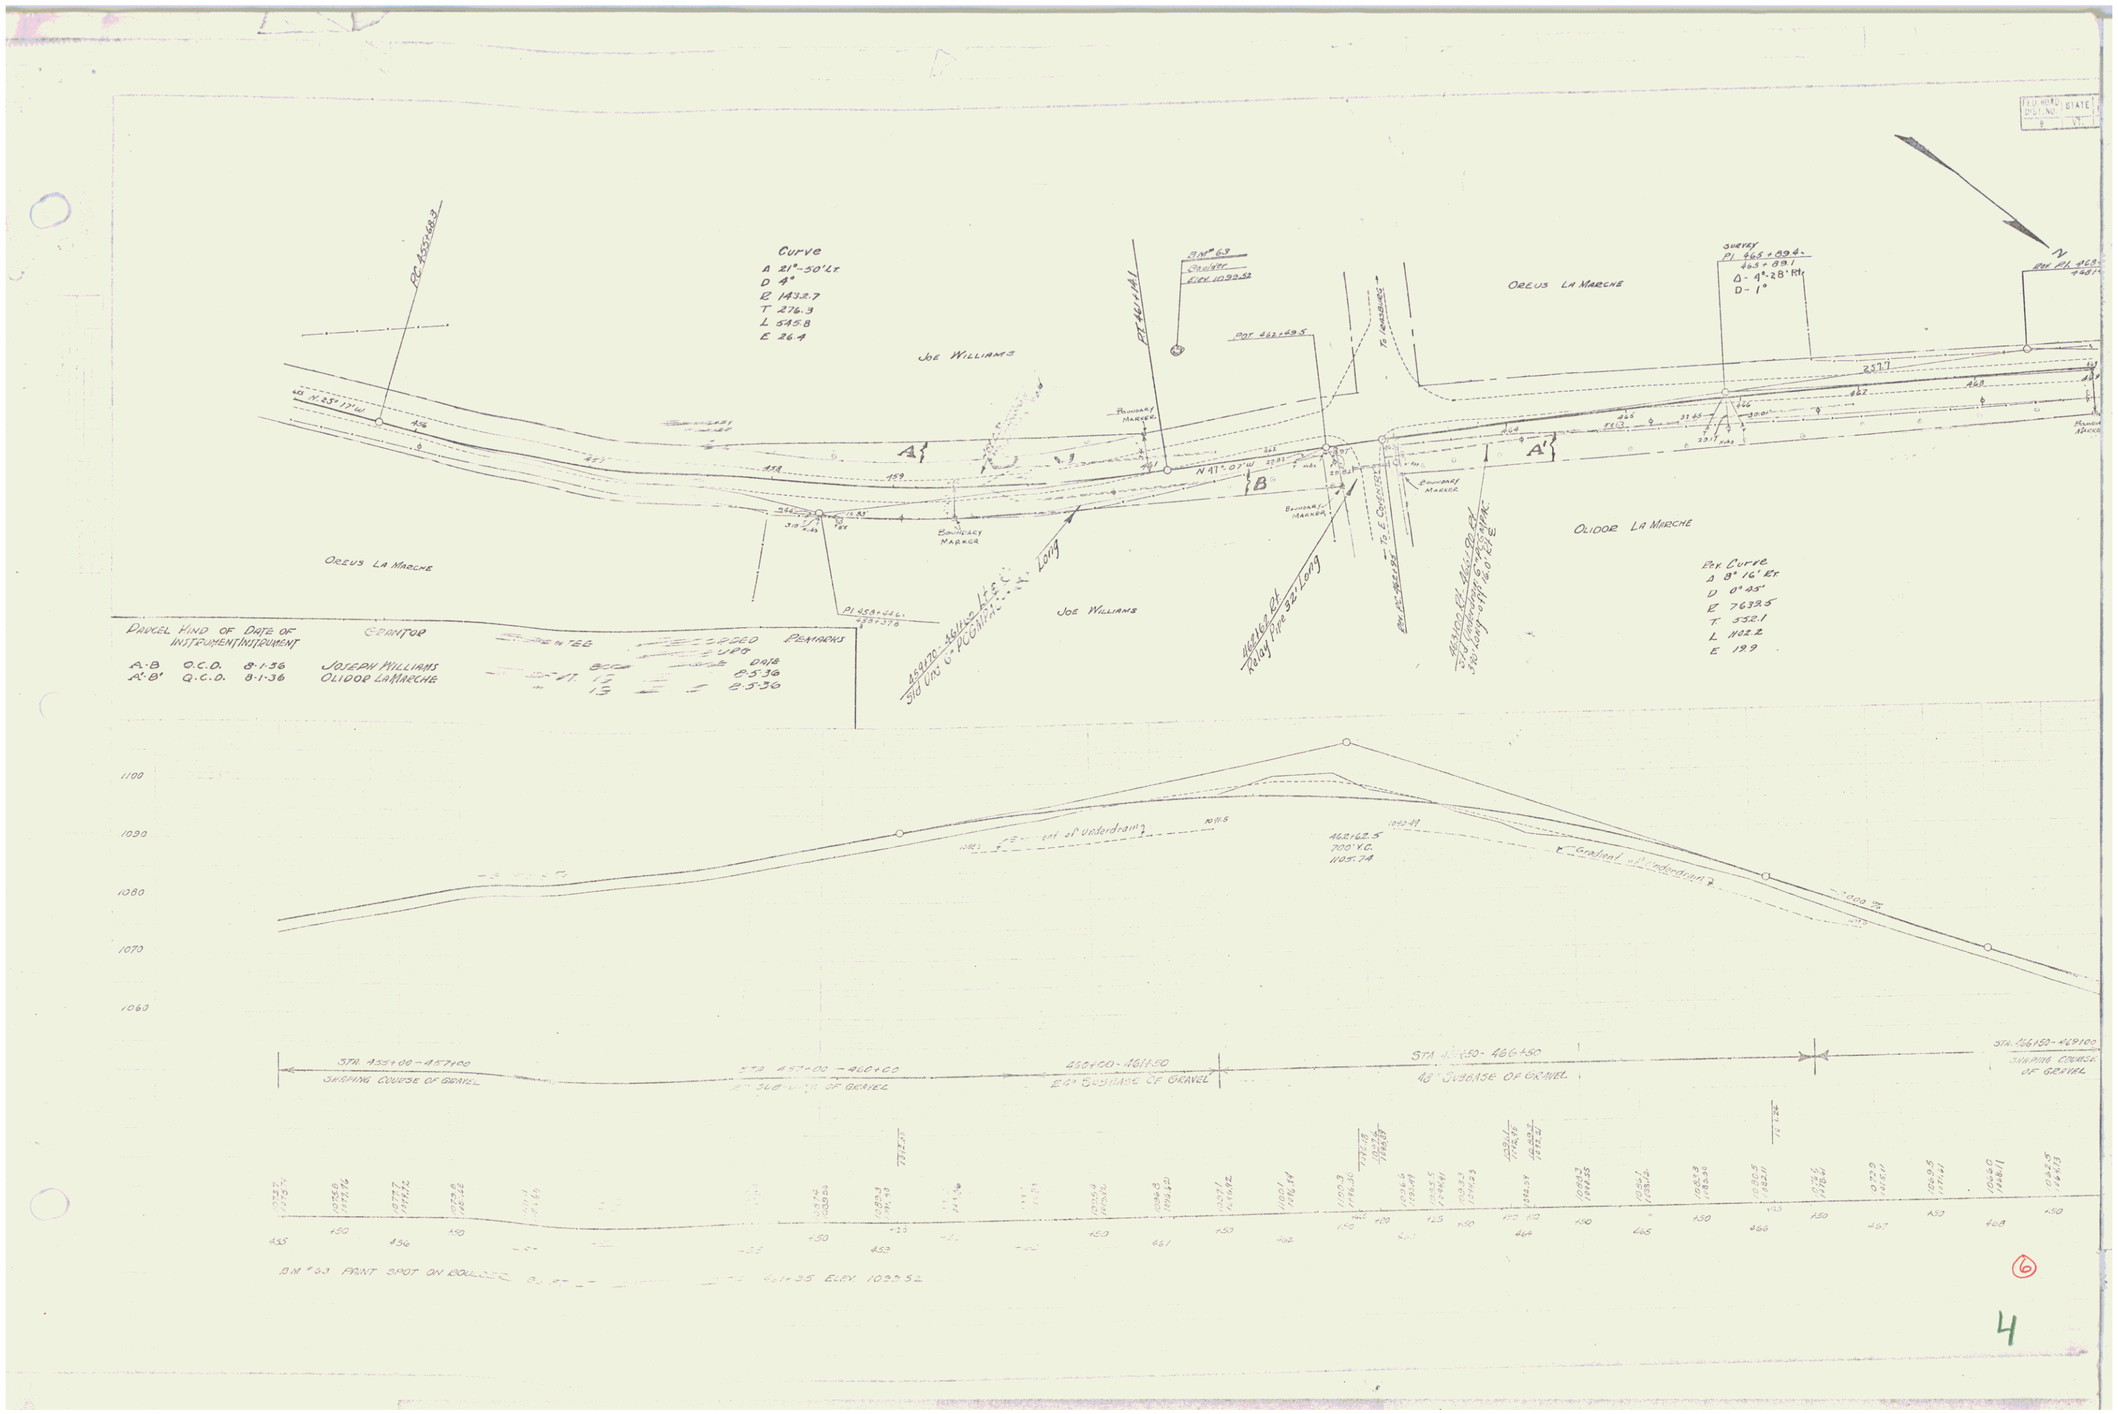
Curve
Δ 21°-50' Lt.
D 4°
R 1432.7
T 276.3
L 545.8
E 26.4
Joe Williams
Orcus La Marche
Oliodor La Marche
Joe Williams
Orcus La Marche
Boundary Marker
Survey
Ex Curve
Δ 8° 16' Rt.
D 0° 45'
R 7632.5
T 552.1
L 1102.2
E 19.9
Parcel Kind of Date of
Instrument Instrument Grantor Grantee Remarks
A-B Q.C.D. 8-1-56 Joseph Williams
A'-B' Q.C.D. 8-1-56 Oliodor La Marche
Date
8-5-56
8-5-56
Gradient of underdrain
462+62.5
700' V.C.
1105.74
Gradient of underdrain
STA. 455+00 - 457+00
SHAPING COURSE OF GRAVEL
460+00 - 461+50
24" SUBBASE OF GRAVEL
48" SUBBASE OF GRAVEL
SHAPING COURSE OF GRAVEL
BM #63 PAINT SPOT ON BOULDER
ELEV. 1093.52

6

4