PROJ. NO. DGI NO.	STATE	FED. AID PROJ. NO.	YEAR	SHEET NO.	TOTAL SHEETS
9	VT.	9	1938	5	40

Cont 3

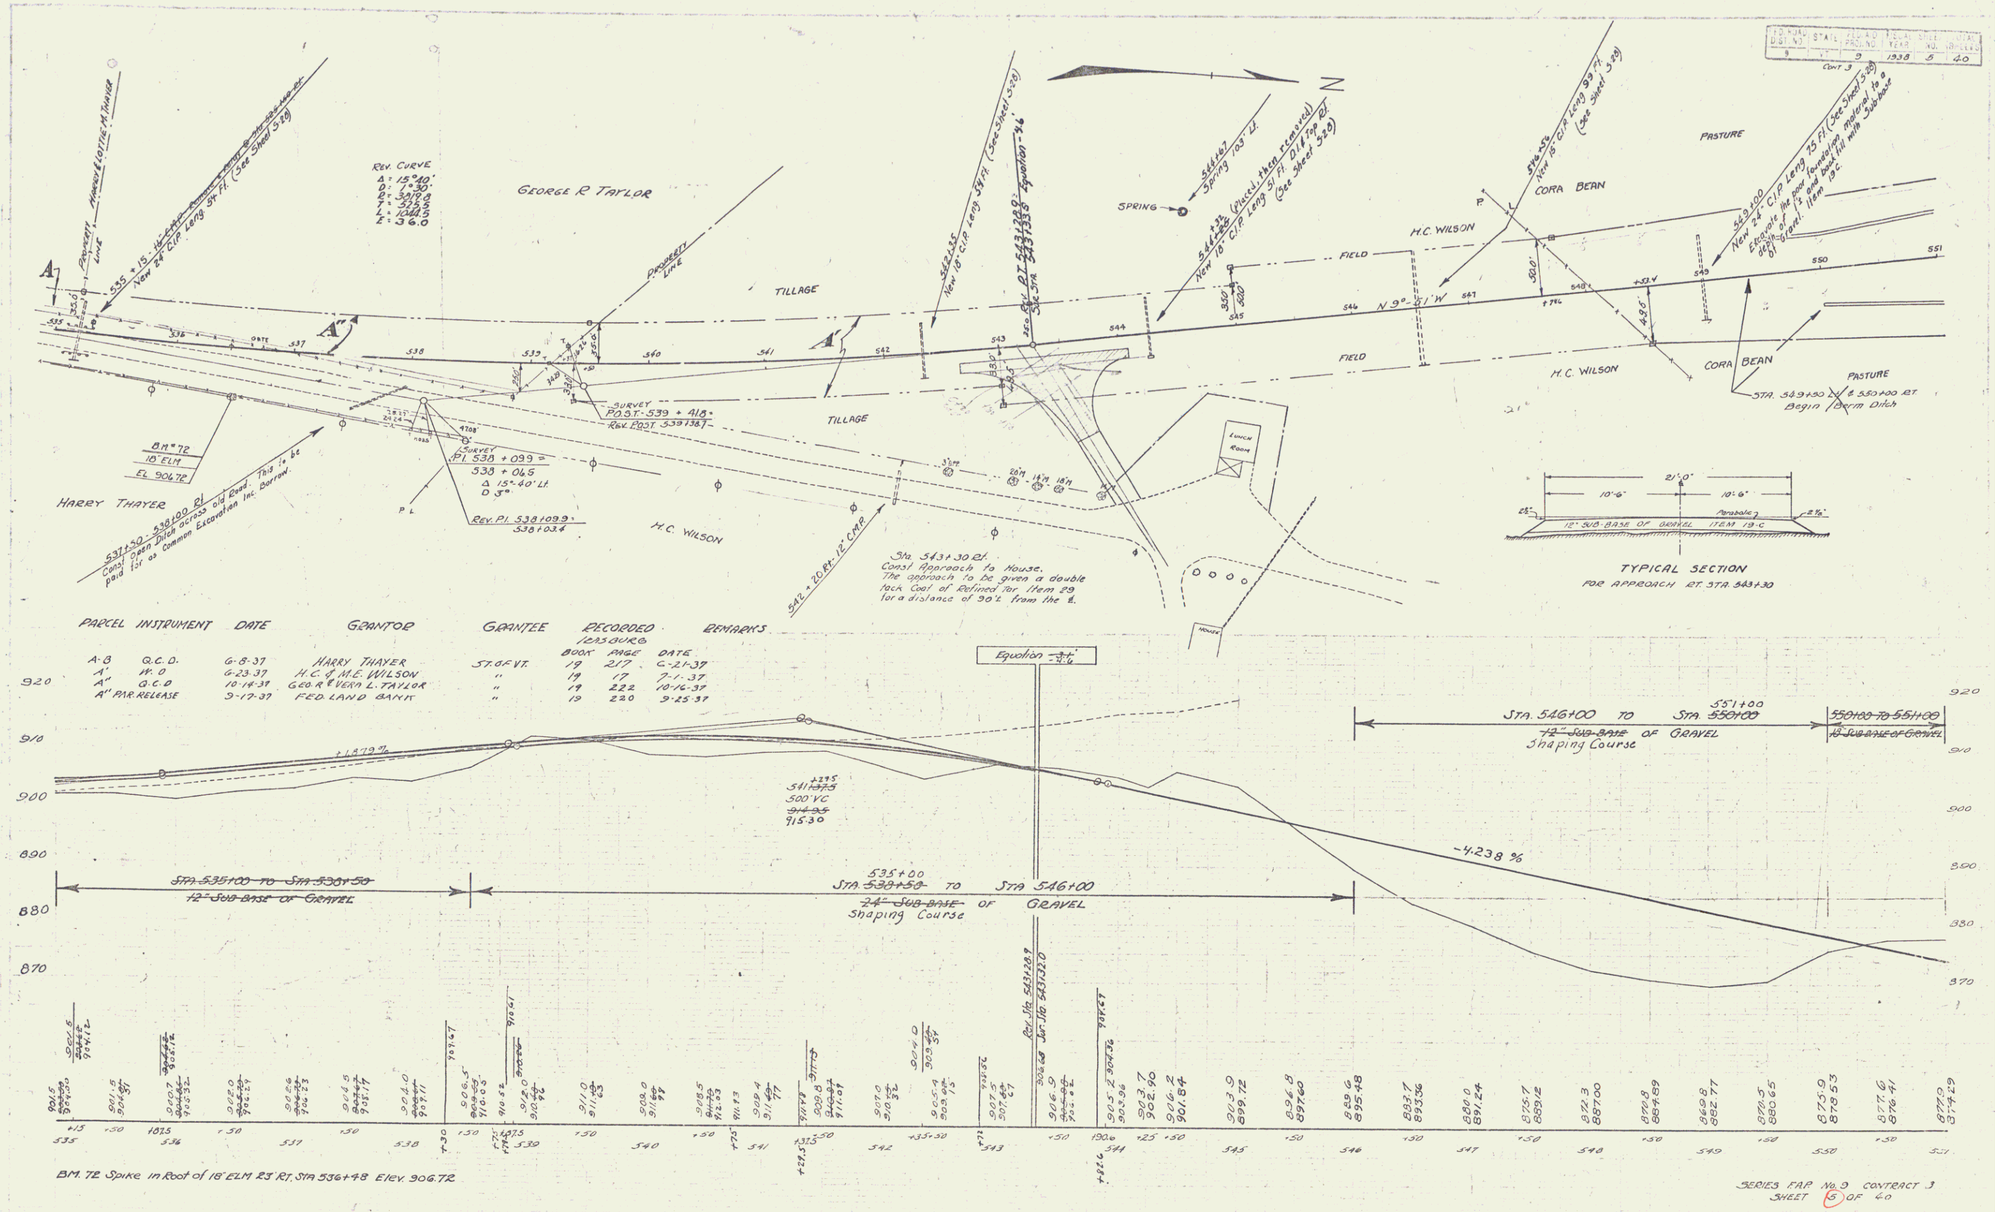

PARCEL	INSTRUMENT	DATE	GRANTOR	GRANTEE	RECORDED LAND OFFICE BOOK	PAGE	DATE	REMARKS
A-B	Q.C.D.	6-8-37	HARRY THAYER	ST. OF VT.	19	217	6-21-37	
A'	W.D	6-23-37	H.C. & M.E. WILSON	"	19	17	7-1-37	
A''	Q.C.D	10-14-37	GEO. R. & VERA L. TAYLOR	"	19	222	10-16-37	
A''	PAR. RELEASE	9-17-37	FED. LAND BANK	"	19	220	9-25-37	

SERIES F.A.P. No. 9 CONTRACT 3
SHEET 5 OF 40

3