FED. AID PROJ. NO.			
9	1938	6	40

CONT. 3

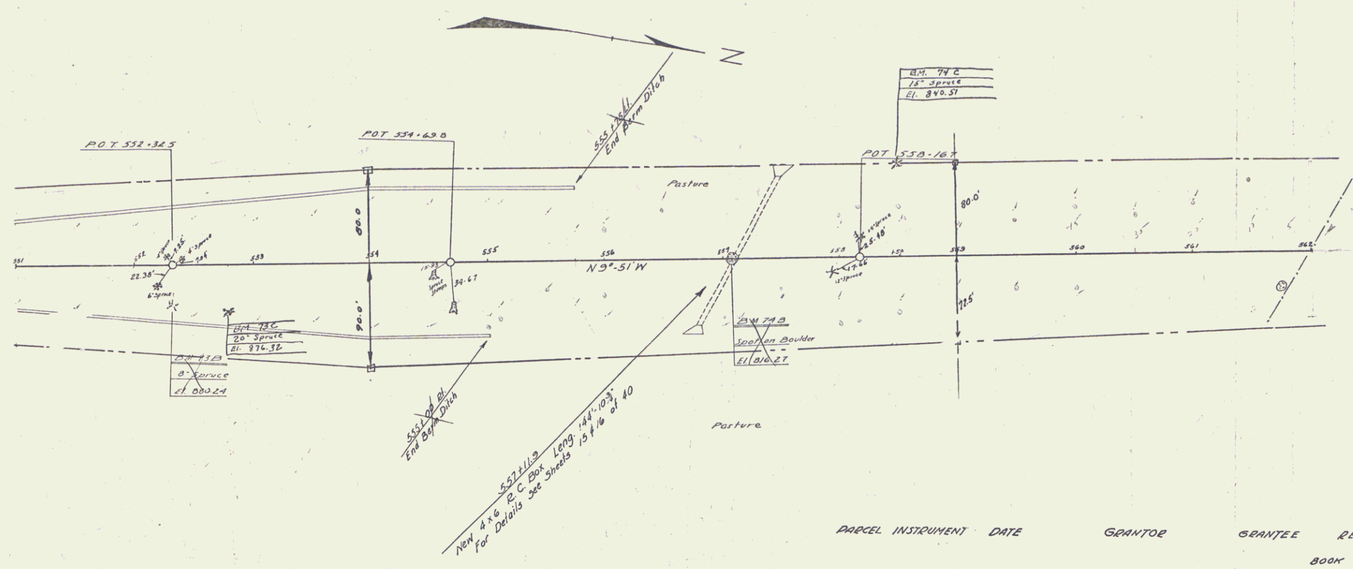

PARCEL	INSTRUMENT	DATE	GRANTOR	GRANTEE	RECORDED BOOK	RECORDED PAGE	RECORDED DATE	REMARKS

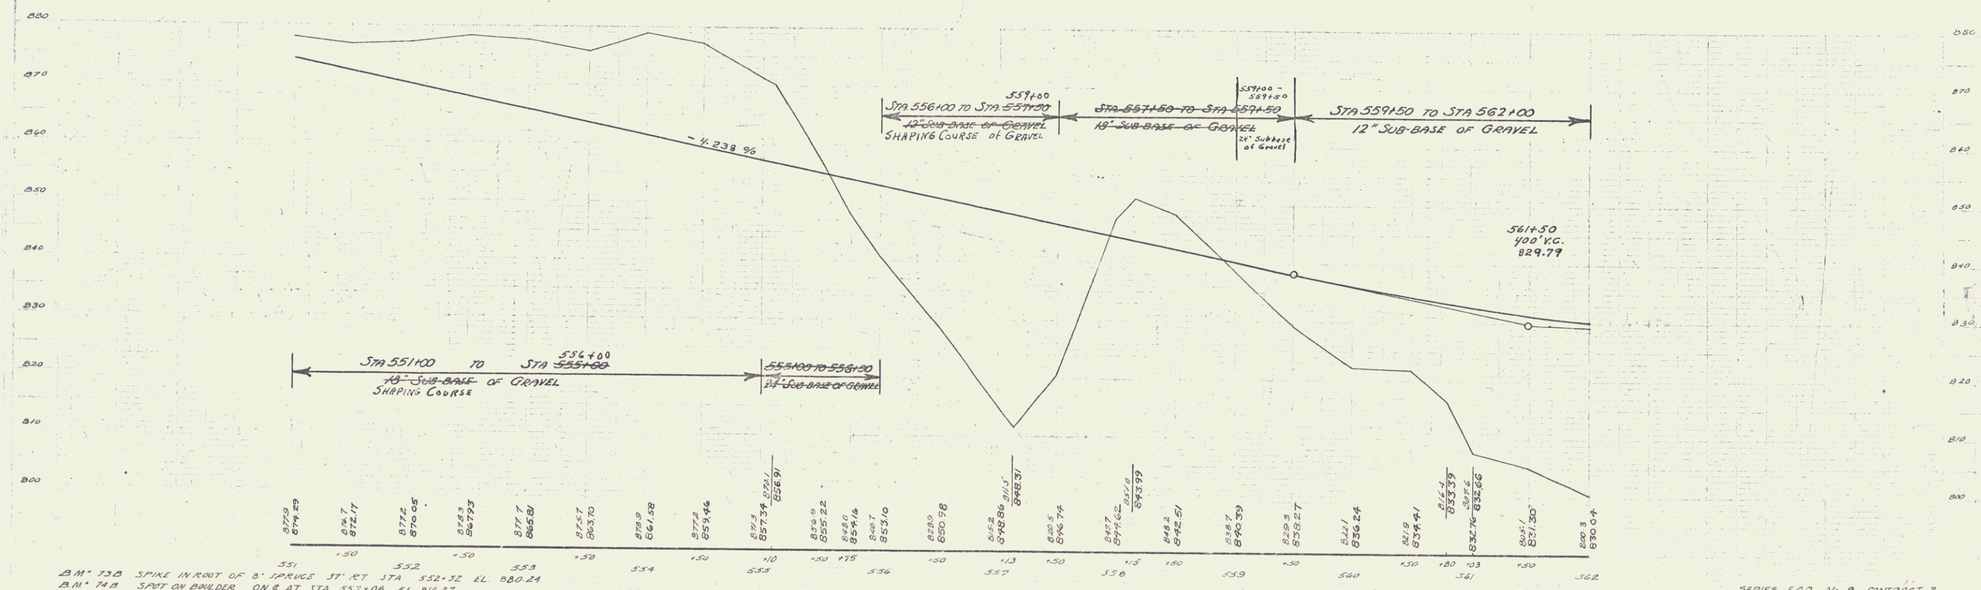

SERIES F.A.P. No. 9 CONTRACT 3
SHEET 6 OF 40

4