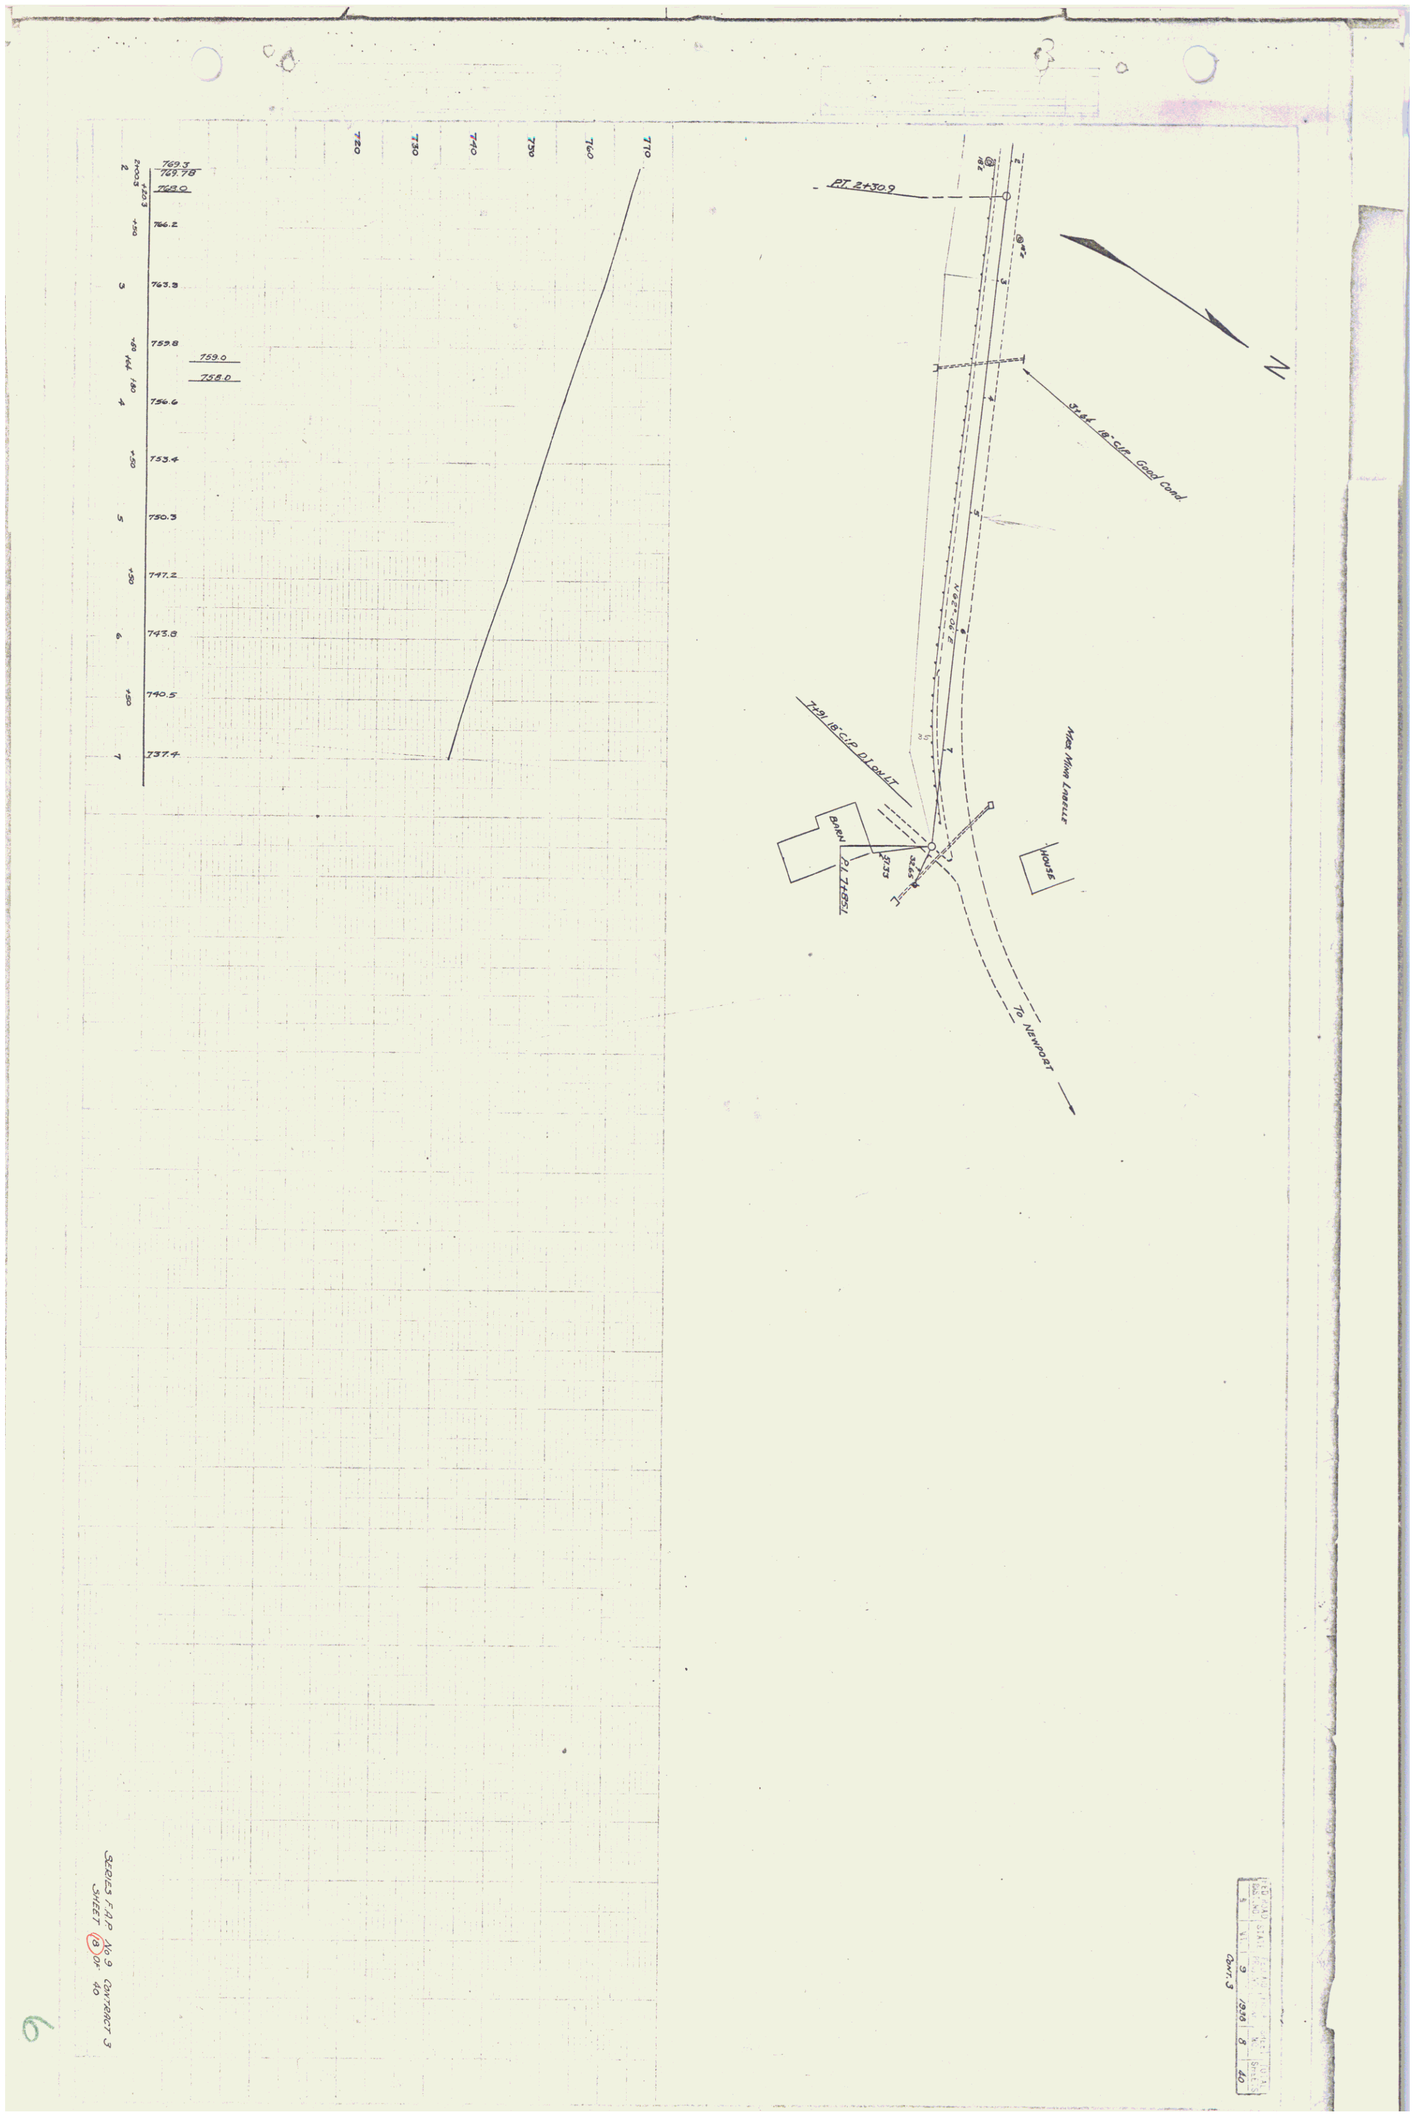
PI 2+30.9
N
Stat. 18" CIP Cond Cond
Z 80-28 N
7+91 18" CIP Out Lt
Mrs Mina Lisella
HOUSE
BARN
To Newport
Cont. 3
SERIES F.A.P. No. 9 CONTRACT 3
SHEET 8 OF 40
6