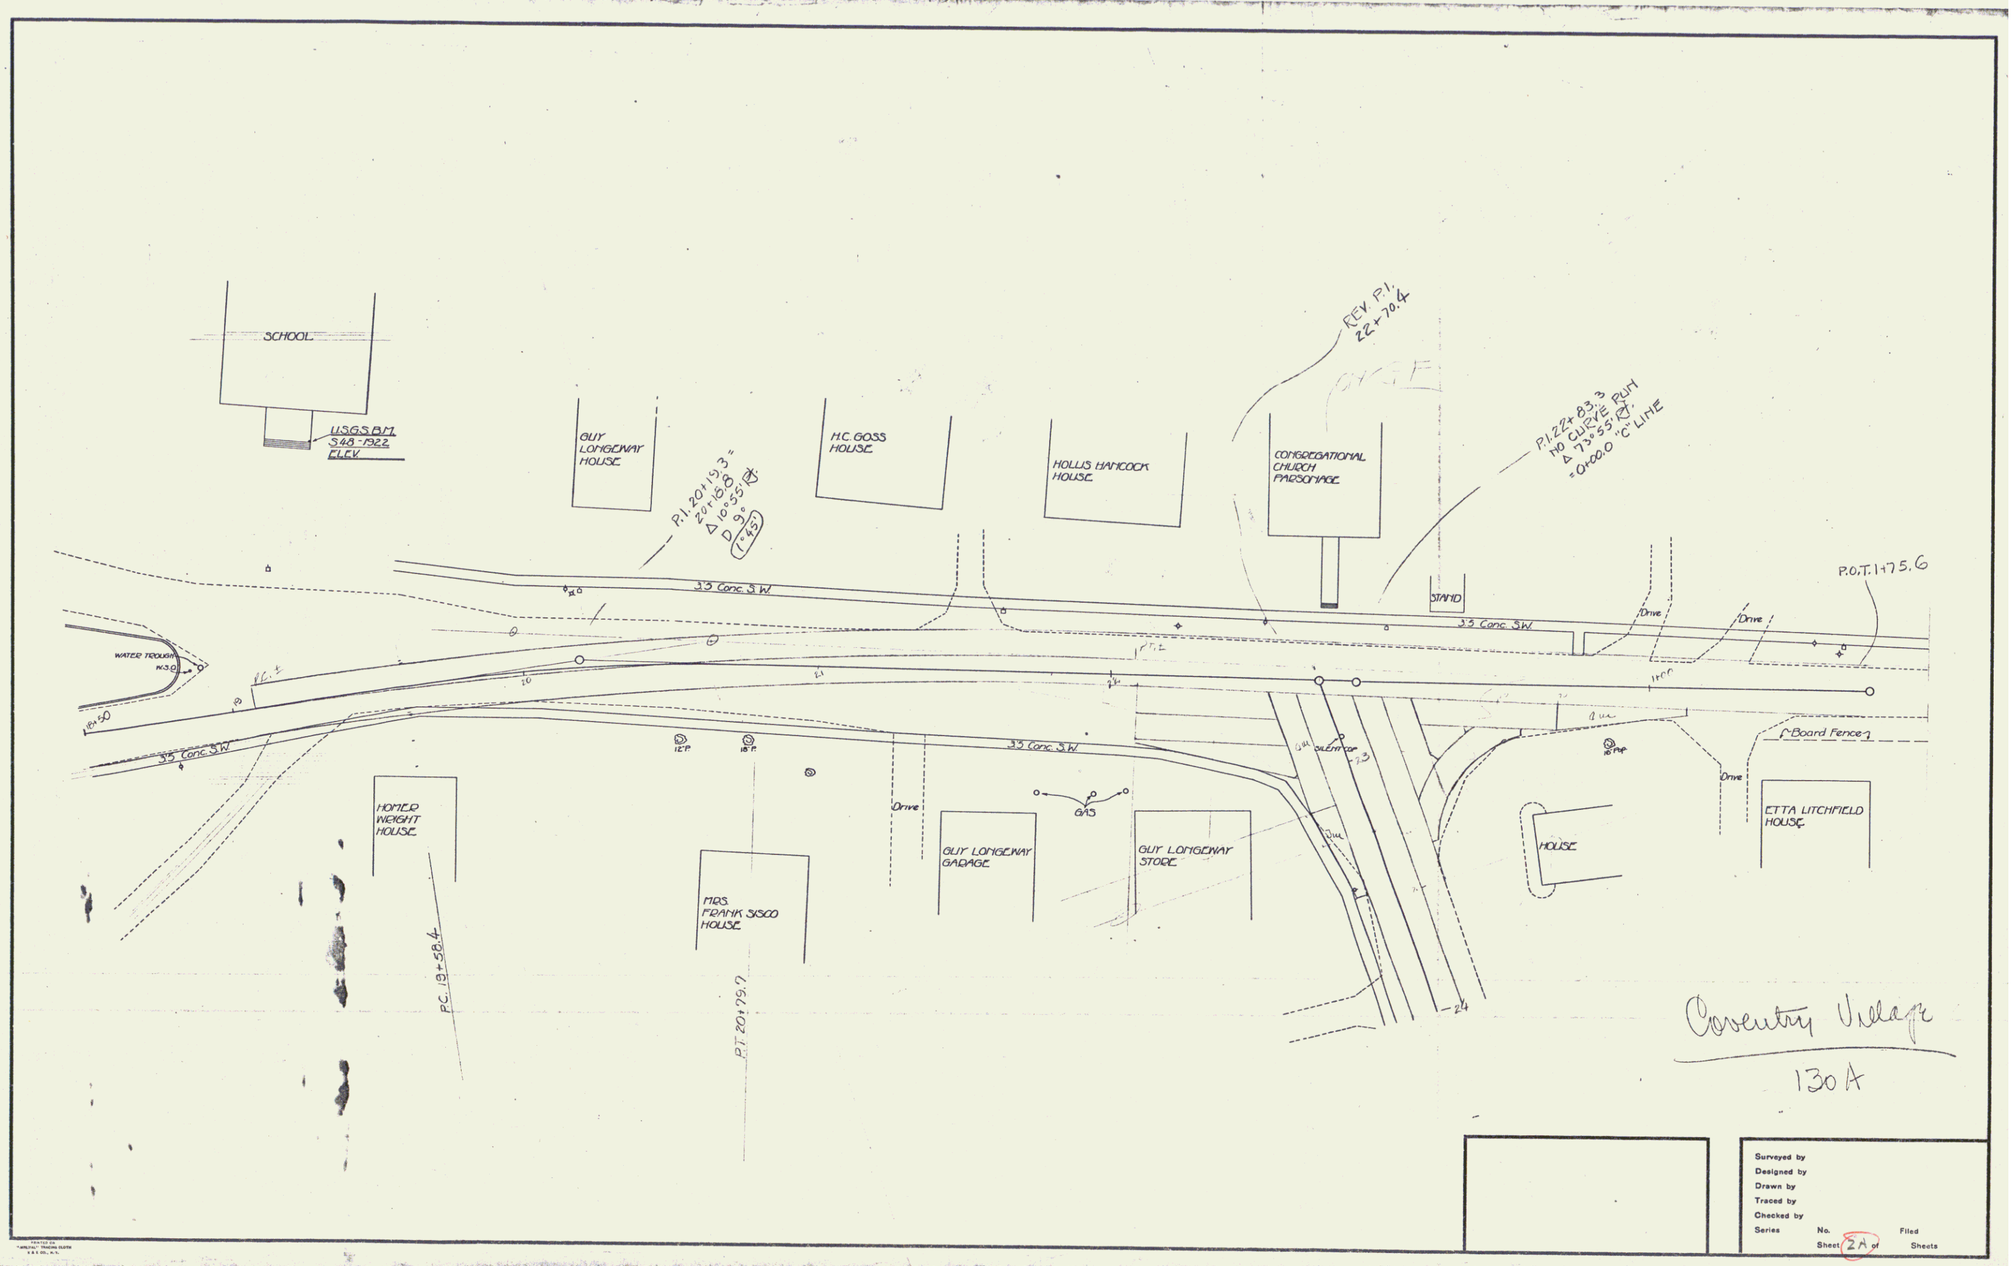
SCHOOL
U.S.G.S. B.M.
S43-1922
ELEV.
GUY LONGENAY HOUSE
P.I. 20+19.3 =
20+68.8
Δ 10°55'
D 9°
(1°45')
H.C. GOSS HOUSE
HOLLIS HANCOCK HOUSE
CONGREGATIONAL CHURCH PARSONAGE
REV. P.I.
22+70.4
P.I. 22+83.3
NO CURVE RUN
Δ 7°55' Rt.
=01+00.0 "C" LINE
P.O.T. 1+75.6
STAND
Drive
WATER TROUGH
N30°E
3.5 Conc. S.W.
Board Fence
HOMER WRIGHT HOUSE
P.C. 19+58.4
MRS. FRANK SISCO HOUSE
P.T. 20+79.7
GUY LONGENAY GARAGE
GAS
GUY LONGENAY STORE
HOUSE
ETTA LITCHFIELD HOUSE
Coventry Village
130 A
Surveyed by
Designed by
Drawn by
Traced by
Checked by
Series No.
Sheet 2A of Sheets
Filed

2