FED. AID DIST. NO.	STATE	FEDERAL AID PROJECT NO.	SHEET NO.	TOTAL SHEETS
9		130-A 1931	5	74

GUIDE POSTS OF WOOD REQUIRED

STATION	LEFT	RIGHT
13+38	—	2
14+00	X	X
16+90	X	—2
18+85	X	—
19+00	X	—
21+35	X	—

Wood Guard Rail
18+62 16'

NEW CAST IRON PIPE CULVERTS REQUIRED

STATION	DIAM	LENG	CONC. R	CONC. C	REINF. STEEL	GRATES
(3+36 (r outlet)	12"	39'	1.6		39	
13+38 Rt - 14+00 Rt	12"	87 lns	0.9 c.y.	—	93.39 lbs.	1
14+00	12"	27'	2.2.5 c.y.	—	21.95 lbs.	2
~~16+80 Lt - 16+85 Lt~~	~~12"~~	~~33'~~	~~1.4 c.y.~~	—	~~33 lbs.~~	+
18+85 Lt. - 17+35 Lt.	12"	1.95'	1.4 c.y.	—	33 lbs.	X
19+00 Lt - 18+85 Lt.	12"	3.6'	1.4 c.y.	—	87.39 lbs	1
21+35 Lt. - 0+40 Lt (Rtwa)	12"	16.95'	1.6 c.y.	—	33 lbs.	+
16+80 Lt - 16+65 Rt	12"	25.29'	(AND FOR OUTLET)			
17+35 Lt - 16+85 Lt.	12"	4.87'	—	—		1
21+00 Rt - 21+35 Lt	12"	39'				1
10+61	15"	36'	0.9	1.6		

CATCH BASINS REQUIRED

CULV. STATION	LEFT	RIGHT
16+65	1	1
17+35	1	—
18+85	1	

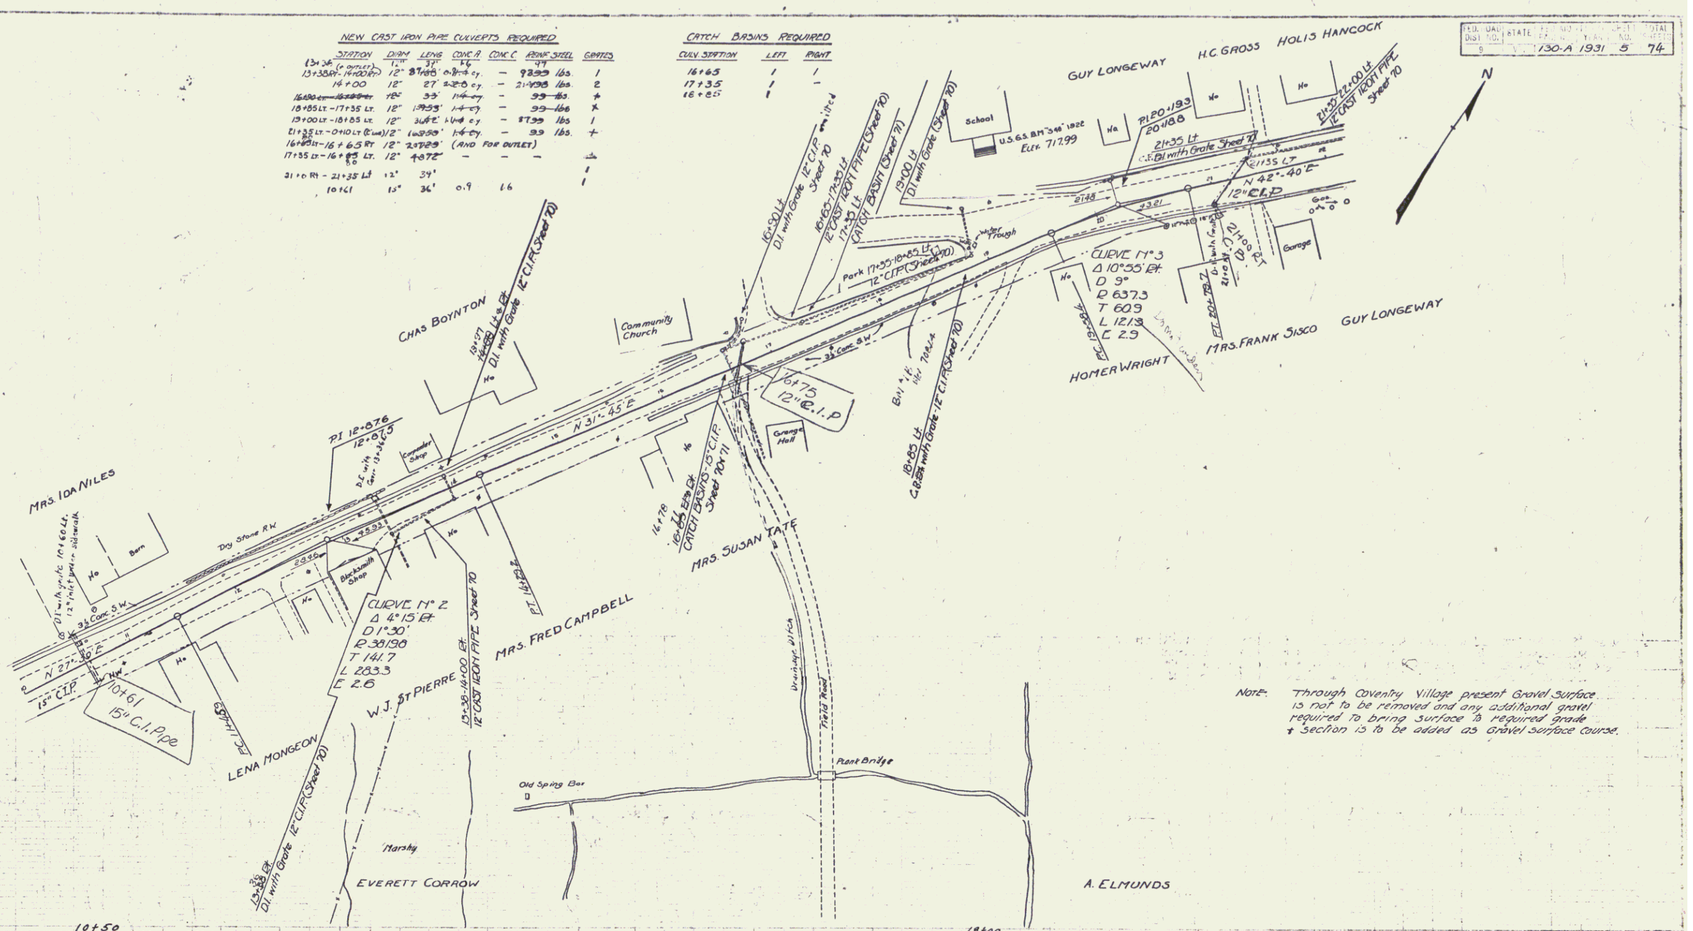

Note: Through Coventry Village present Gravel Surface is not to be removed and any additional gravel required to bring surface to required grade + section is to be added as Gravel Surface Course.

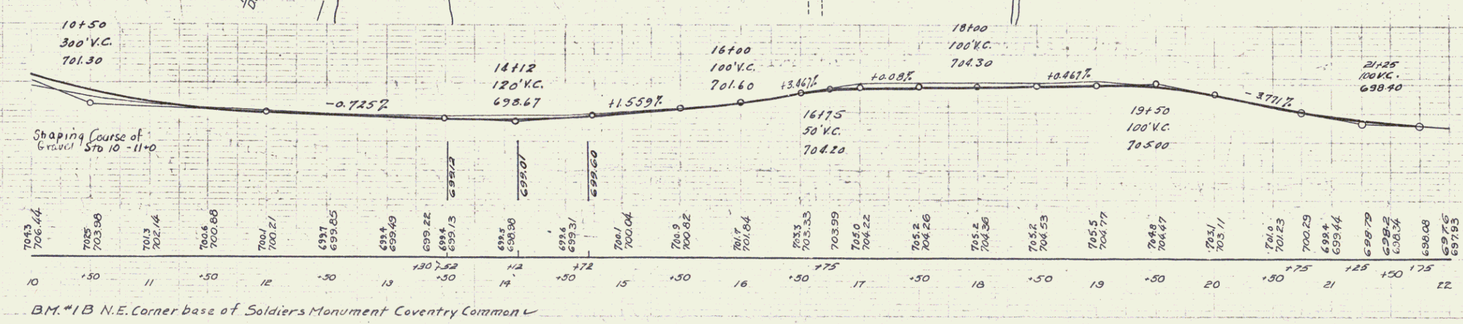

BM. #1B N.E. Corner base of Soldiers Monument Coventry Common

SERIES F NO. 130-A
SHEET NO. 5 OF