FED. ROAD DIST. NO.	STATE	FED. AID PROJ. NO.	YEAR	SHEET NO.	TOTAL SHEETS
9	VT.	130-A	1931	17	74

WOOD GUARD RAIL REQUIRED

CULVERT STATION	LEFT	RIGHT
181+90	24'	24'
185+00	24'	24
187+20	24'	24'
190+50	24'	24'
194+26	24'	24

CABLE GUARD RAIL REQUIRED

STATION	LOC. R	LENG.	CONSTANT	PAY LENGTH
~~181+50 to 181+90~~	~~Rt.~~	~~36'~~	~~40~~	~~156~~

Parcel	Kind of Instrument	Date of Instrument	Grantor	Grantee	Recorded County Book	Page	Date	Remarks
H&C. D&Culv. #1	C.C.D.	6-30-31	Raoul Poulin	Stef W.	17	303	7-25-31	
	"	6-30-31	L.S. Morrill	" "	17	296	7-25-31	Culv. Sta 190+50

NEW CAST IRON PIPE CULVERTS REQUIRED

STATION	DIAM	LENG.	CONC. A.	CONC. C	REINF. STEEL
181+90	15"	48'	–	1/2 cu. yd.	55 lbs
185+00	15"	54'	–	1 cu. yd.	17 lbs
187+20	15"	42/36	–	1/2 cu. yd.	17 lbs.
194+26	15"	48'	–	2/3 cu. yd.	15 lbs.

New Corrugated Metal Culvert
181+00 12" 27' Kubbe 0.8 cy

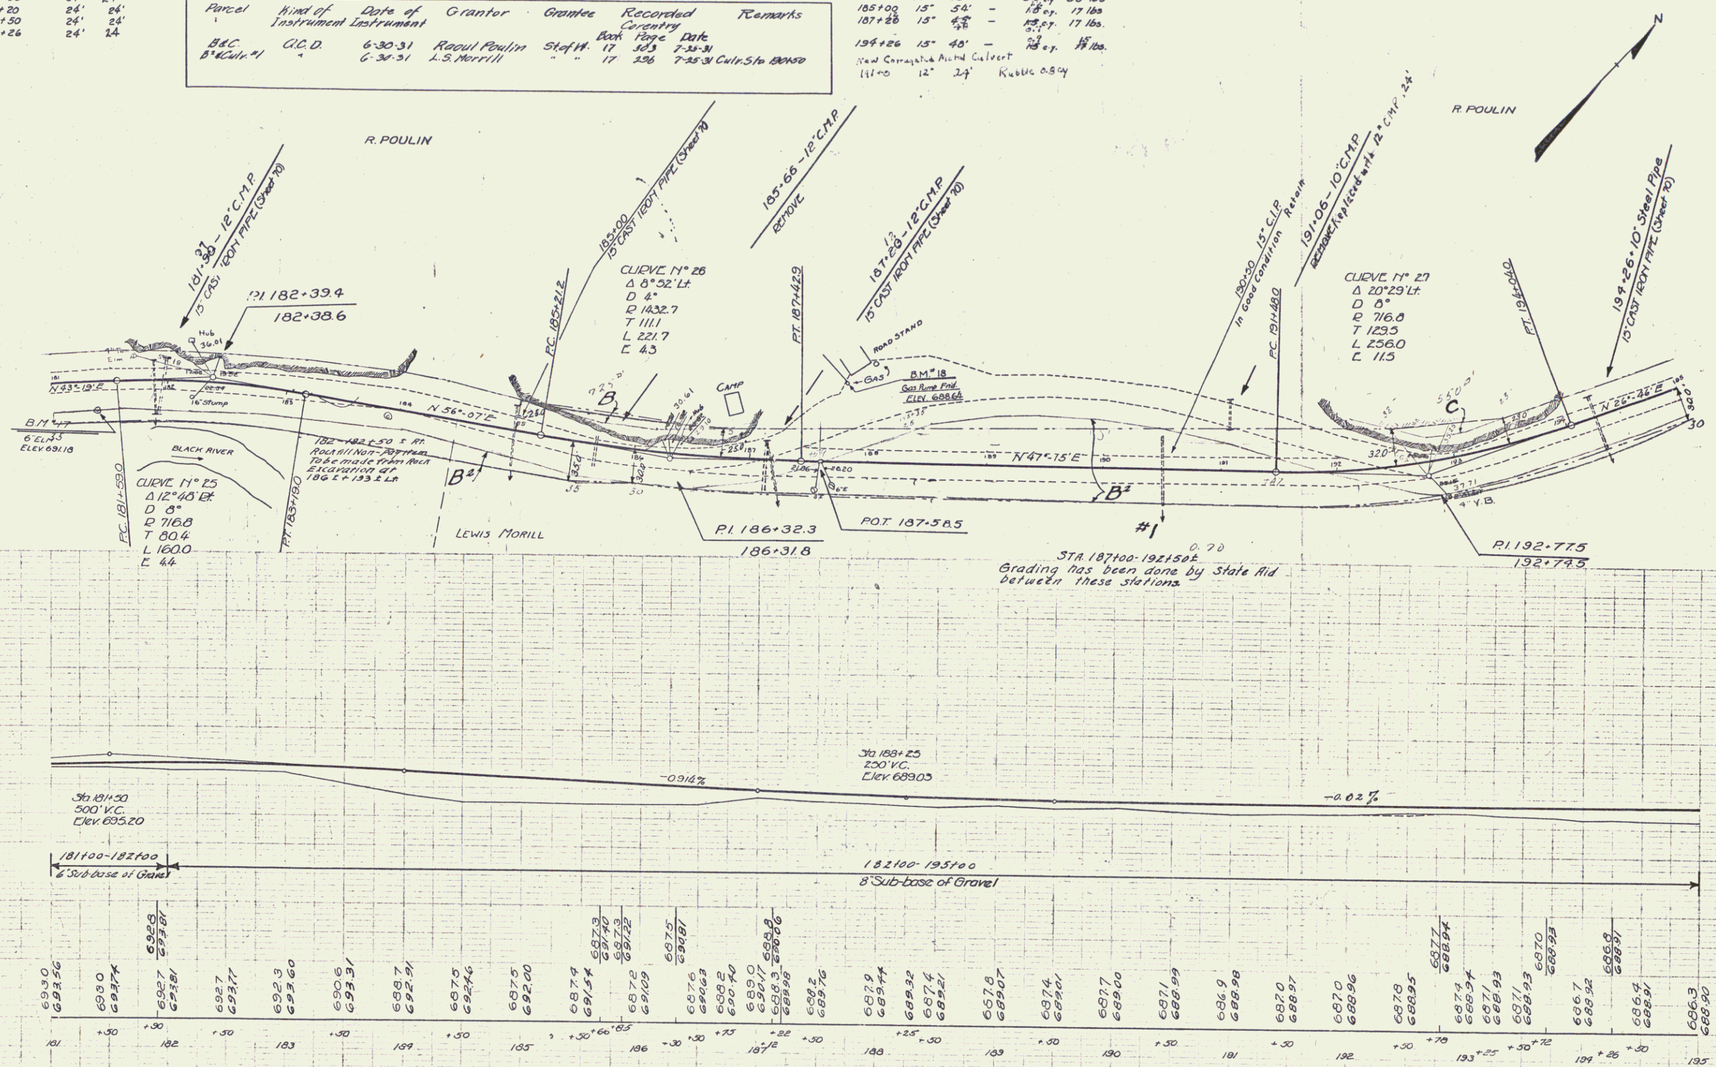

B.M. #18 Gas Pump Foundation 68' Lt. 187+52 Elev. 688.64
B.M. #17 Spike in root 6" Elm 21' Rt 181+40 Elev 691.18

SERIES F-No. 130-A
SHEET 17 OF 74

18