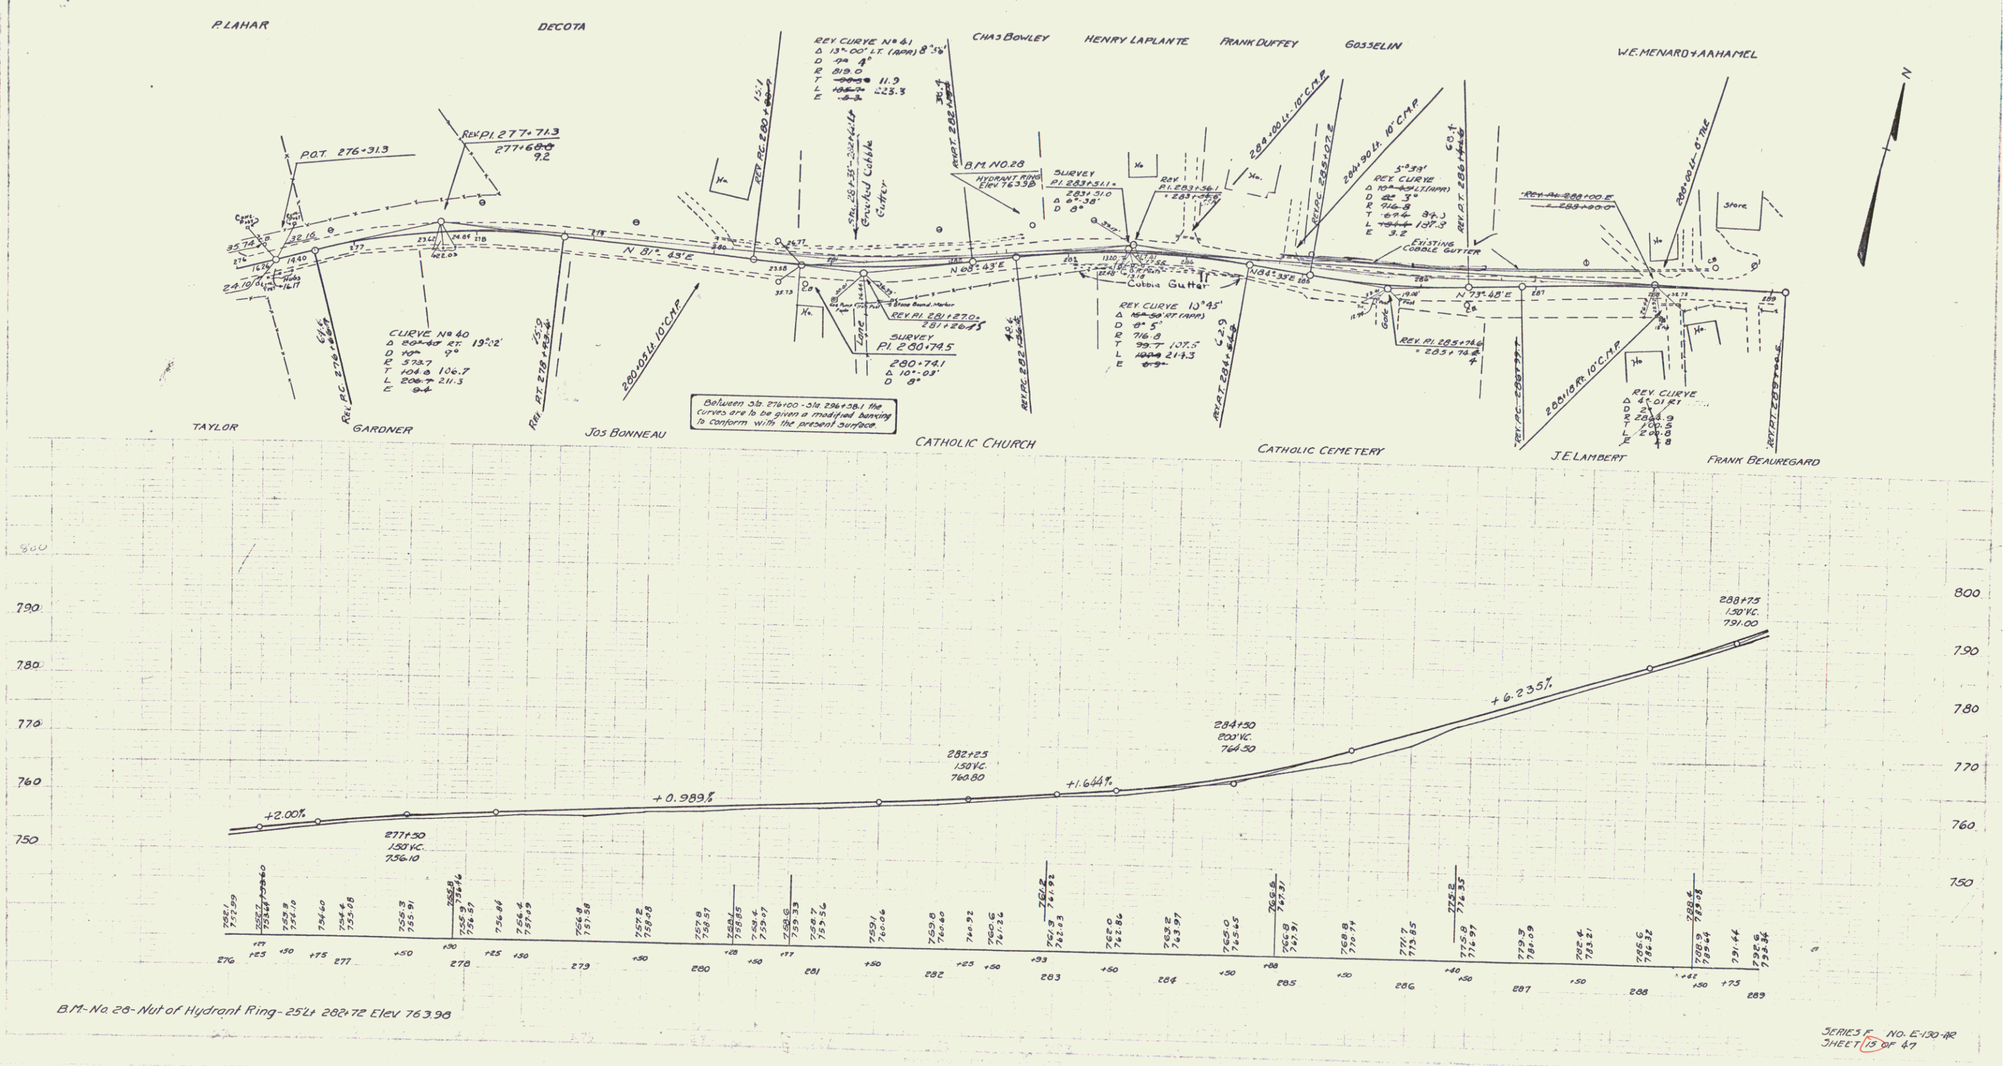
P. LAHAR
DECOTA
CHAS BOWLEY
HENRY LAPLANTE
FRANK DUFFEY
GOSSELIN
W.E. MENARD + A. AHAMEL
TAYLOR
GARDNER
JOS BONNEAU
CATHOLIC CHURCH
CATHOLIC CEMETERY
J.E. LAMBERT
FRANK BEAUREGARD
P.O.T. 276+31.3
REV. PI 277+71.3
REV. CURVE No. 61
Δ 13°-00' LT. (APPR) 8°-59'
D 8°
R 819.0
T 11.9
L 23.3
CURVE No. 60
Δ 19°-02' RT.
D 9°
R 573.7
T 106.7
L 211.3
SURVEY
PI 280+74.5
280+74.1
Δ 10°-03'
D 8°
SURVEY
PI 283+31.1
283+31.0
Δ 8°-38'
D 8°
REV. CURVE 13°45'
Δ 13°-50' RT. (APPR)
D 9°-5'
R 716.8
T 99.7
L 197.5
214.3
REV. CURVE
Δ 5°-39'
D 5°
R 716.8
T 84.3
L 167.3
E 3.2
REV. CURVE
Δ 4°-01' RT.
D 2°
R 2863.9
T 100.5
L 200.8
E 1.8
B.M. NO. 28
HYDRANT RING
EPI 76.38
Cubbie Gutter
EXISTING COBBLE GUTTER
Store
N. 81°-43' E.
N. 83°-43' E.
N. 73°-48' E.
Between Sta. 276+00 - Sta. 296+38.1 the curves are to be given a modified banking to conform with the present surface.
+2.00%
+0.989%
+1.644%
+6.235%
277+50
1.50 V.C.
756.10
282+25
1.50 V.C.
760.80
284+50
2.00 V.C.
764.50
288+75
1.50 V.C.
791.00
B.M. No. 28 - Nut of Hydrant Ring - 25 Lt 282+72 Elev 763.98
SERIES F NO. E-130-AR
