CONSTRUCT DRIVES
108 + 20 Rt (Pave)
109 + 75 Rt (Pave)
110 + 60 Lt (Pave)
111 + 09 Rt (Pave)
112 + 17 Rt (Pave)
112 + 52 Lt (Pave)
113 + 26 Rt (Pave)
113 + 75 Rt (Pave)
114 + 27 Lt (Pave)
115 + 90 Lt (Pave)
116 + 30 Rt (Pave)

CONSTRUCT APPROACH
108 + 85 Lt (T.H. 27) (Pave)

BITUMINOUS CONCRETE CURB
TYPE 'A'
~~108 + 00 Lt - 108 + 58 Lt (Island)~~
108 + 40 Rt - 109 + 60 Rt
109 + 19 Lt - 110 + 25± Lt
109 + 985 Rt - 110 + 85 Rt — 109 + 62 - 109 + 85 Rt. (Island)
111 + 00± Lt - 112 + 37 Lt
111 + 33 Rt - 112 + 02 Rt
112 + 32 Rt - 113 + 06 Rt
112 + 70 Lt - 114 + 05 Lt
113 + 43 Rt - 113 + 55 Rt (Island)
113 + 90 Rt - 116 + 09 Rt
114 + 50 Lt - 115 + 72 Lt
116 + 11 Lt - 7 + 24 Lt
116 + 44 Rt - 6 + 86 Rt

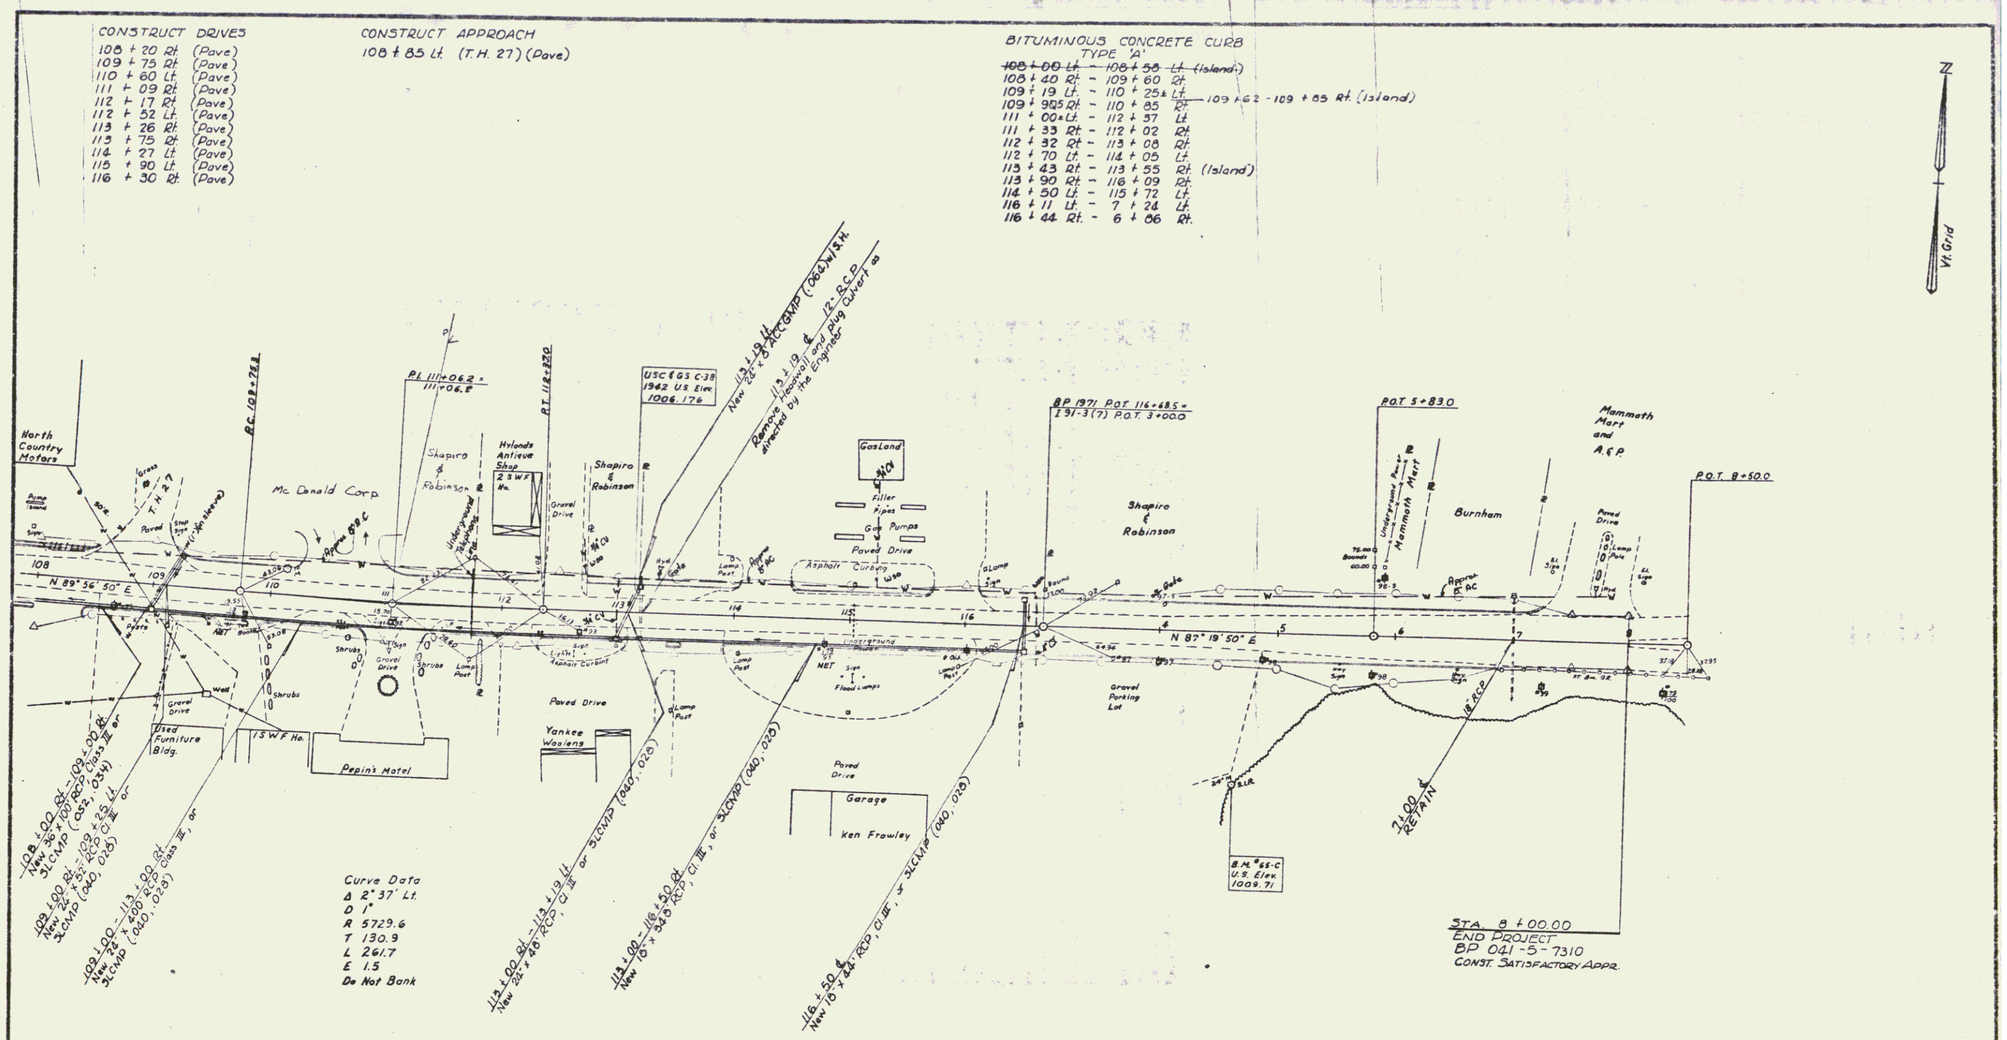

APR 16 1986

Derby

SURVEYED BY	Smith	DATE	12-71
DRAWN BY	Blodgett	DATE	12-71
TRACED BY	Gilman	DATE	4-72

PROJ. BP NO. 041-5-7310
SHEET 13 OF 47

6