


POOR ORIGINAL COPY

Full Curve Data
L=42°15' scaled
D=11°30'
R=
T=142.83
L=272.88
C.R.C.=1308

Curve Data
Δ 34°23' Lt
D 16'
R 3581
T 110.8
L 214.9
E 6.7

NEW F.O.W.
Present Road

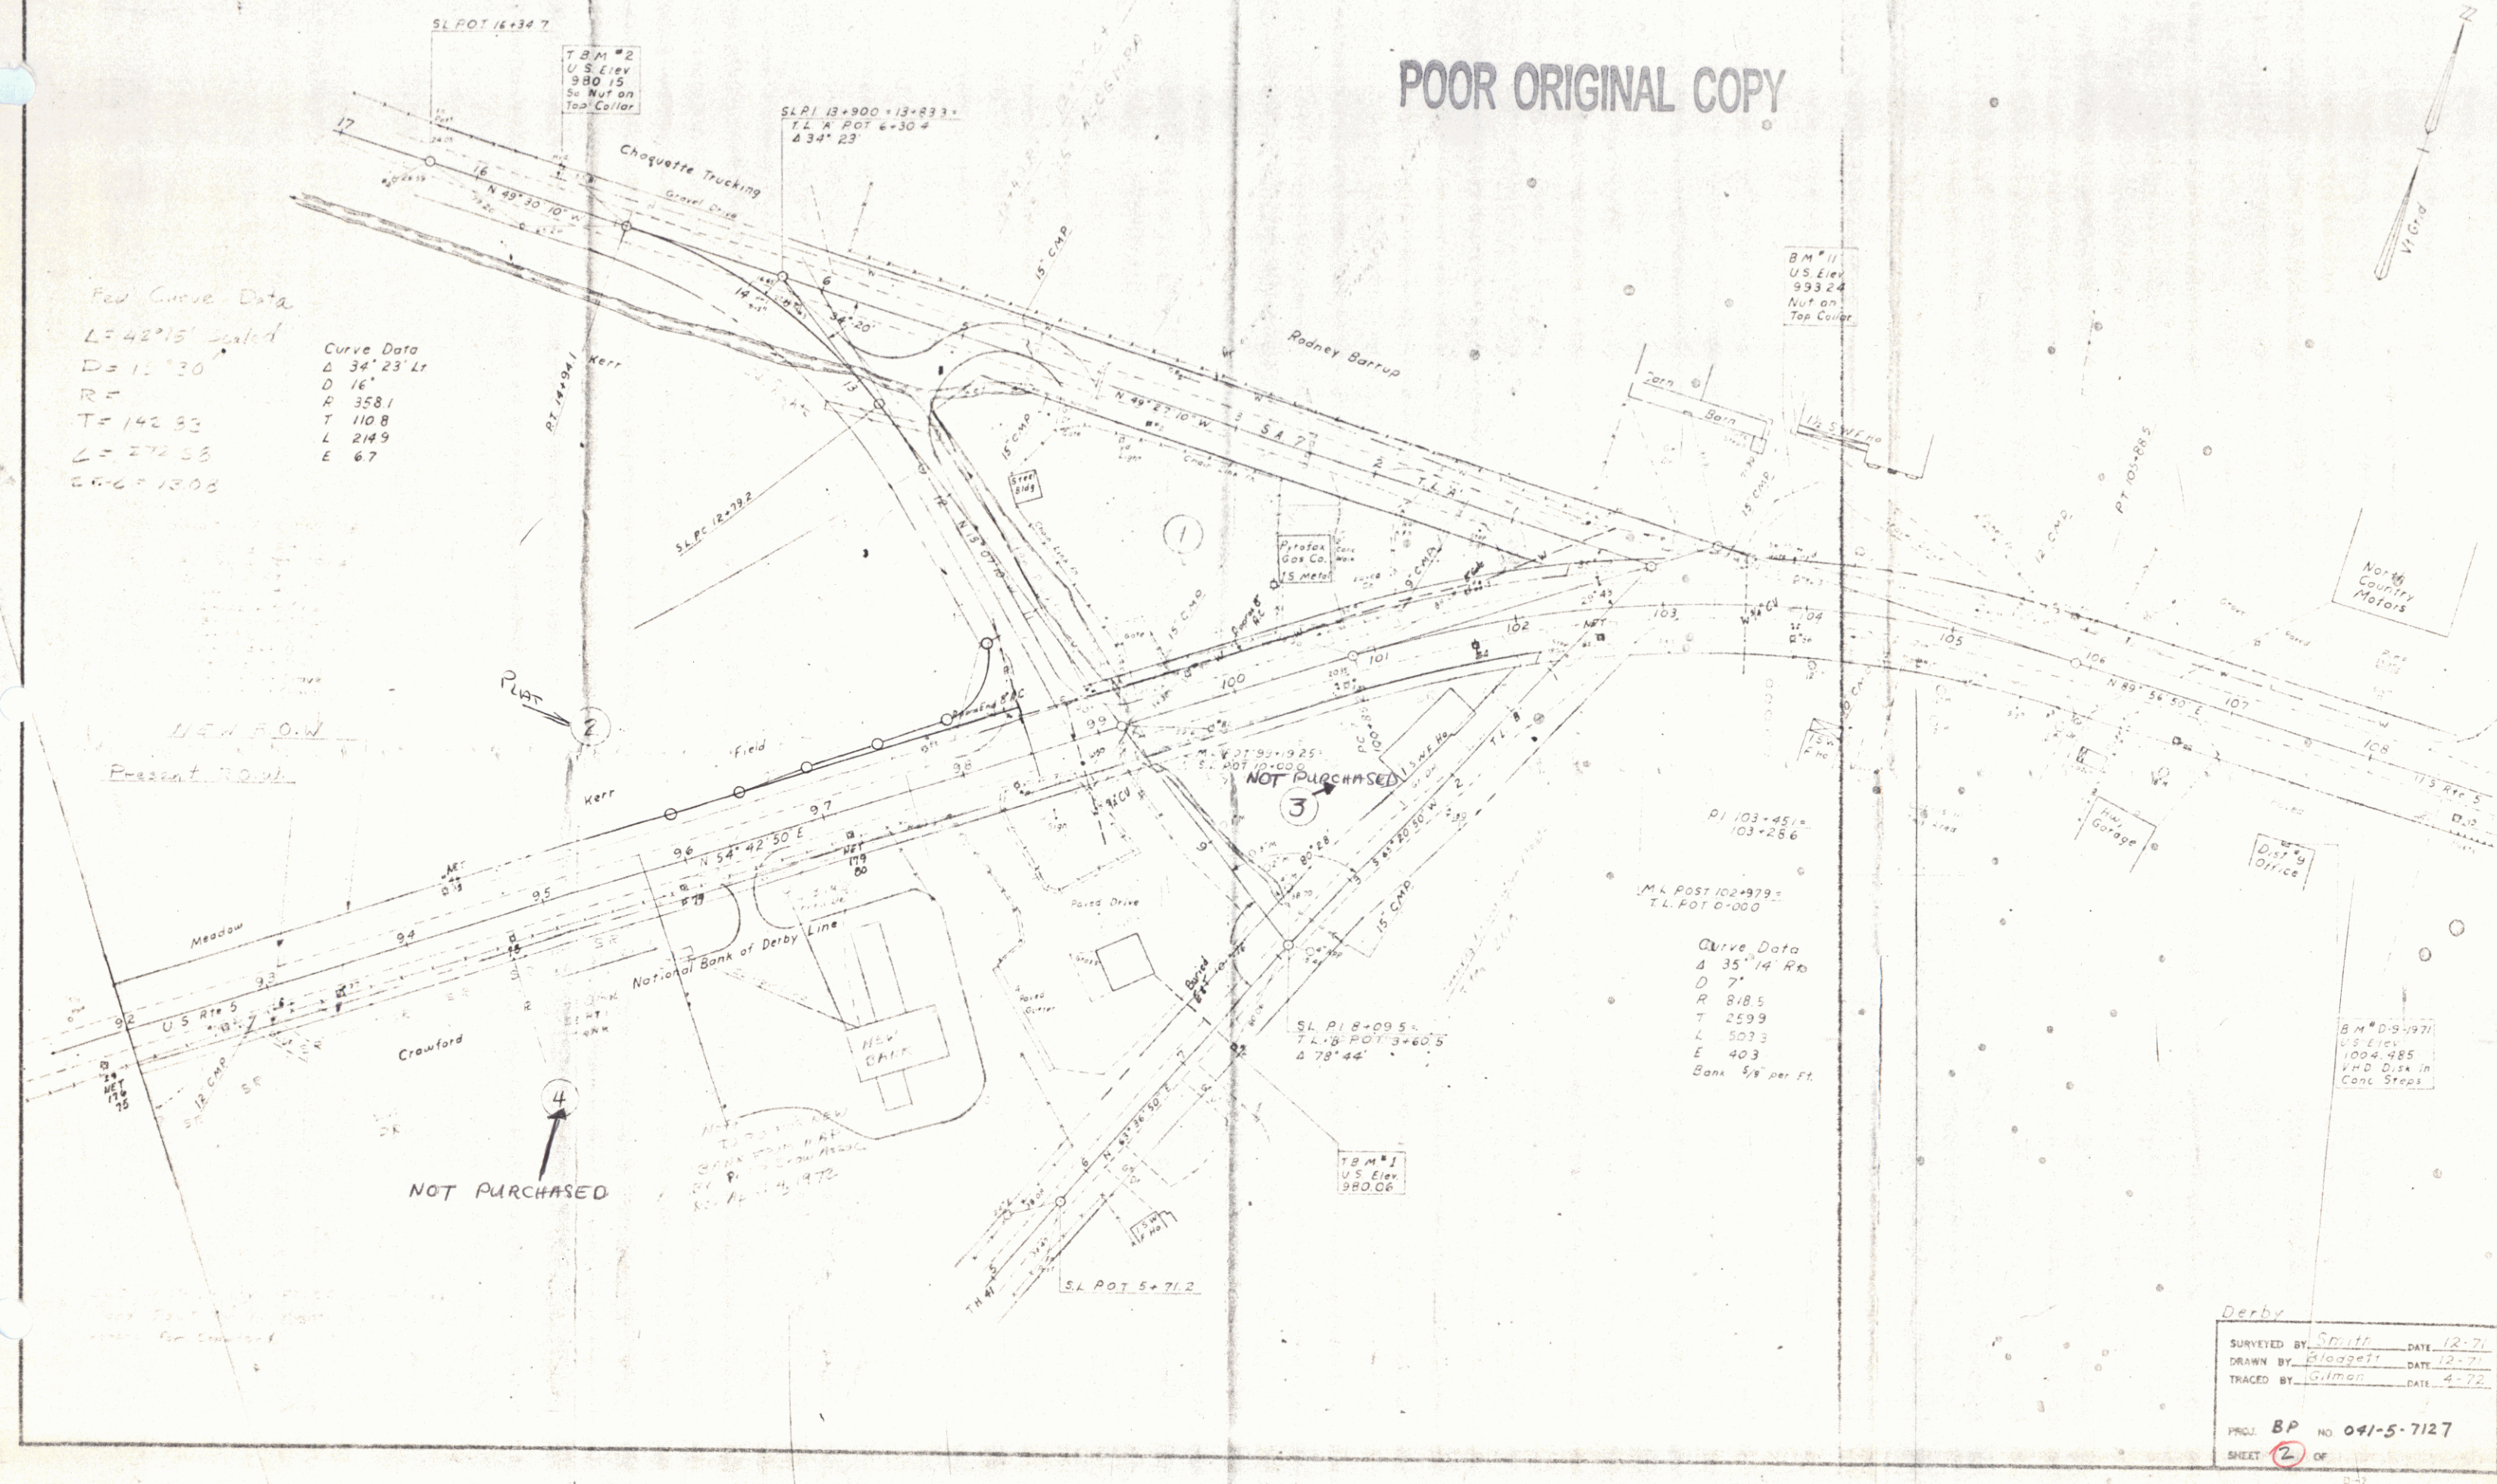

Derby
SURVEYED BY: Smith DATE: 12-71
DRAWN BY: Klappert DATE: 12-71
TRACED BY: Gilman DATE: 4-72
PROJ. BP NO. 041-5-7127
SHEET 2 OF