FED. ROAD DIST. NO	STATE	FED. AID PROJ. NO	FISCAL YEAR	SHEET NO.	TOTAL SHEETS
9	VT.	96A	1957	7	103

Wood Guard Rail Required

Left		
Sta. 57+20 to 57+43	Length	23 ~~27~~ ft.
Total This Sheet		23 ~~27~~ ft.

Cable Guard Rail Required

Right		
Sta. 61+96 to 63+00	Length	105 ~~96~~ ft.
Left		
Sta. 61+40 to 63+00-68+10	Length	125 ~~760~~ ft.
~~Sta. 67+25 to 68+15~~		~~38 ft.~~
Total This Sheet		290 ~~894~~ ft.

New Culverts Required

Sta. 57+32	15" Reinf. Concrete or Cast Iron Pipe	Length 32 ft.
	Class B (1-2½-5) Concrete	2.0 ~~1.0~~ cy.
	Reinforcing Steel	17 lb.

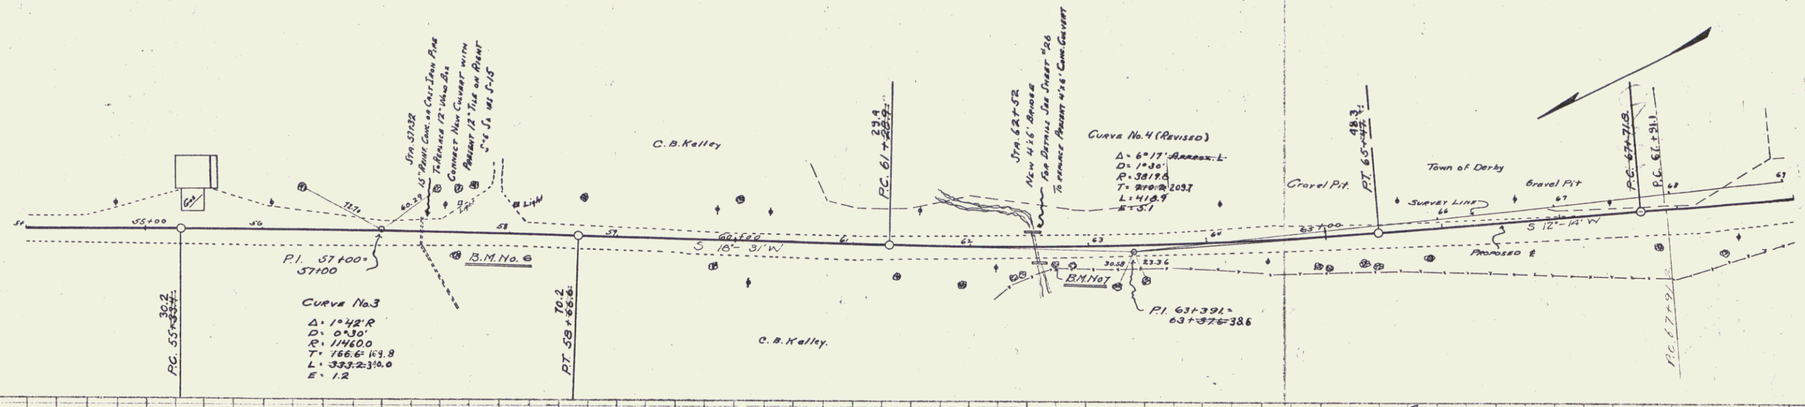

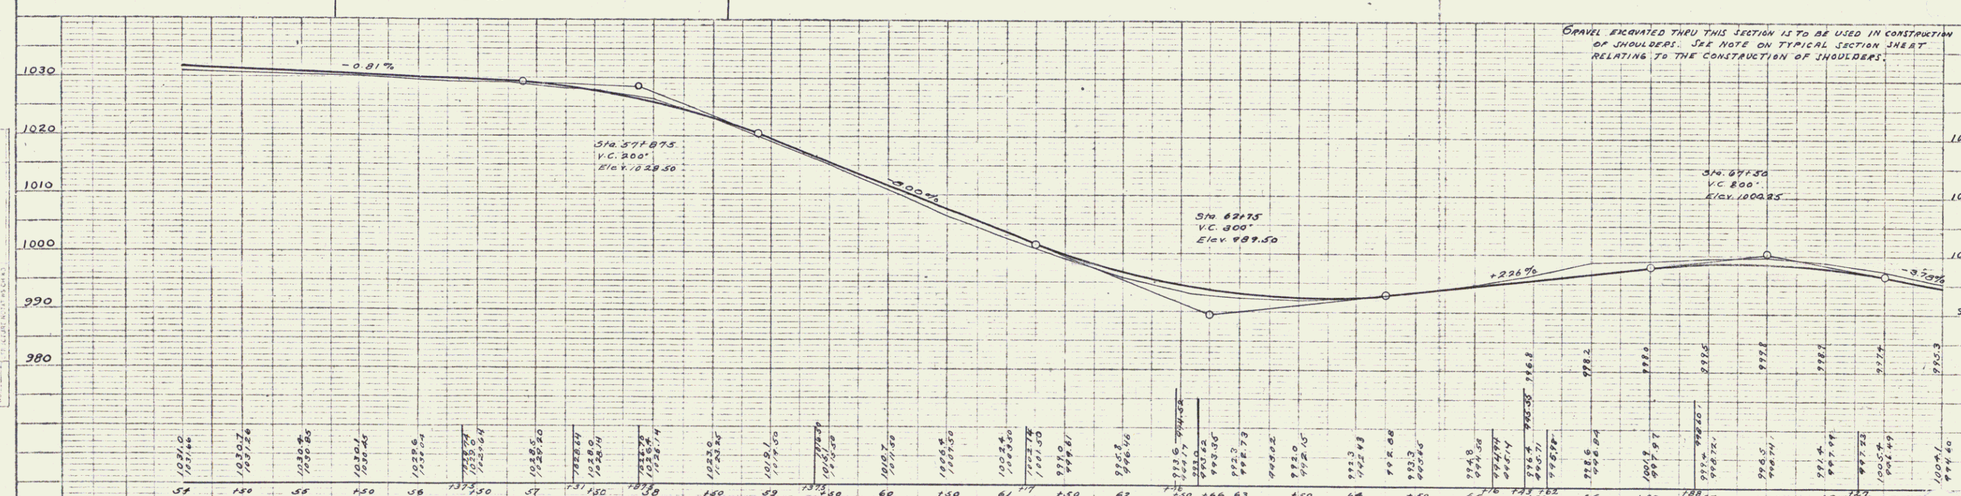

B.M. No. 6 Spike in 30 in Elm 19 ft. Right Sta. 51+66 Elev. 1028.40
B.M. No. 7 Header on Culvert (U.S.B.M.) Right Sta. 62+58 Elev. 993.81

Series F No. 96A
Sheet 7 of 103

PLAN — Noted by: A.R.R. 2-24-56; Note Book No. 1; Checked by: W.B. McAllister 3-29-57; Sheet No.

PROFILE — Noted by: A.R.R. 1956; Note Book No. 1; Checked by: W.B. McAllister 3-29-57; Sheet No.

6