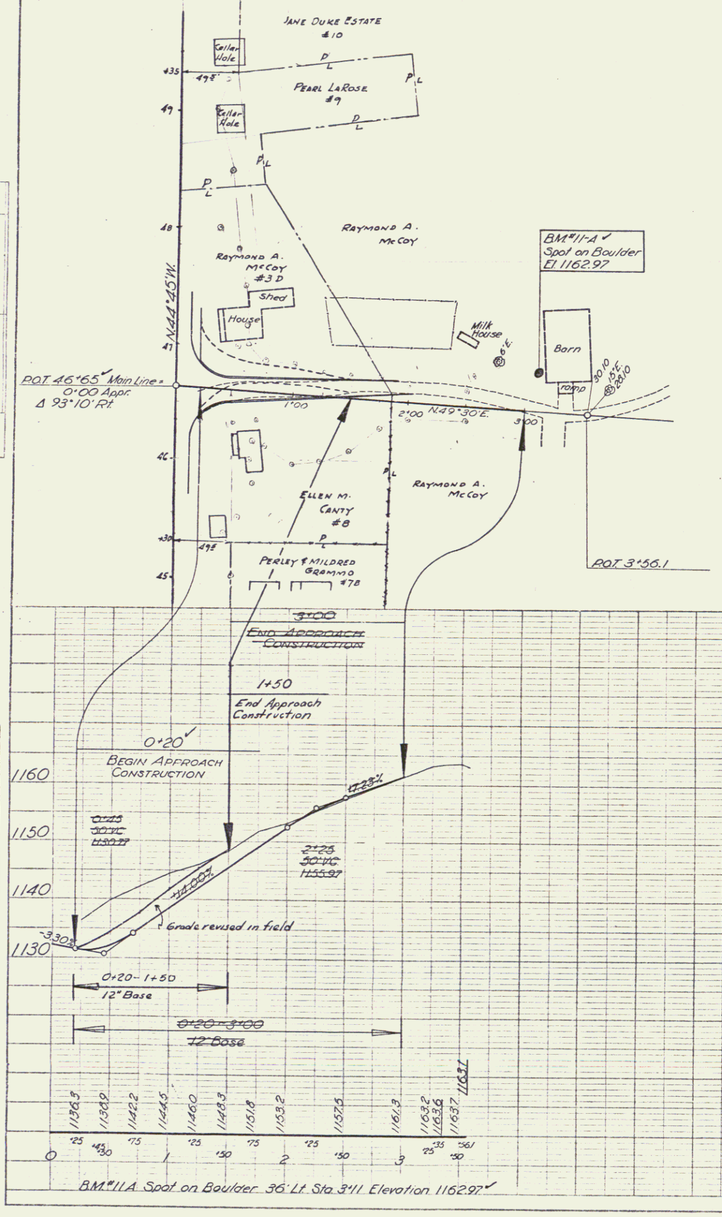

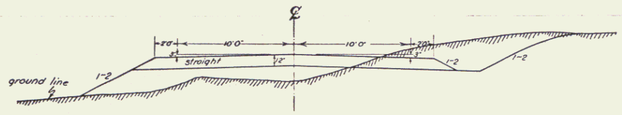

TYPICAL SECTION AT APPROACH
46°65 Rt.
Scale: 1"=5'

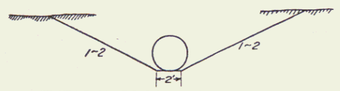

TYPICAL CROSS SECTION OF INLET OR OUTLET DITCH AT CULVERT LOCATIONS

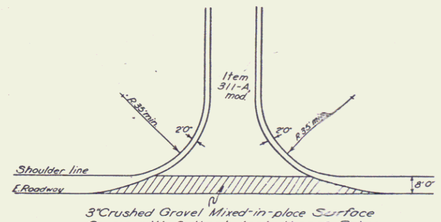

3" Crushed Gravel Mixed-in-place Surface Course with Cutback Asphalt and Prime Coat of Refined Tar (Class C), Item 342, mod.

DETAILS OF SURFACE AT APPROACH INTERSECTION
Scale: 1"=25'

EARTON
Proj. FAI No. 33(2)
Street 49 of 176

5