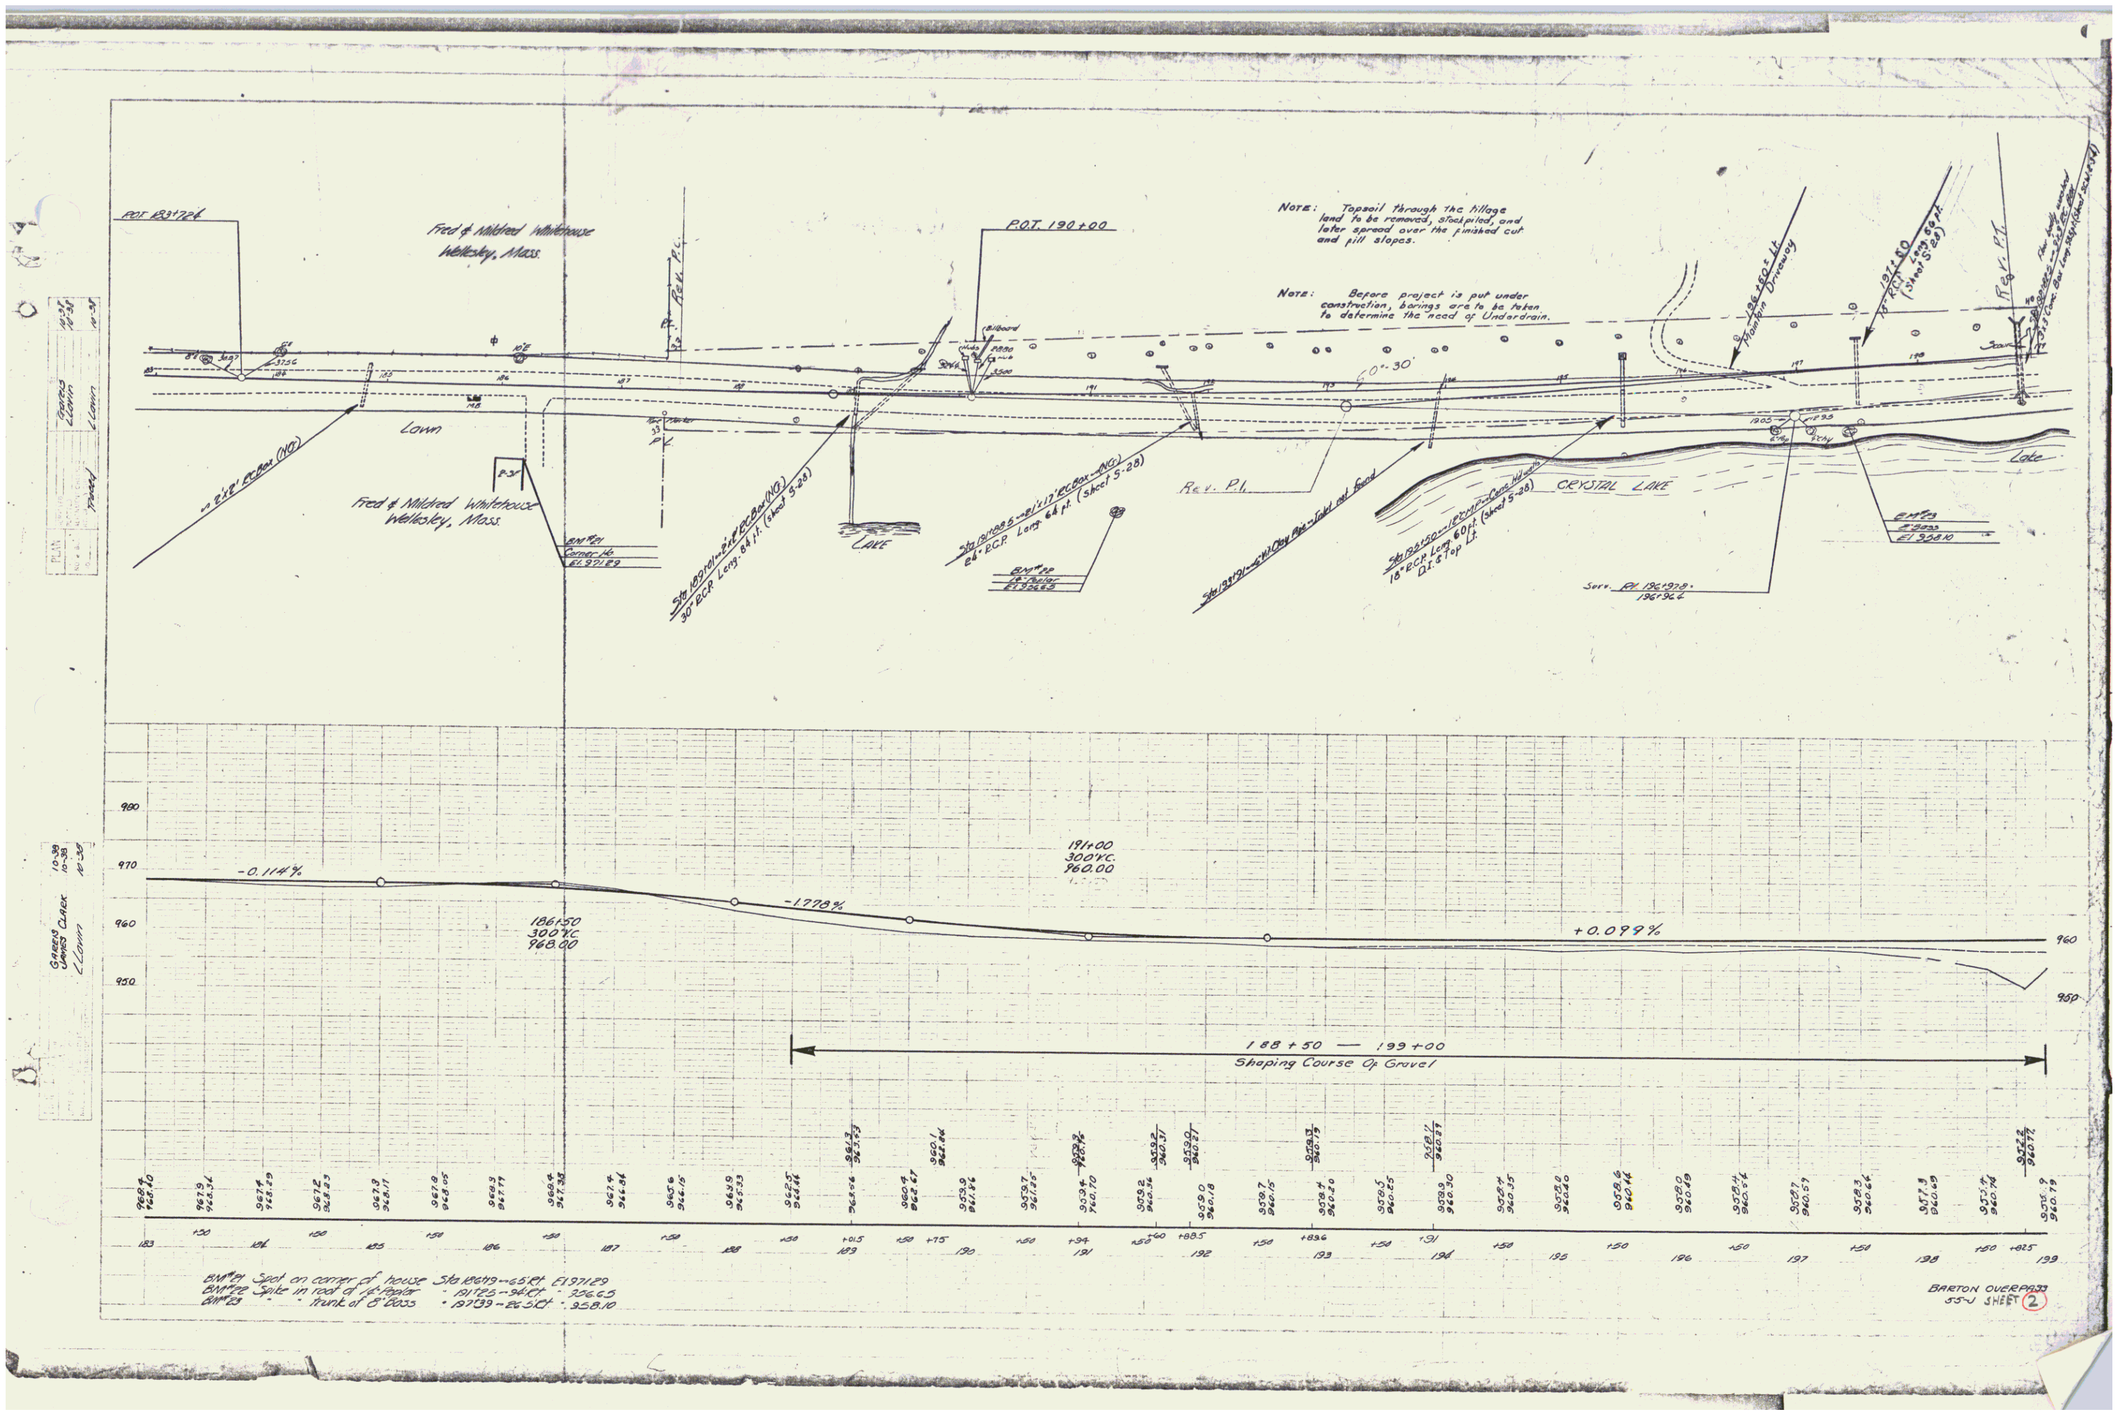
P.O.T. 183+26
Fred & Mildred Whitehouse
Wellesley, Mass.
P.O.T. 190+00
Note: Topsoil through the tillage land to be removed, stockpiled, and later spread over the finished cut and fill slopes.
Note: Before project is put under construction, borings are to be taken to determine the need of Underdrain.
Lawn
Fred & Mildred Whitehouse
Wellesley, Mass.
Rev. P.I.
CRYSTAL LAKE
Lake
Shaping Course of Gravel
BARTON OVERPASS
55-J SHEET 2