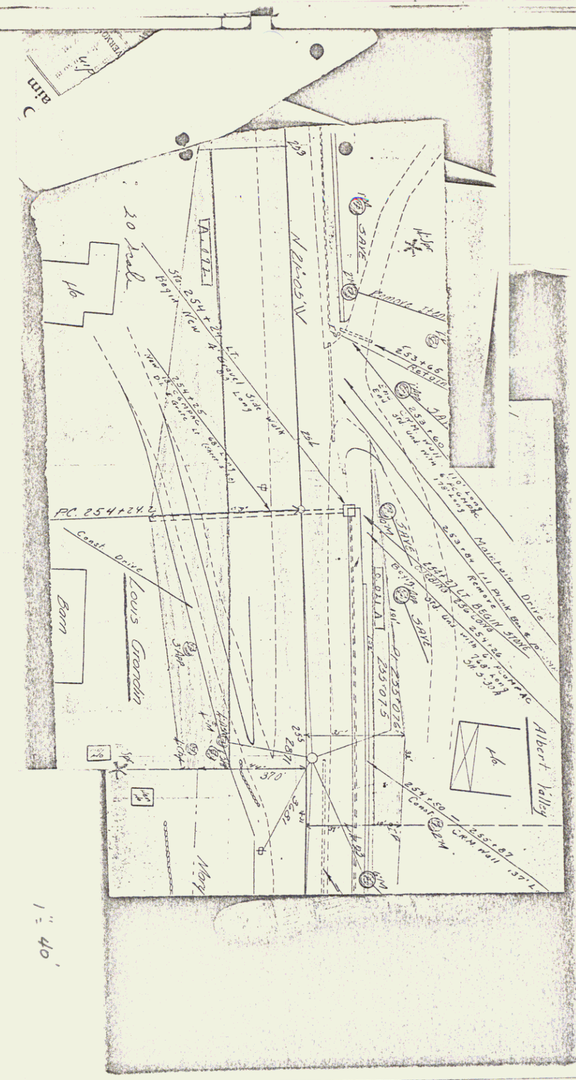

Barton US 5

3

3