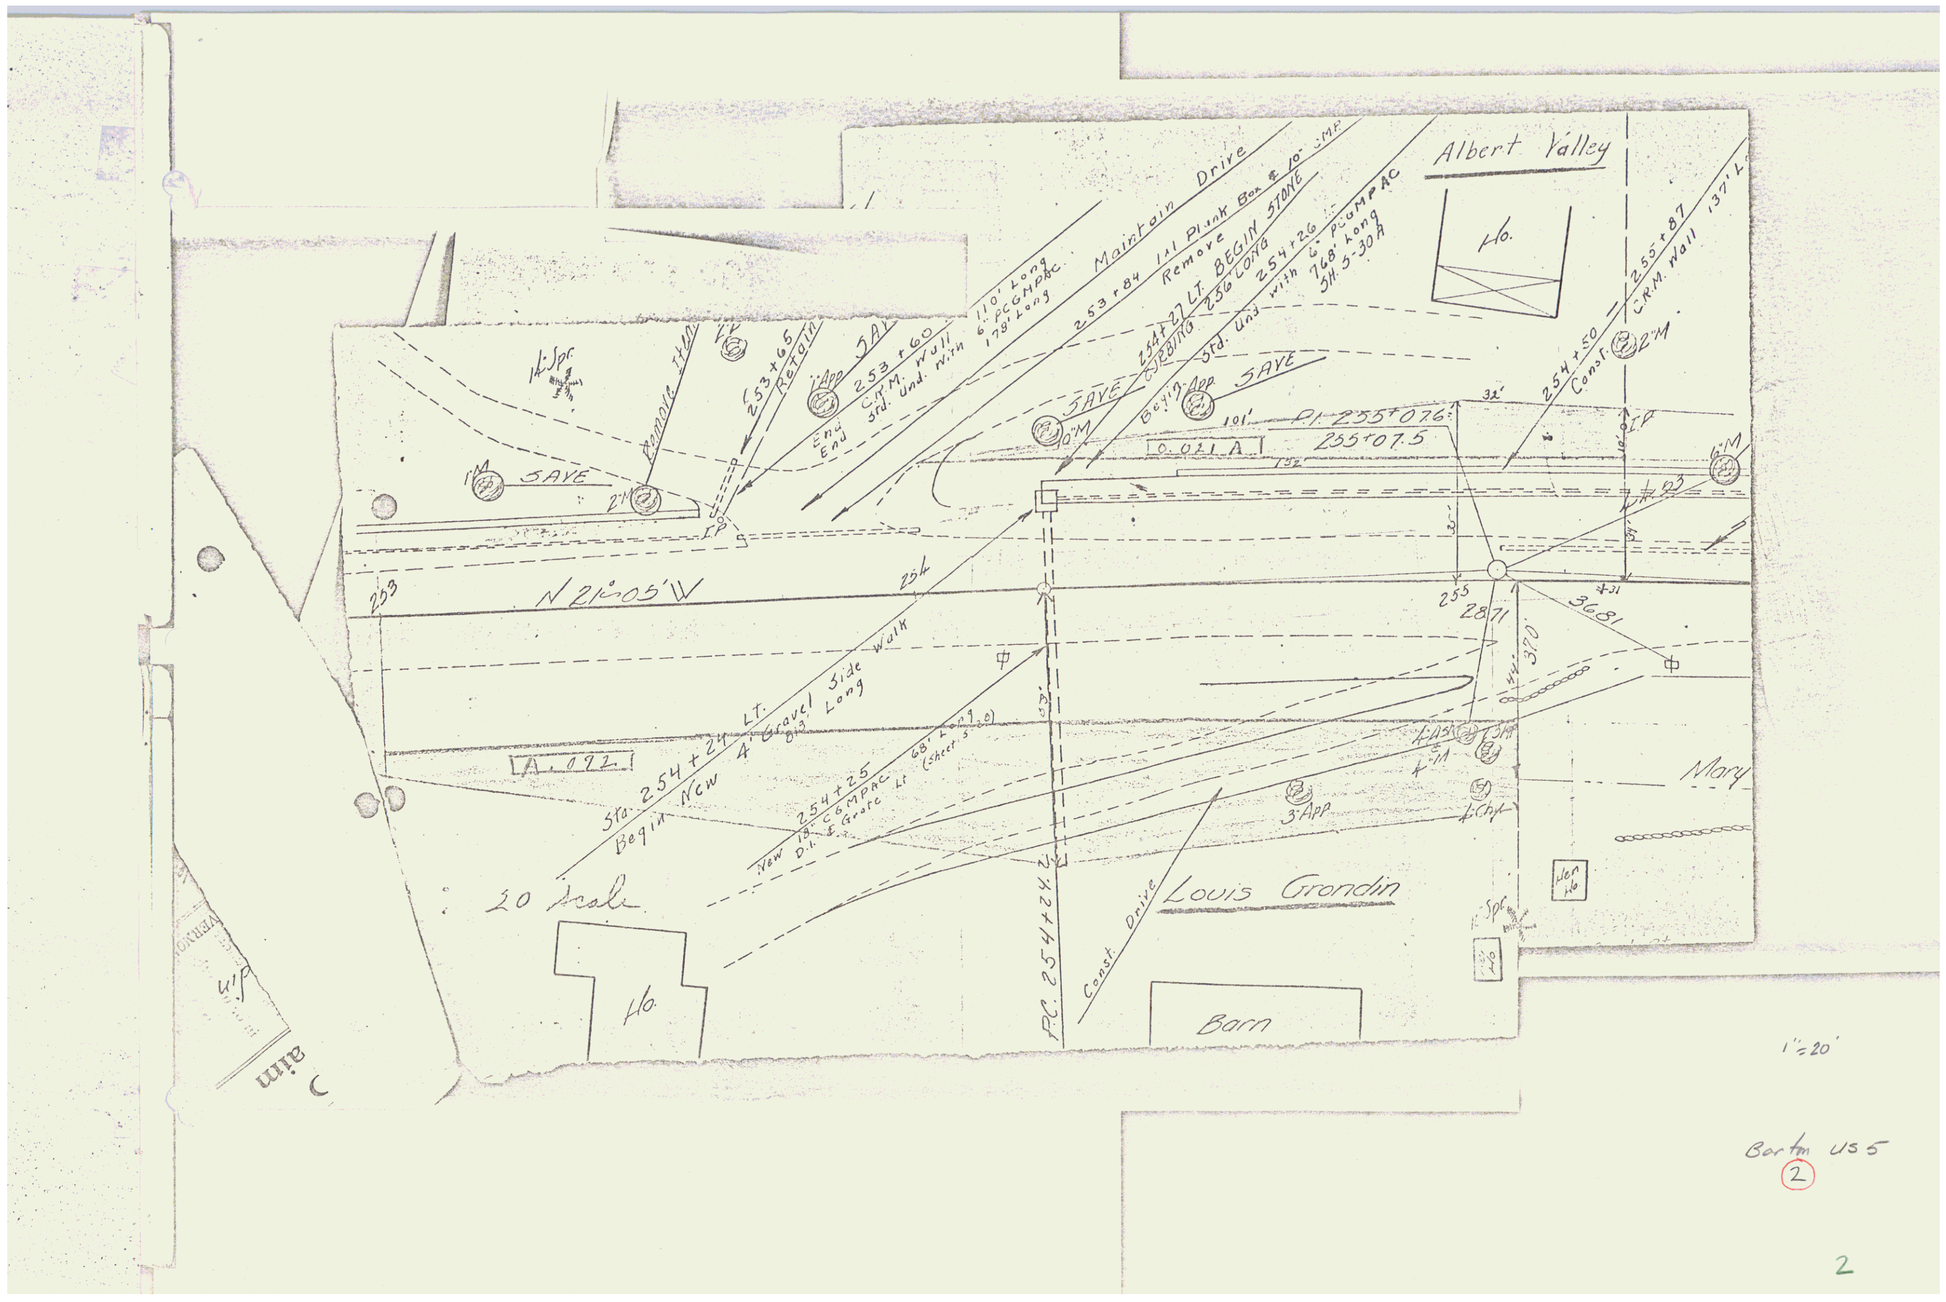
Albert Valley
Ho.
Maintain Drive
253+84 1.1' Pink Box & 10" SMP
Remove
254+27 LT. BEGIN STONE
Begin 256 LONG
254+26
768' Long
3H.S-30A
255+87
C.R.M. Wall 137' L
254+50
Const.
2"M
SAVE
253+65
RETAIN
253+60
C.R.M. Wall
3rd. Und. Wall
11.0' Long
6" PC GMPAC
178' Long
End
Begin
Remove
Pl 255+07.6
255+07.5
0.021 A
N 21°05' W
253
254
255
28.71
36.81
370
Walk
Sta. 254+24 LT.
Begin New 4' Gravel Side Walk
Long
A.022
254+25
New 1A. COMPAC
D.I. & Grade Lt
68' Long
(Sheet 3)
Mary
3"App
4"Chf
Louis Grandin
Const. Drive
P.C. 254+24
20 Scale
Ho.
Barn
1"=20'
Barton US 5
2

2