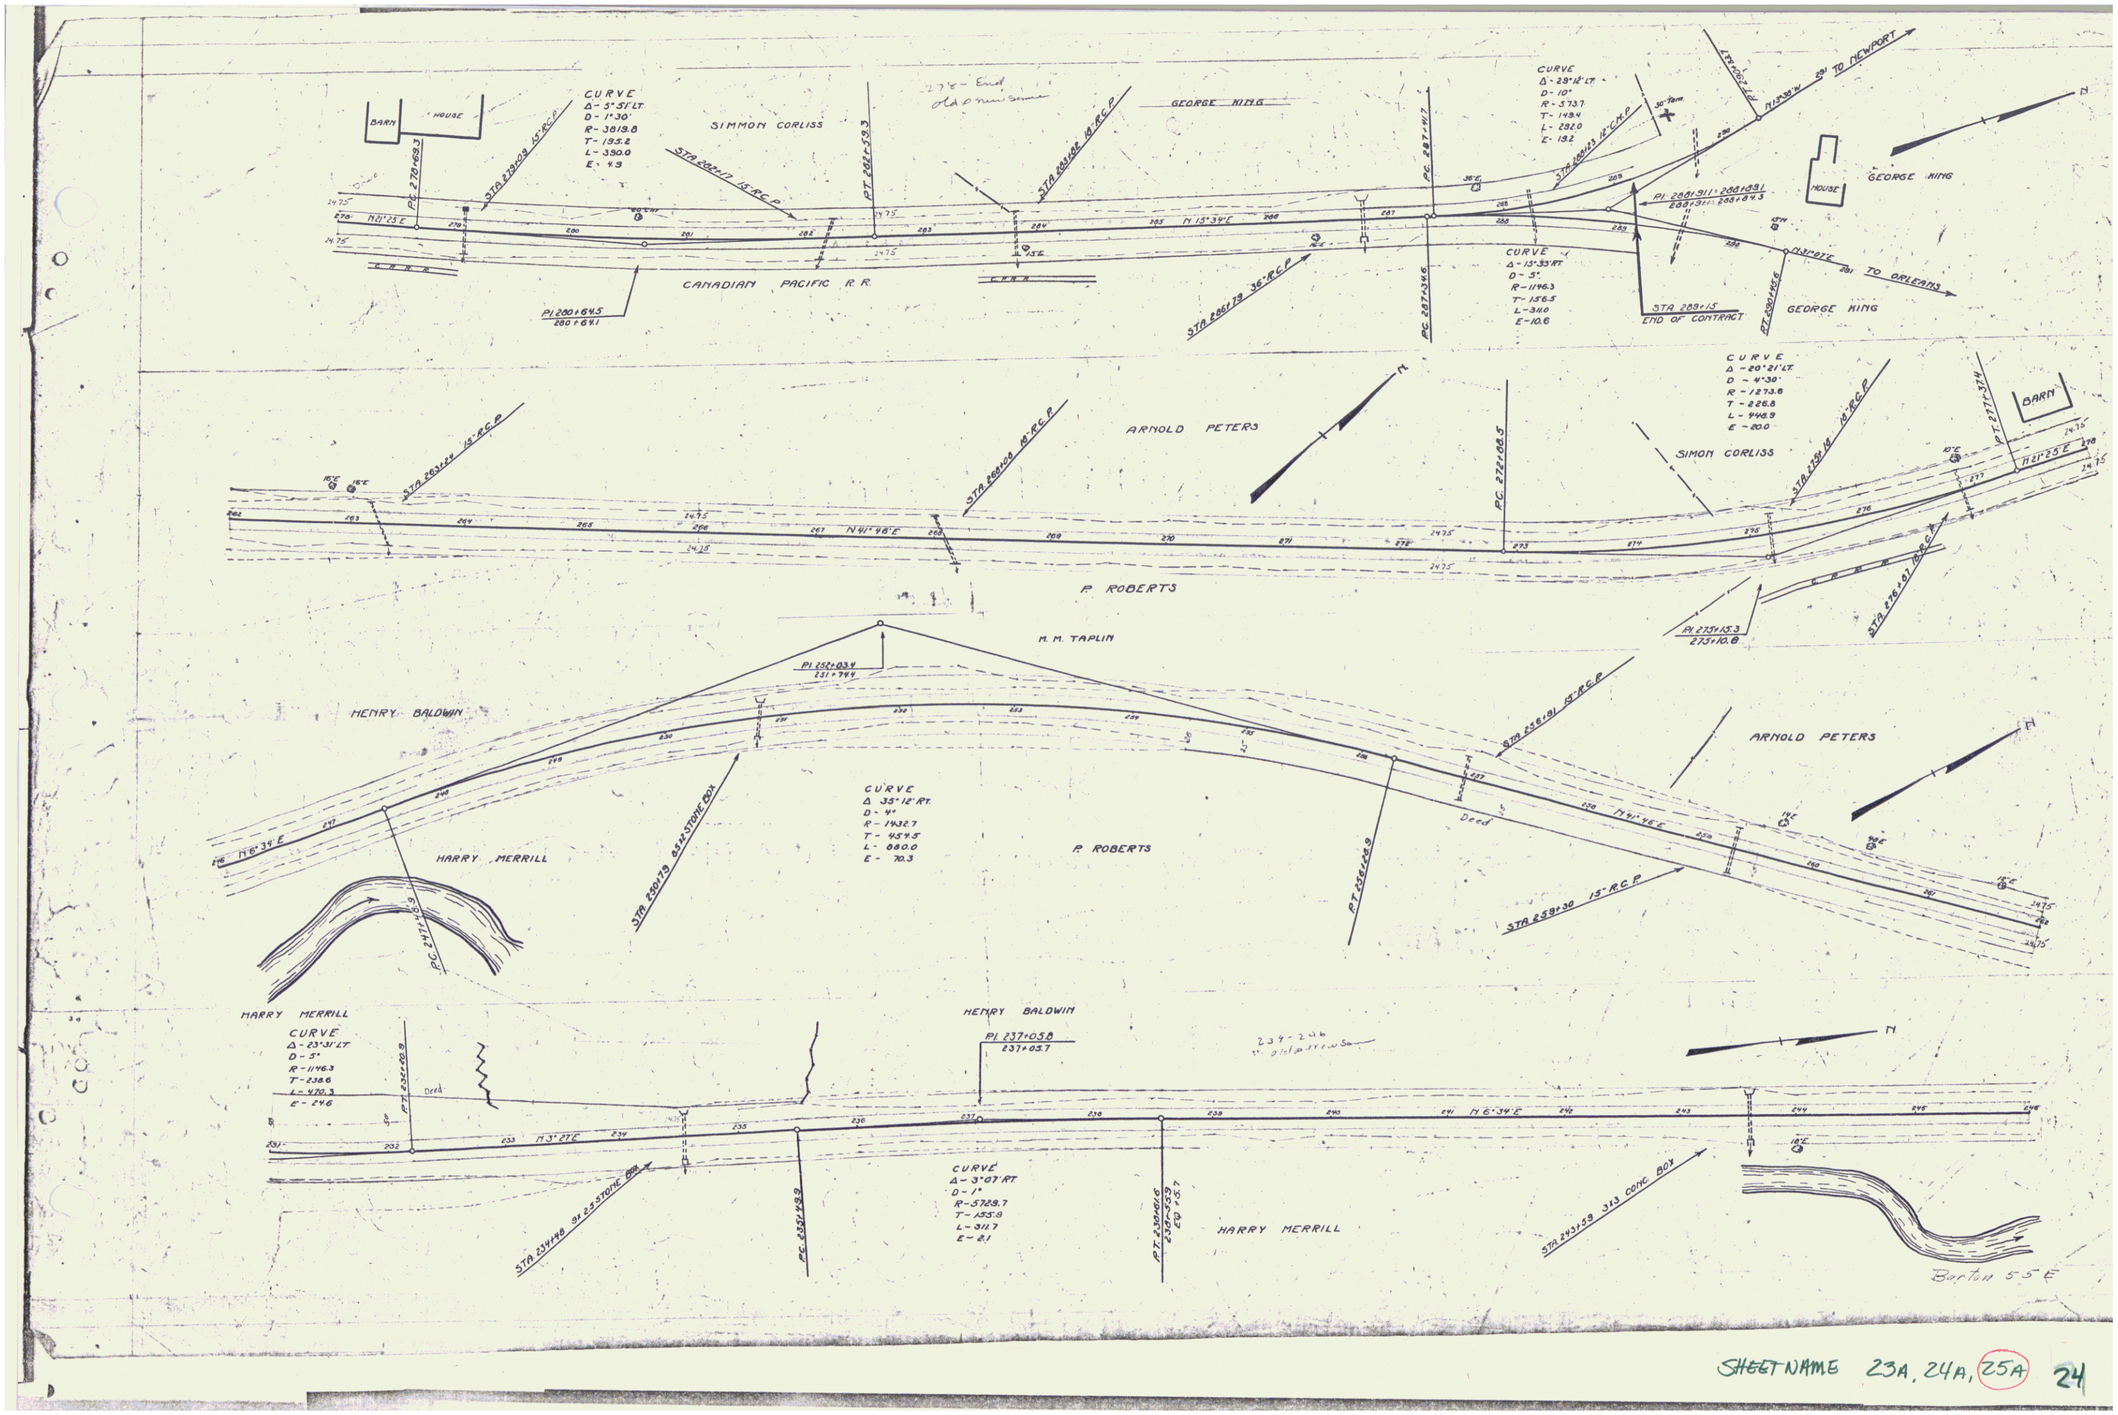

SHEET NAME 23A, 24A, 25A 24