DIST.	STATE	PROJ. NO.	FISCAL YEAR	SHEET NO.	TOTAL SHEETS
9	VT.	3510		10	27

POST WAR F A PRIMARY

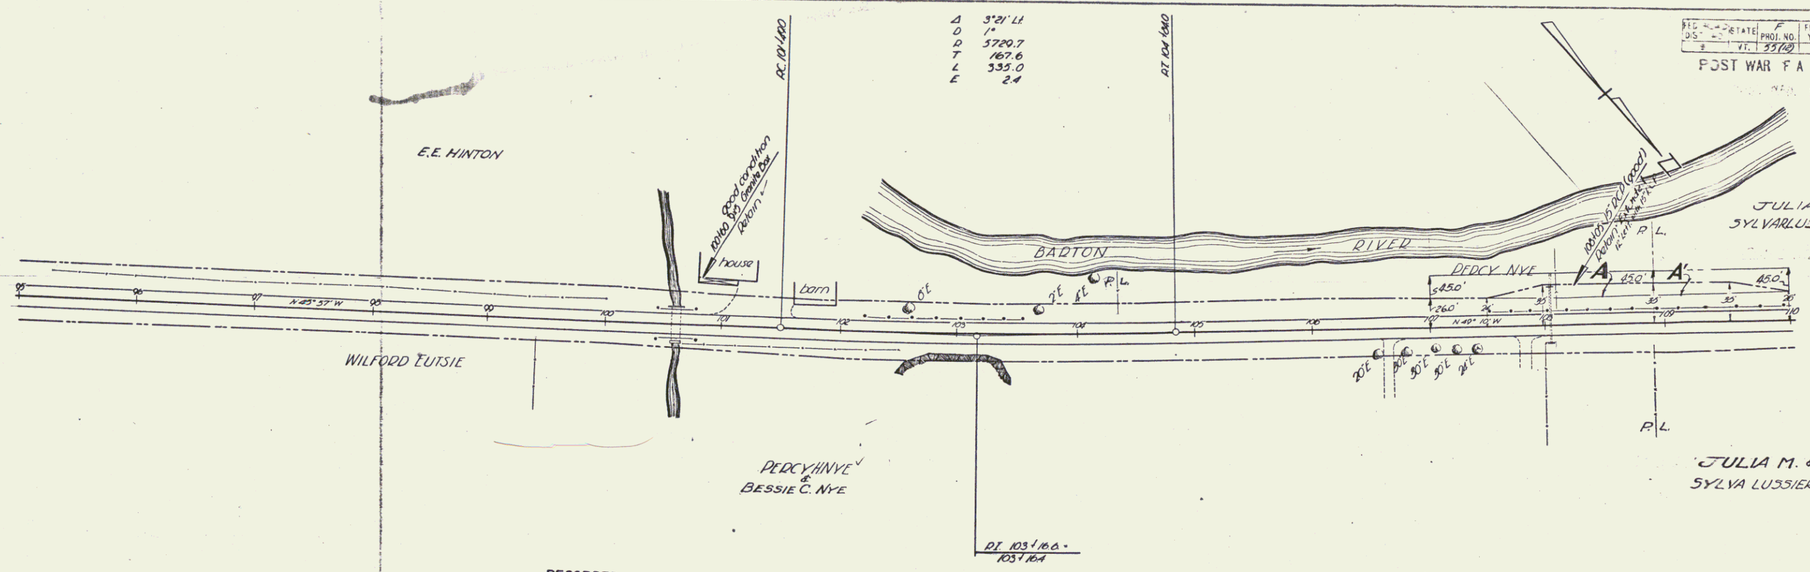

PARCEL	INSTRUMENT	DATE	GRANTOR	GRANTEE	RECORDED BARTON BOOK	PAGE	DATE	REMARKS
A	W.D.O.E	9-27-48	PEDCY NYE & BESSIE C. NYE	ST. OF VT.	47	224	9-11-48	
A'	W.D.O.E	7-27-48	JULIA M. LUSSIER	ST. OF VT.	47	225	9-11-48	

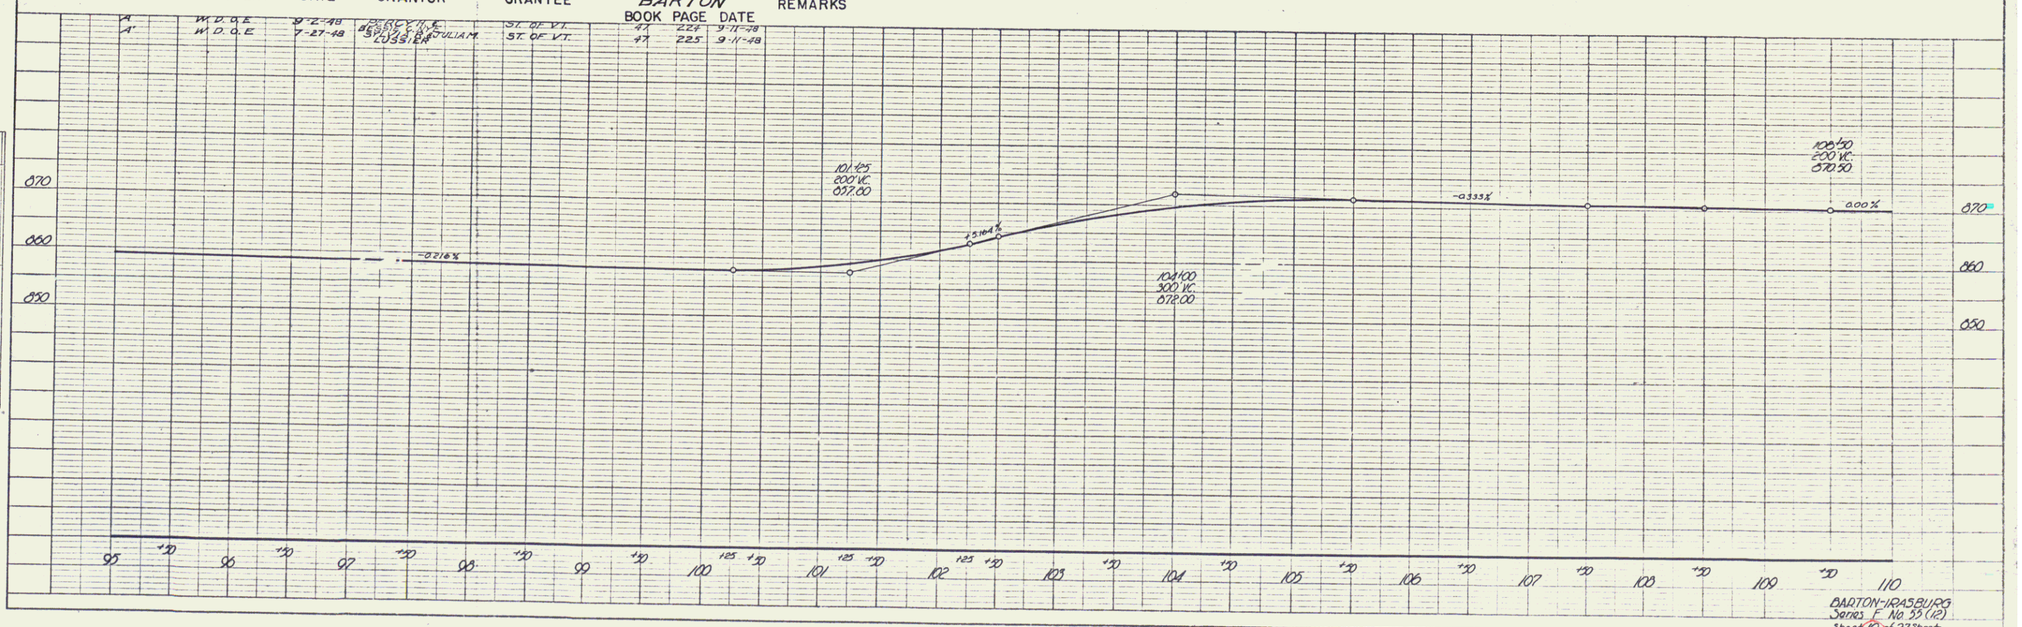

BARTON-IRASBURG
Series F No. 55 (12)
Sheet 10 of 27 Sheets

PLAN
SURVEYED
PLOTTED
NOTE BOOK ALIGNMENT CHECKED
FIELD CHECKED
NO. RETRACED Houghton
DATE

PROFILE
SURVEYED
PLOTTED
NOTE BOOK GRADES CHECKED
B.M.'S NOTED
NO. BENCHMARKS NOTED (ON NO.)
DATE

PLATE I - PLAN-PROFILE O.P.R.R.E. STANDARD
KEUFFEL & ESSER CO. NEW YORK.
K. & E. Co. No. 248 - C

8