FED. ROAD DIST. NO.	STATE	F PROJ. NO.	FISCAL YEAR	SHEET NO.	TOTAL SHEETS
9	VT.	55(12)		18	27

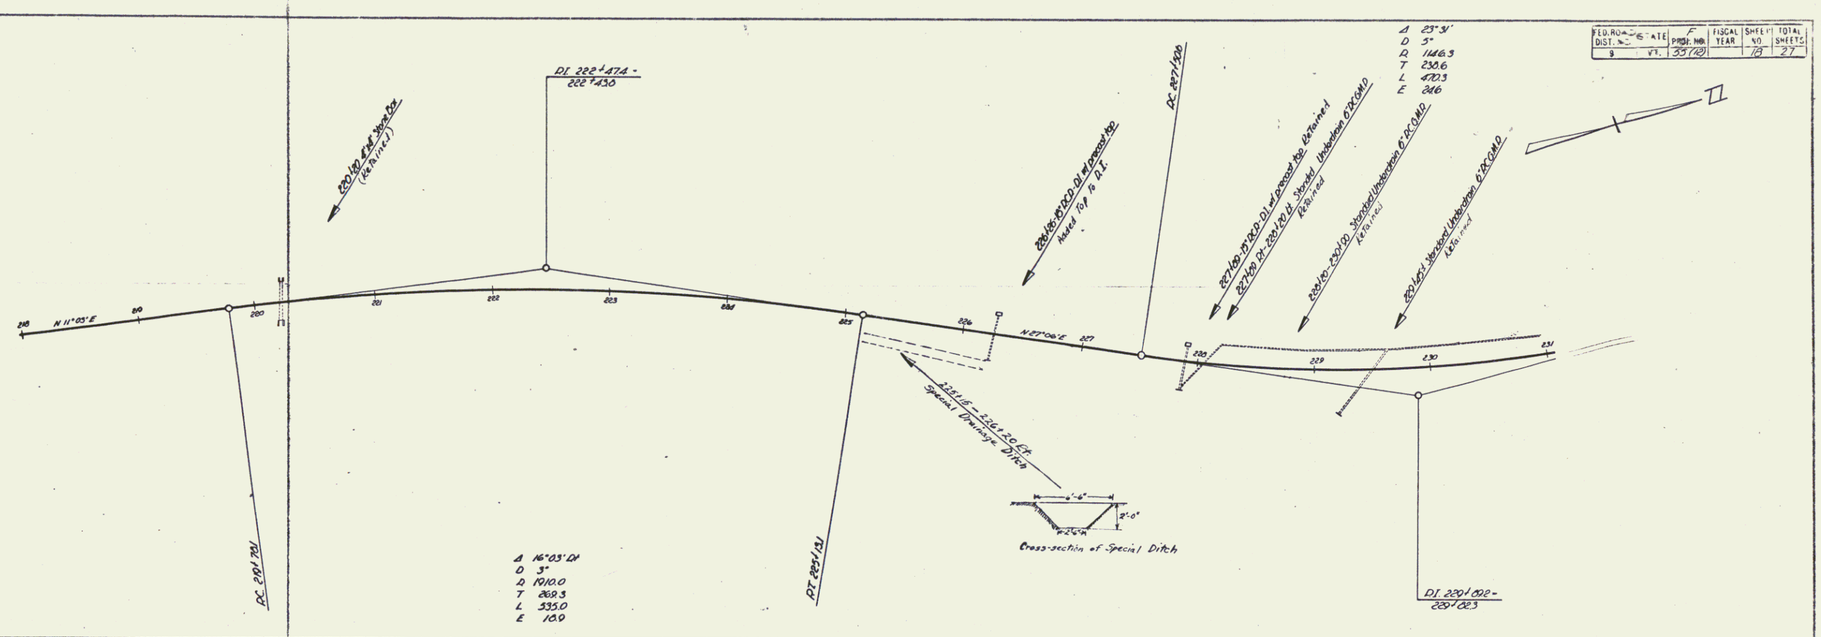

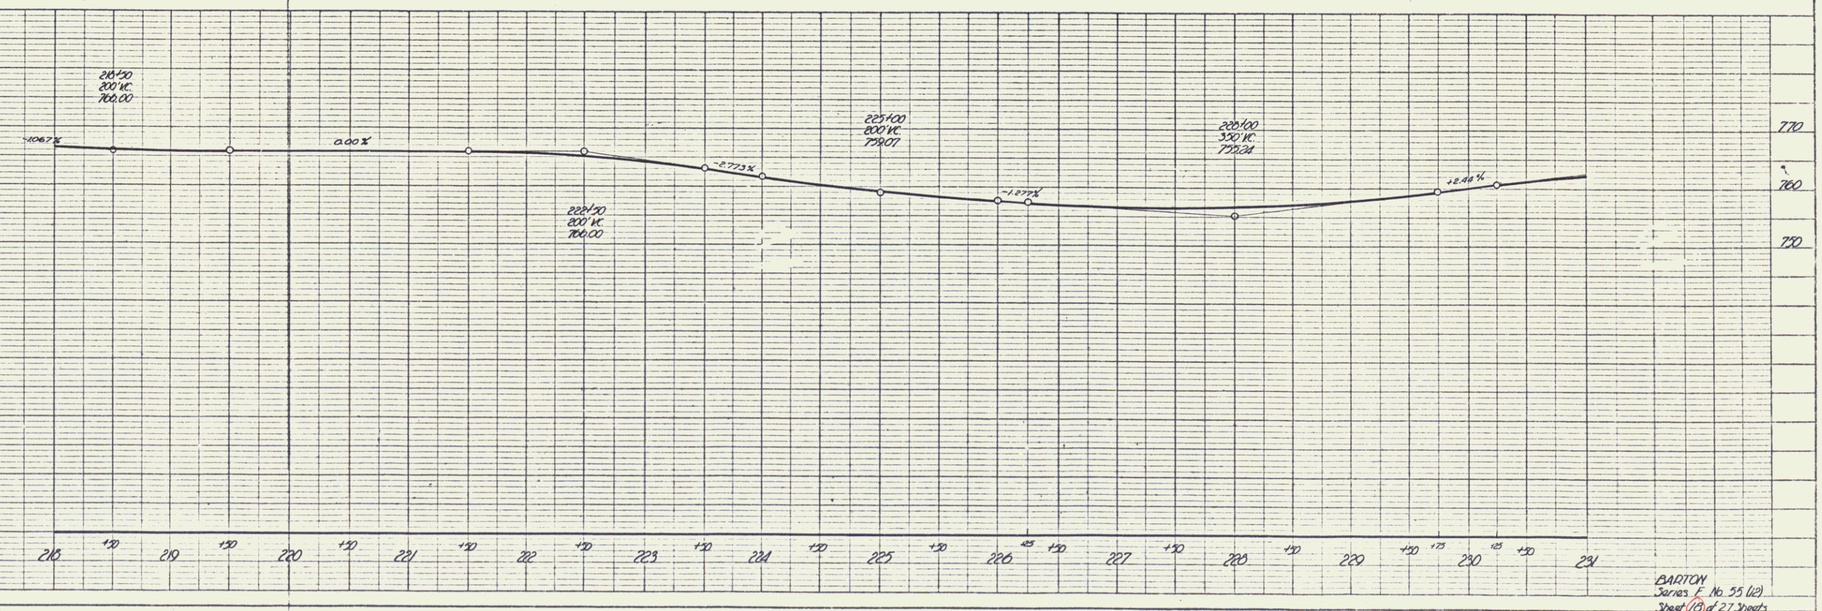

BARTON
Series F No. 55 (12)
Sheet 18 of 27 Sheets

PLATE 1—PLAN-PROFILE O. P. R. & R. E. STANDARD
KEUFFEL & ESSER CO., NEW YORK.
K & E Co. No. 348-1C

16