FED. ROAD DIST. NO	STATE	FED. AID PROJ. NO	FISCAL YEAR	SHEET NO	TOTAL SHEETS
3	VT.	13	1960	4	18

GUARD RAIL REQUIRED

ON LEFT
Sta. 17+88 to Sta. 18+12 Length 24 ft.
" 25+67 " " 25+91 " 24 "
ON RIGHT
Sta. 16+00 to Sta. 18+72 Length 272 ft.
" 19+20 " " 26+00 " 680 "
TOTAL THIS SHEET 1000 ft.

STANDARD UNDERDRAIN REQUIRED

Sta. 18+00 to Sta. 31+00 Length 1300 ft.

NEW CULVERTS REQUIRED

Sta. 18+00 16" Cor. Iron Pipe 36 ft.
1-2-4 Concrete Head Walls 1.5 cu. yds.
Sta. 25+78 16" Cor. Iron Pipe 26 ft.
1-2-4 Concrete Headwalls 1.5 cu. yds.

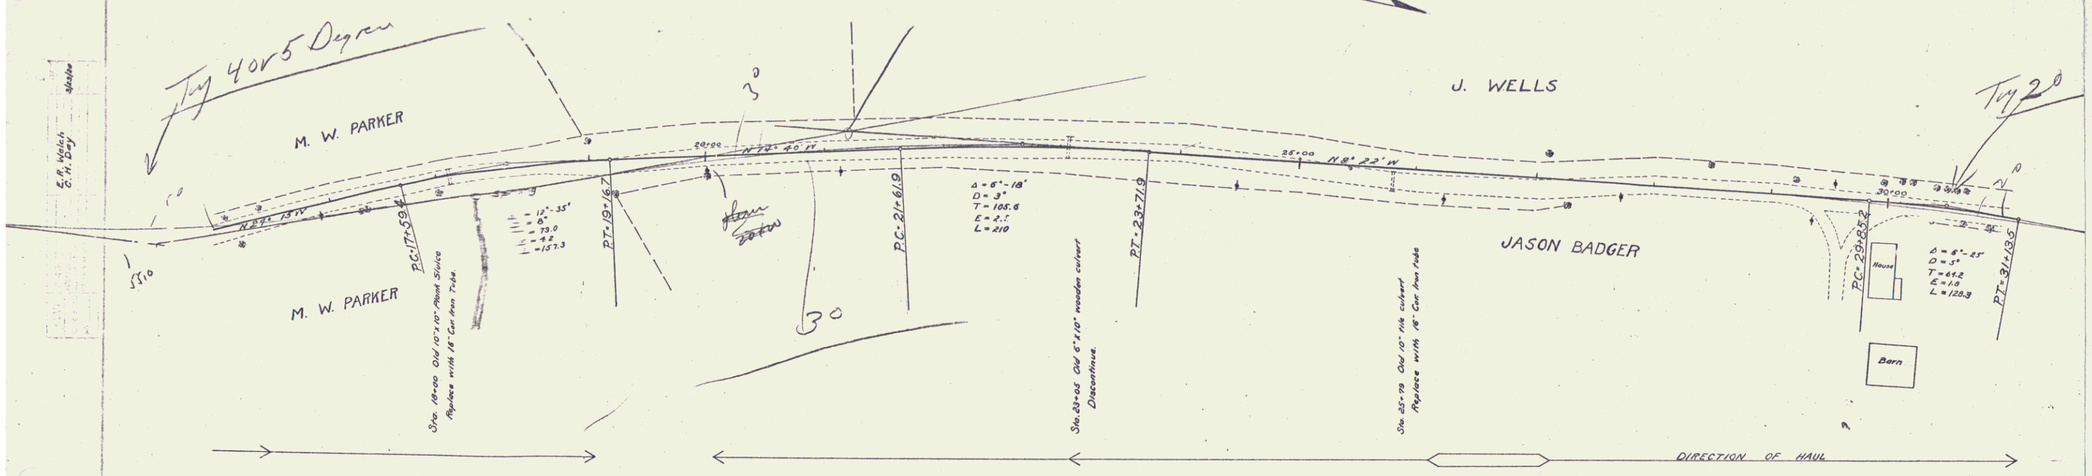

Series F No. 19 Filed 31 Sheets

3