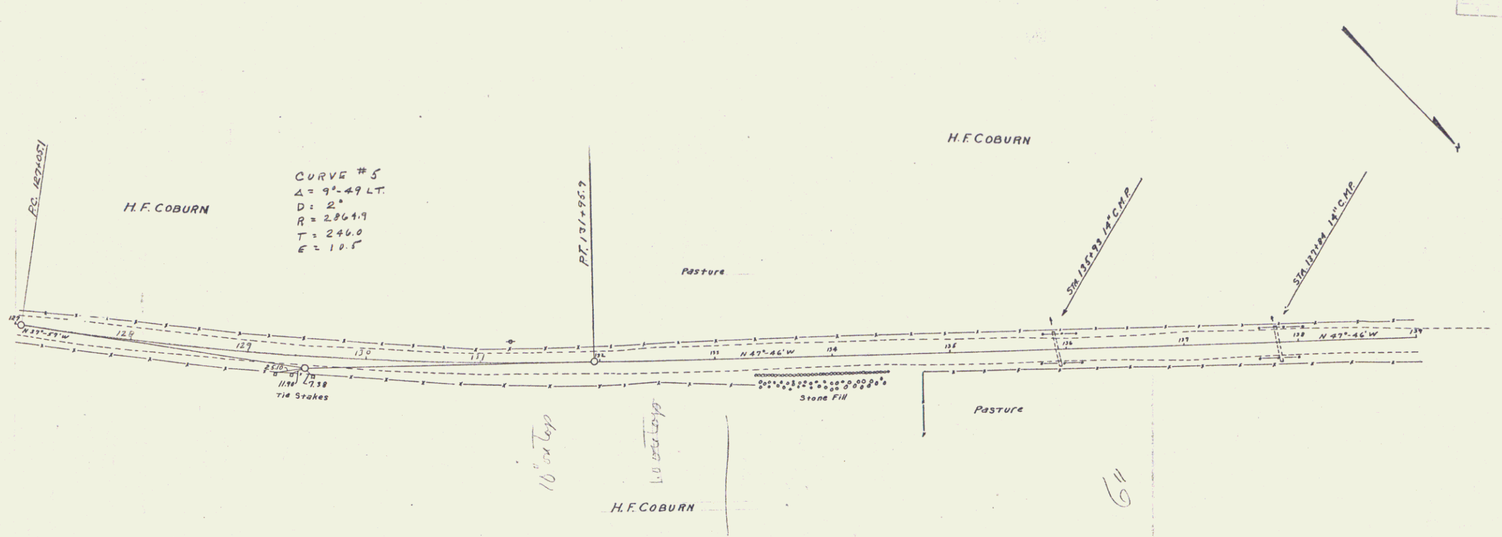

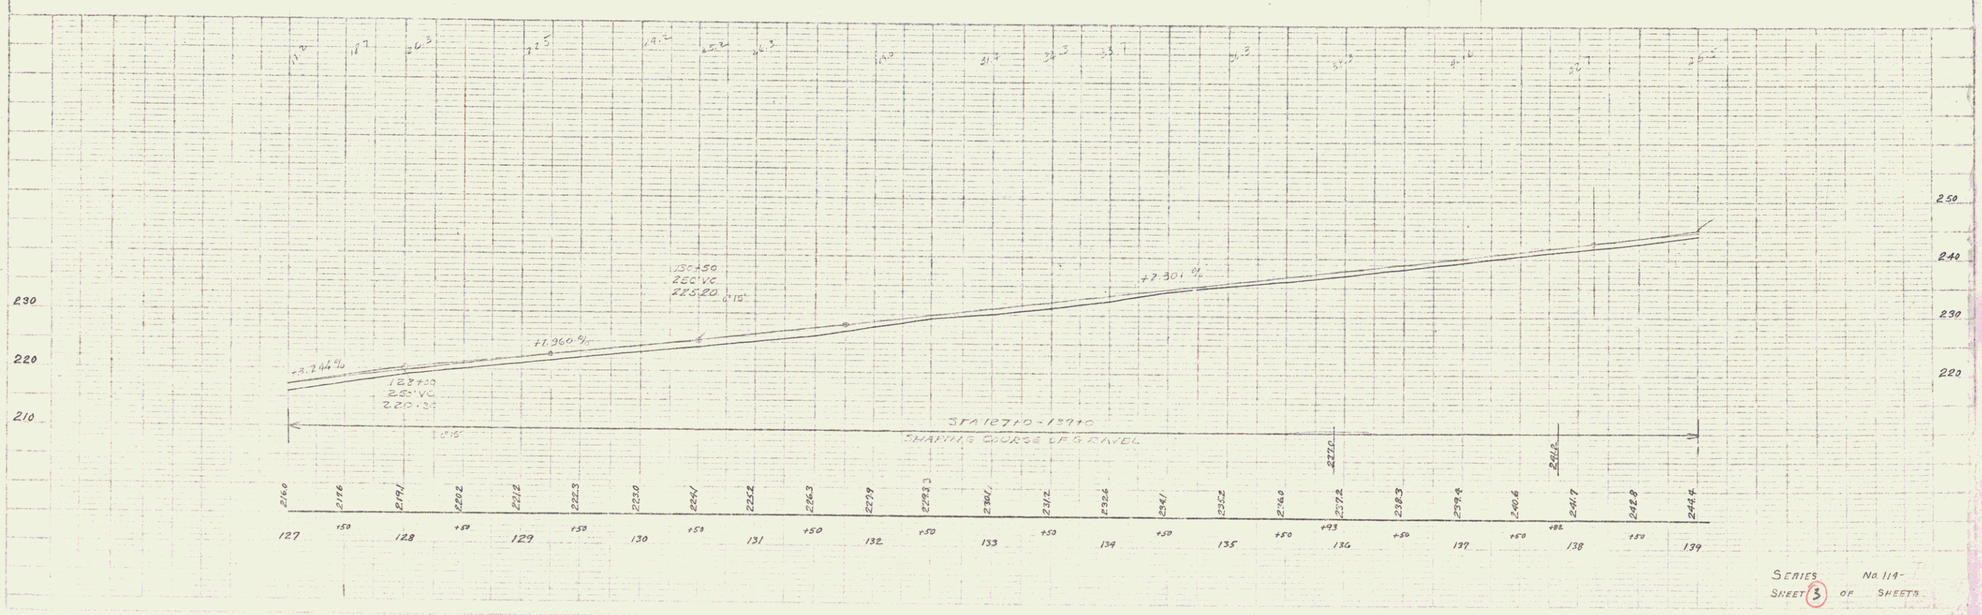

SERIES No. 114-
SHEET 3 OF SHEETS

3