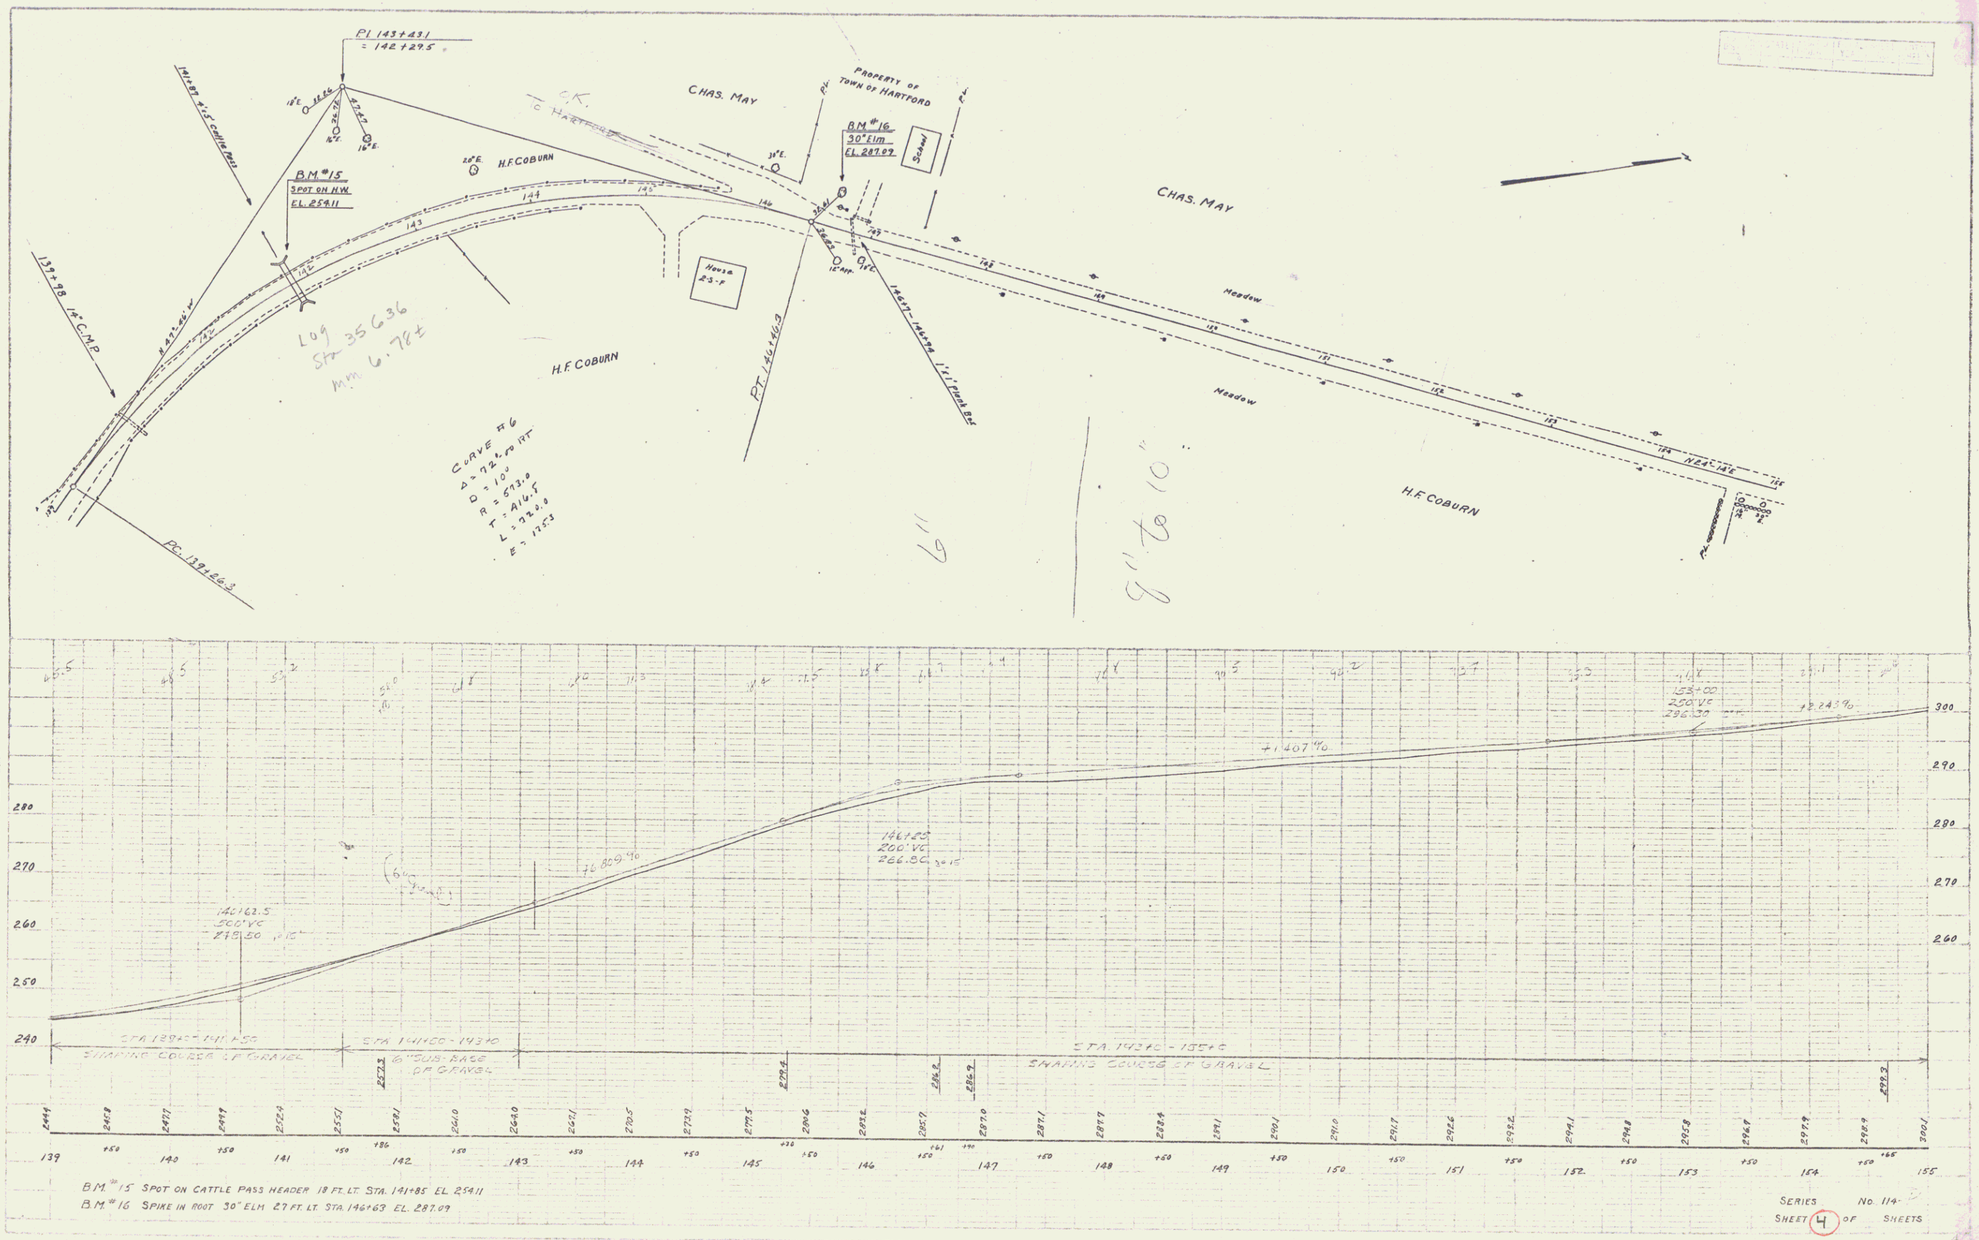

SERIES No. 114
SHEET 4 OF SHEETS

4