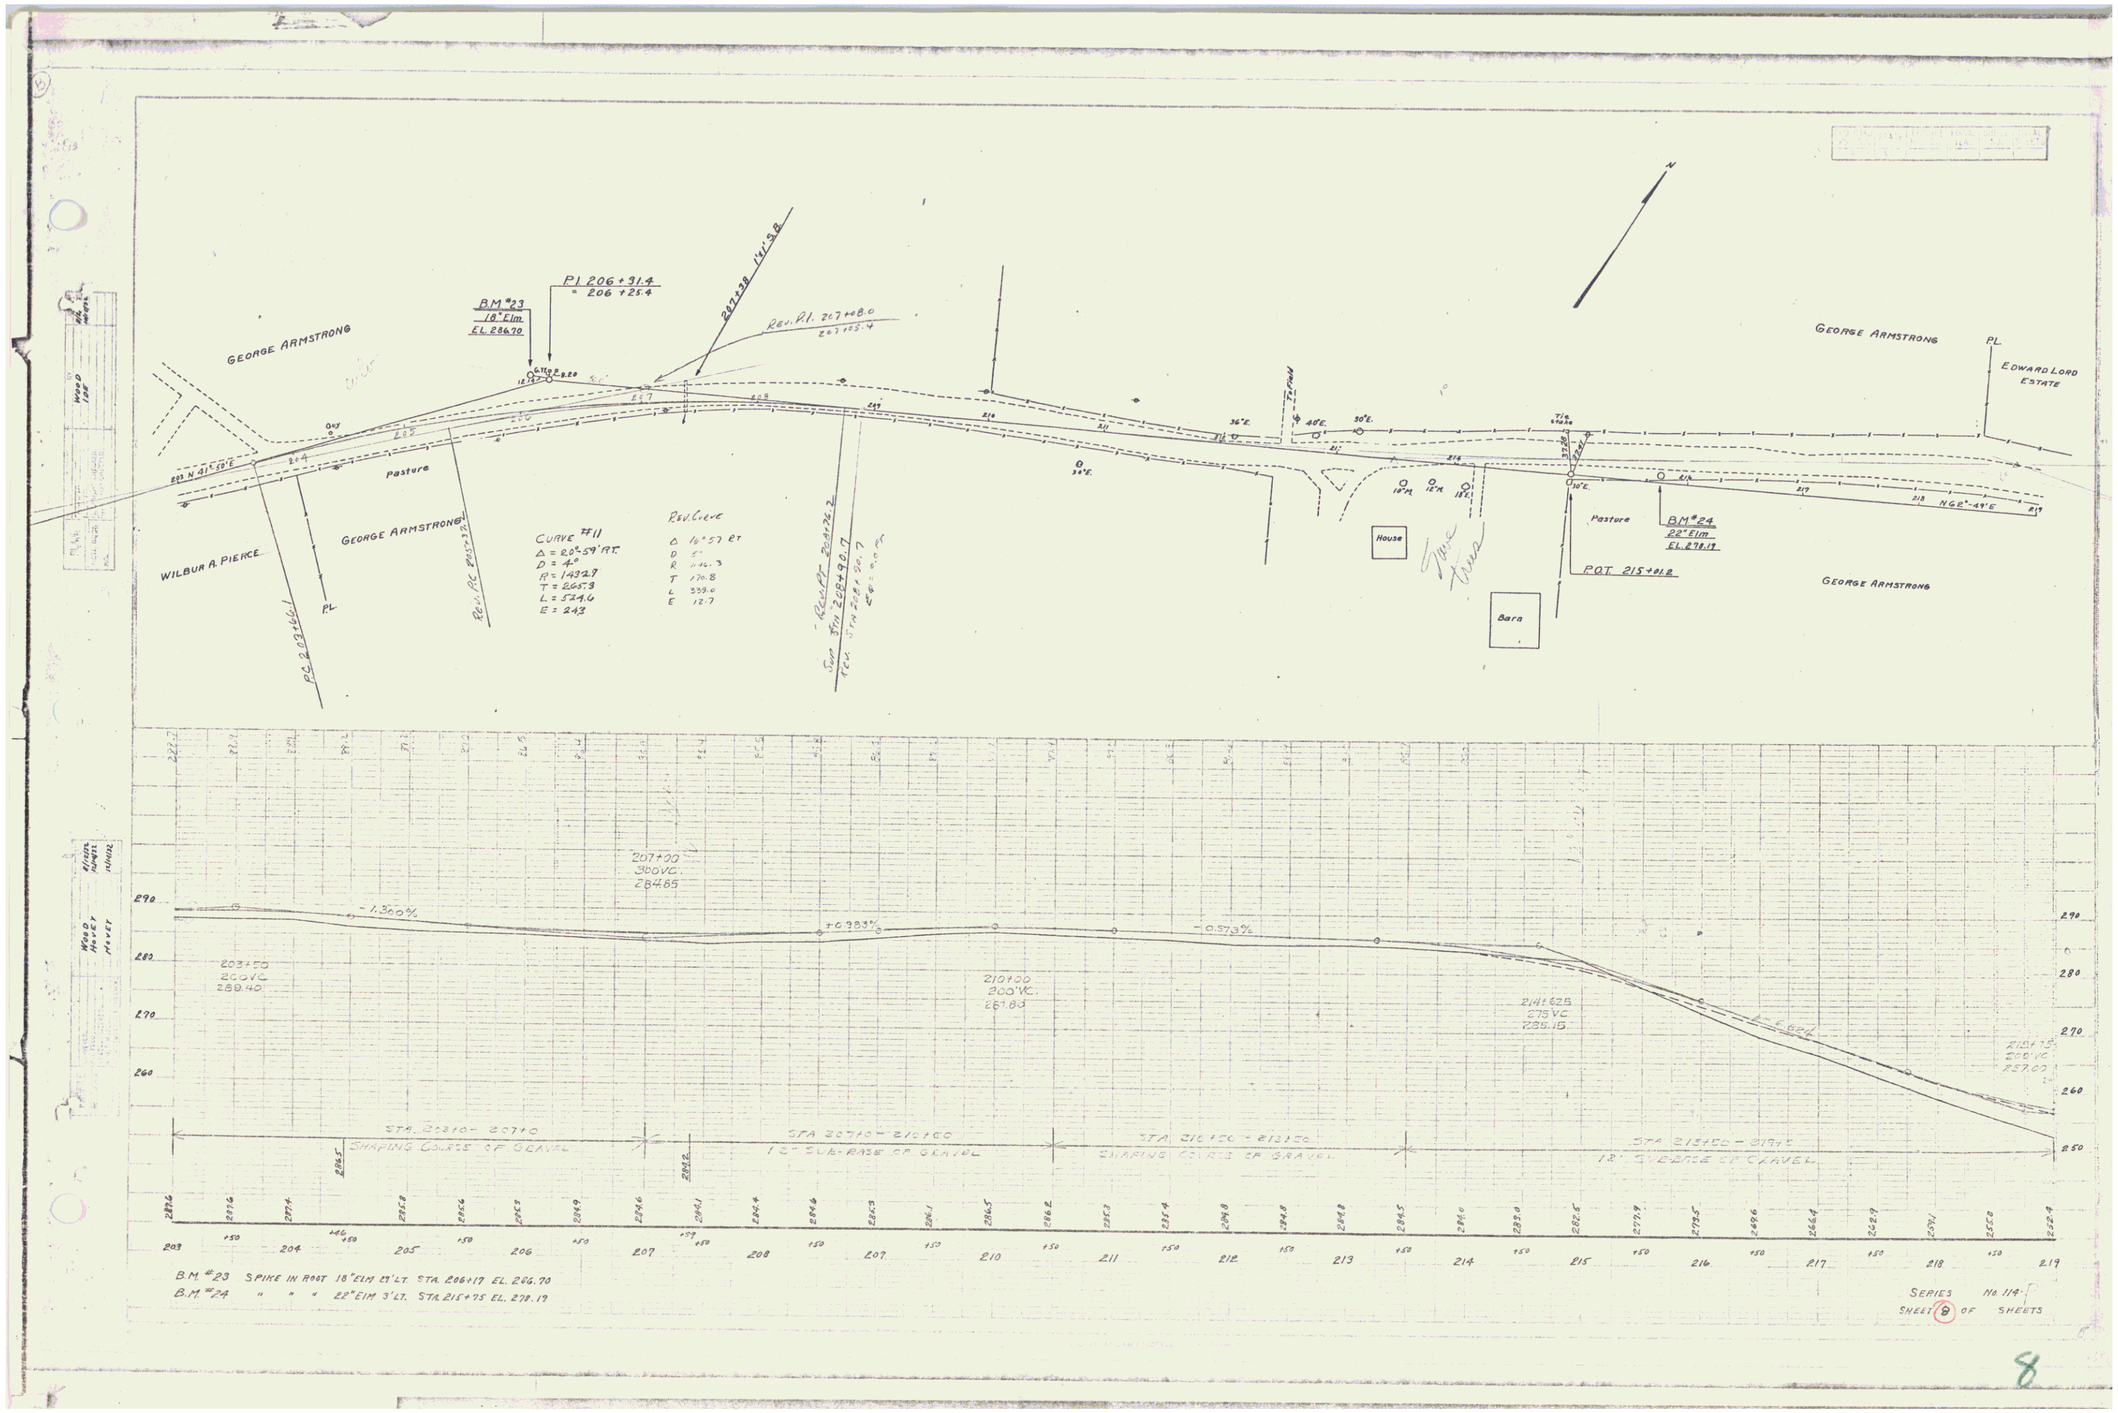
GEORGE ARMSTRONG
BM #23
18" Elm
EL 286.70
PI 206+31.4
= 206+25.4
267.238 14'1 S.B.
Rev. PI. 207+08.0
207+05.4
GEORGE ARMSTRONG
PL
EDWARD LORD ESTATE
203 N 41° 18' E
Pasture
WILBUR A. PIERCE
GEORGE ARMSTRONG
PL
Rev. PC 207+32
CURVE #11
Δ = 20° 59' RT.
D = 4°
R = 1432.7
T = 265.3
L = 524.6
E = 24.3
Rev. Curve
Δ 16° 57' RT
D 5°
R 1146.3
T 170.8
L 339.0
E 12.7
House
Barn
Pasture
BM #24
22" Elm
EL 278.19
POT 215+01.2
N 62° 49' E
GEORGE ARMSTRONG
207+00
300 VC
284.65
-1.360%
+0.983%
-0.573%
203+50
200 VC
289.40
210+00
200 VC
287.80
214+62.5
275 VC
285.15
215+62.5
200 VC
287.00
STA 203+50 - 207+0
SHAPING COURSE OF GRAVEL
STA 207+0 - 210+50
12" SUB-BASE OF GRAVEL
STA 210+50 - 213+50
SHAPING COURSE OF GRAVEL
STA 213+50 - 217+0
12" SUB-BASE OF GRAVEL
B.M. #23 SPIKE IN ROOT 18" ELM 23' LT. STA. 206+17 EL. 286.70
B.M. #24 " " " 22" ELM 3' LT. STA. 215+75 EL. 278.19
SERIES No 114
SHEET 8 OF SHEETS

8