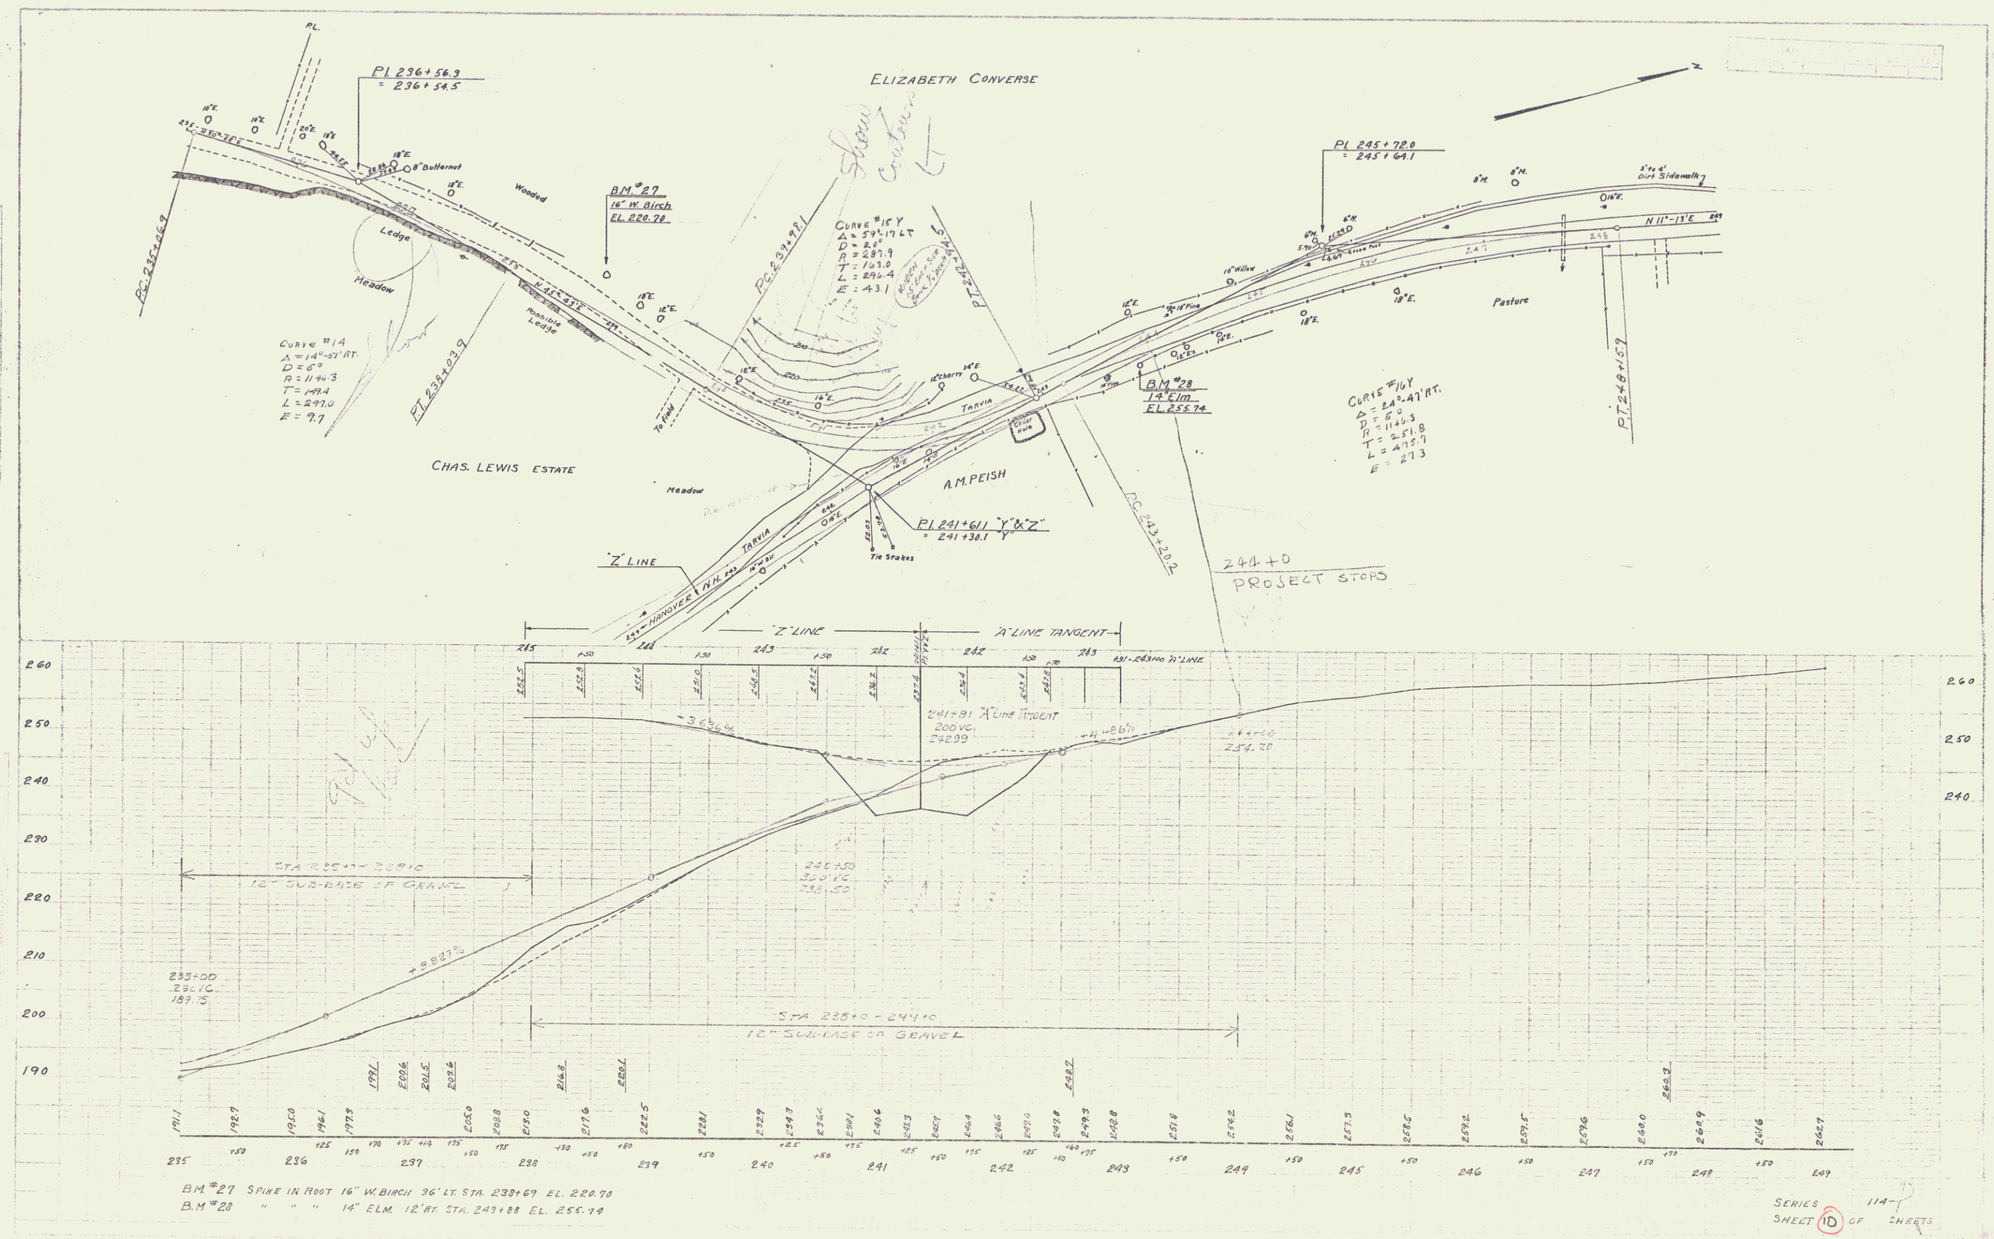
ELIZABETH CONVERSE
CHAS. LEWIS ESTATE
A.M. PEISH
PI 236+56.9
= 236+54.5
BM #27
16" W. Birch
EL. 220.70
BM #28
14" Elm
EL. 255.74
PI 245+72.0
= 245+64.1
PI 241+61.1 "Y" & "Z"
= 241+30.1 "Y"
PC 239+78.1
PC 243+20.2
PT 248+15.9
PT 238+03.9
PC 235+46.9
Curve #14
Δ = 14°-51' RT.
D = 6°
R = 1146.3
T = 149.4
L = 297.0
E = 9.7
Curve #15 Y
Δ = 59°-17' LT
D = 8°
R = 287.9
T = 163.0
L = 296.4
E = 43.1
Curve #16 Y
Δ = 24°-47' RT.
D = 5°
R = 1146.3
T = 251.8
L = 495.7
E = 27.3
Wooded
Meadow
Ledge
Possible Ledge
Pasture
Tarvia
Tie Stakes
"Z" LINE
"A" LINE TANGENT
244+0
PROJECT STOPS
241+81 "A" LINE TANGENT
200 VC.
24299
240+50
300 VC.
238.50
244+00
254.20
235+00
250 VC.
189.15
STA. 235+10 - 238+10
12" SUB-BASE OF GRAVEL
STA. 238+10 - 244+10
12" SUB-BASE OF GRAVEL
+3.66%
+8.827%
+4.86%
BM #27 SPIKE IN ROOT 16" W. BIRCH 36' LT. STA. 239+69 EL. 220.70
B.M #28 " " " 14" ELM 12' RT. STA. 243+88 EL. 255.74
SERIES 114
SHEET 10 OF SHEETS
13