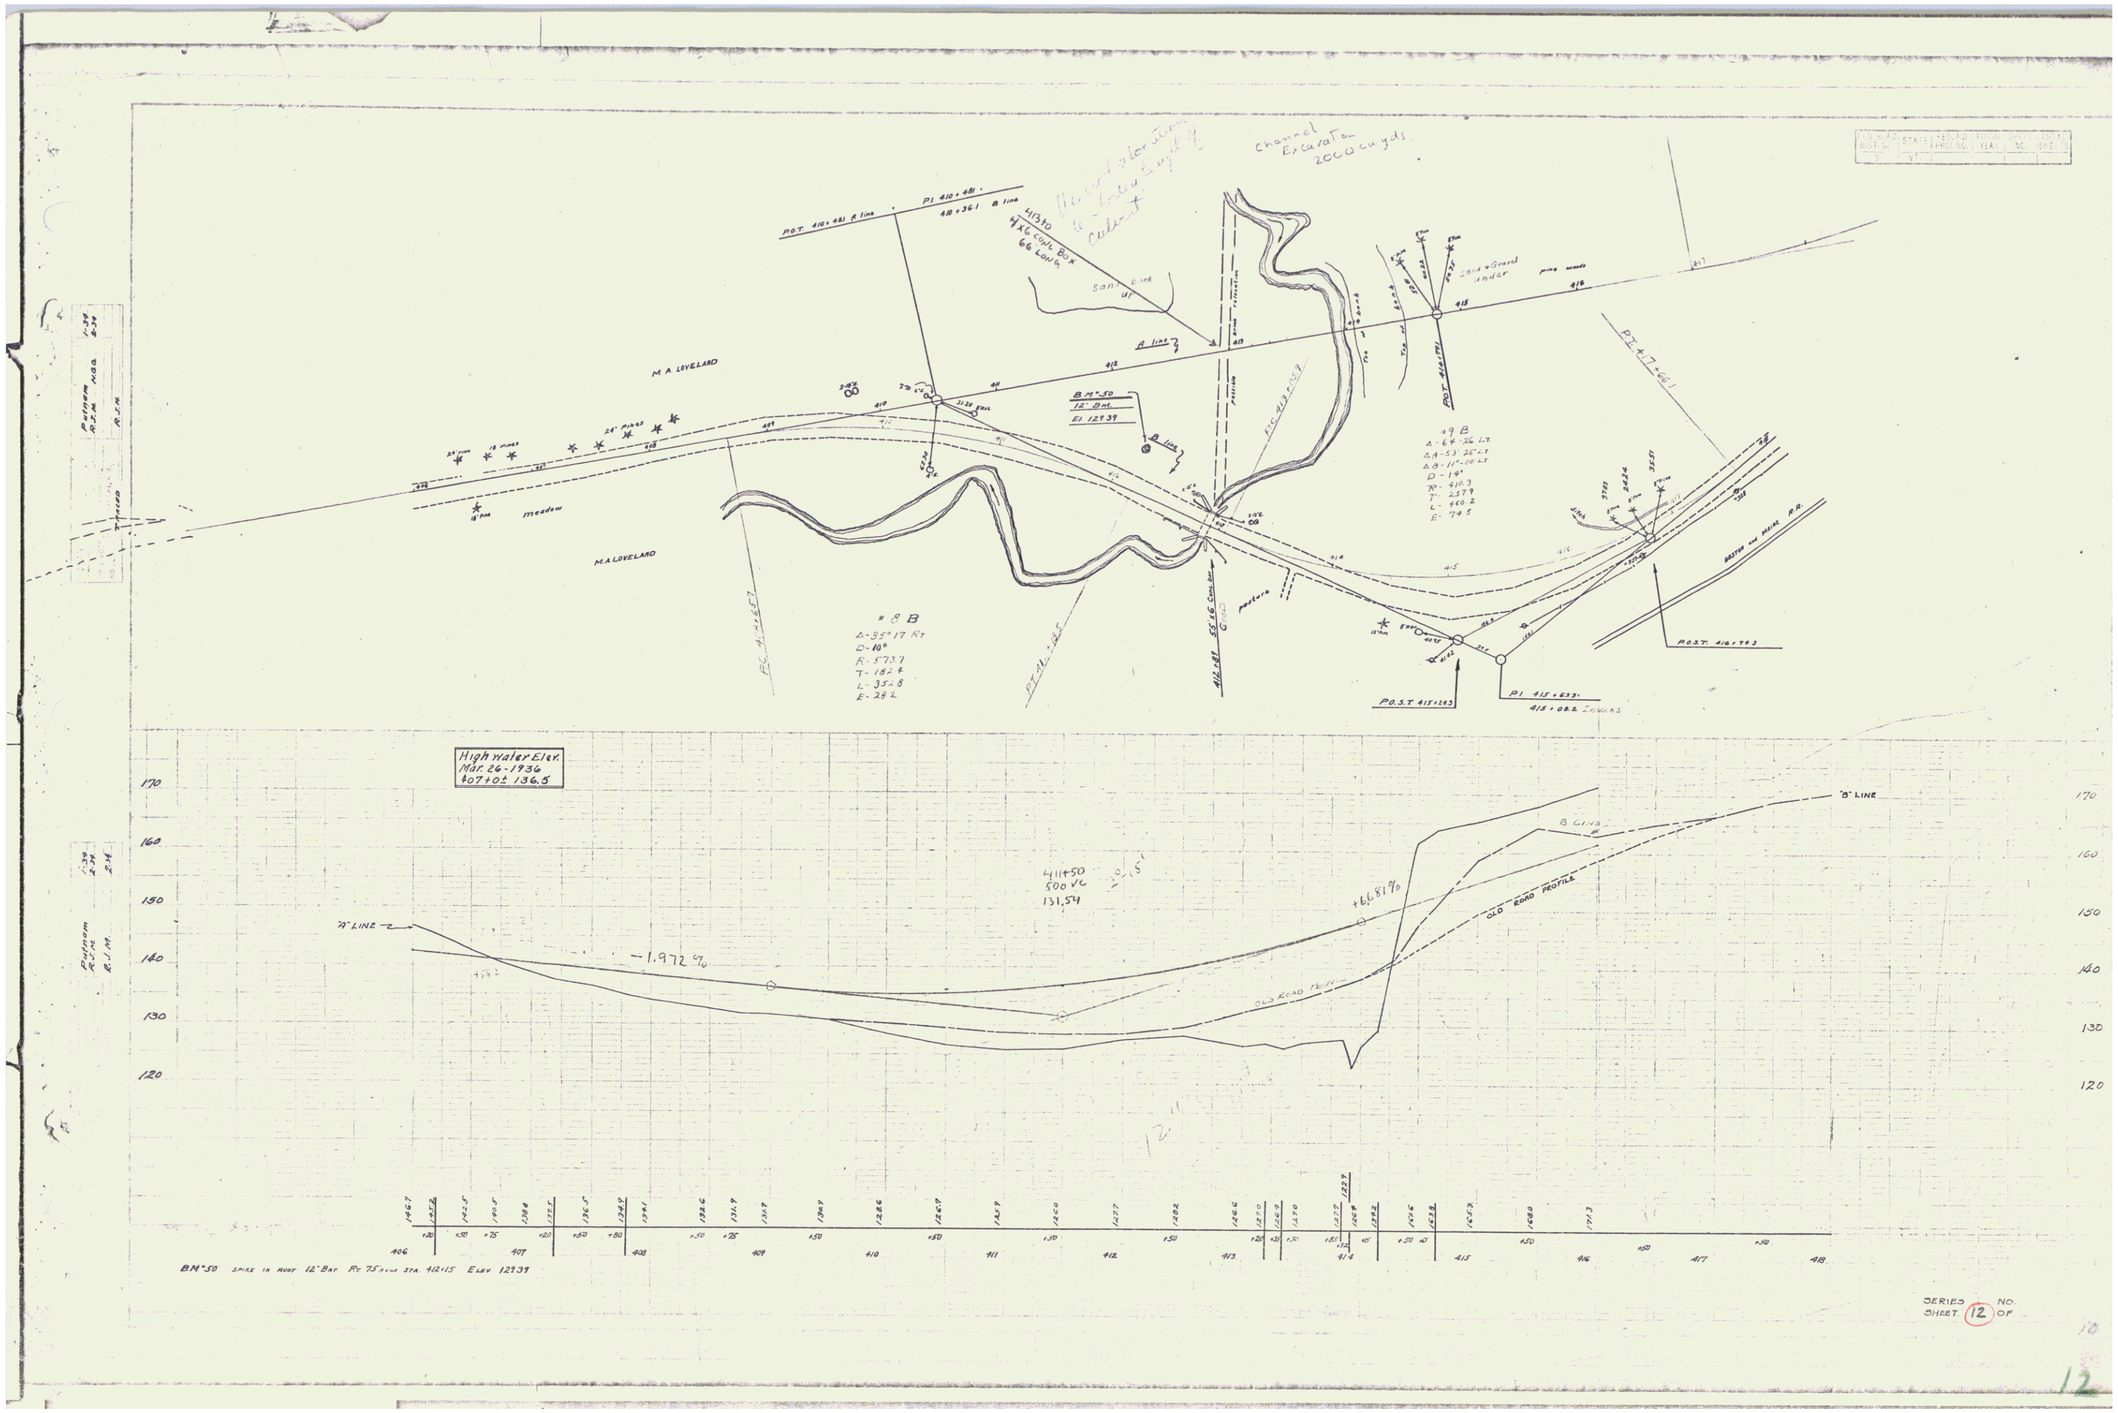

SERIES NO.
SHEET 12 OF

12