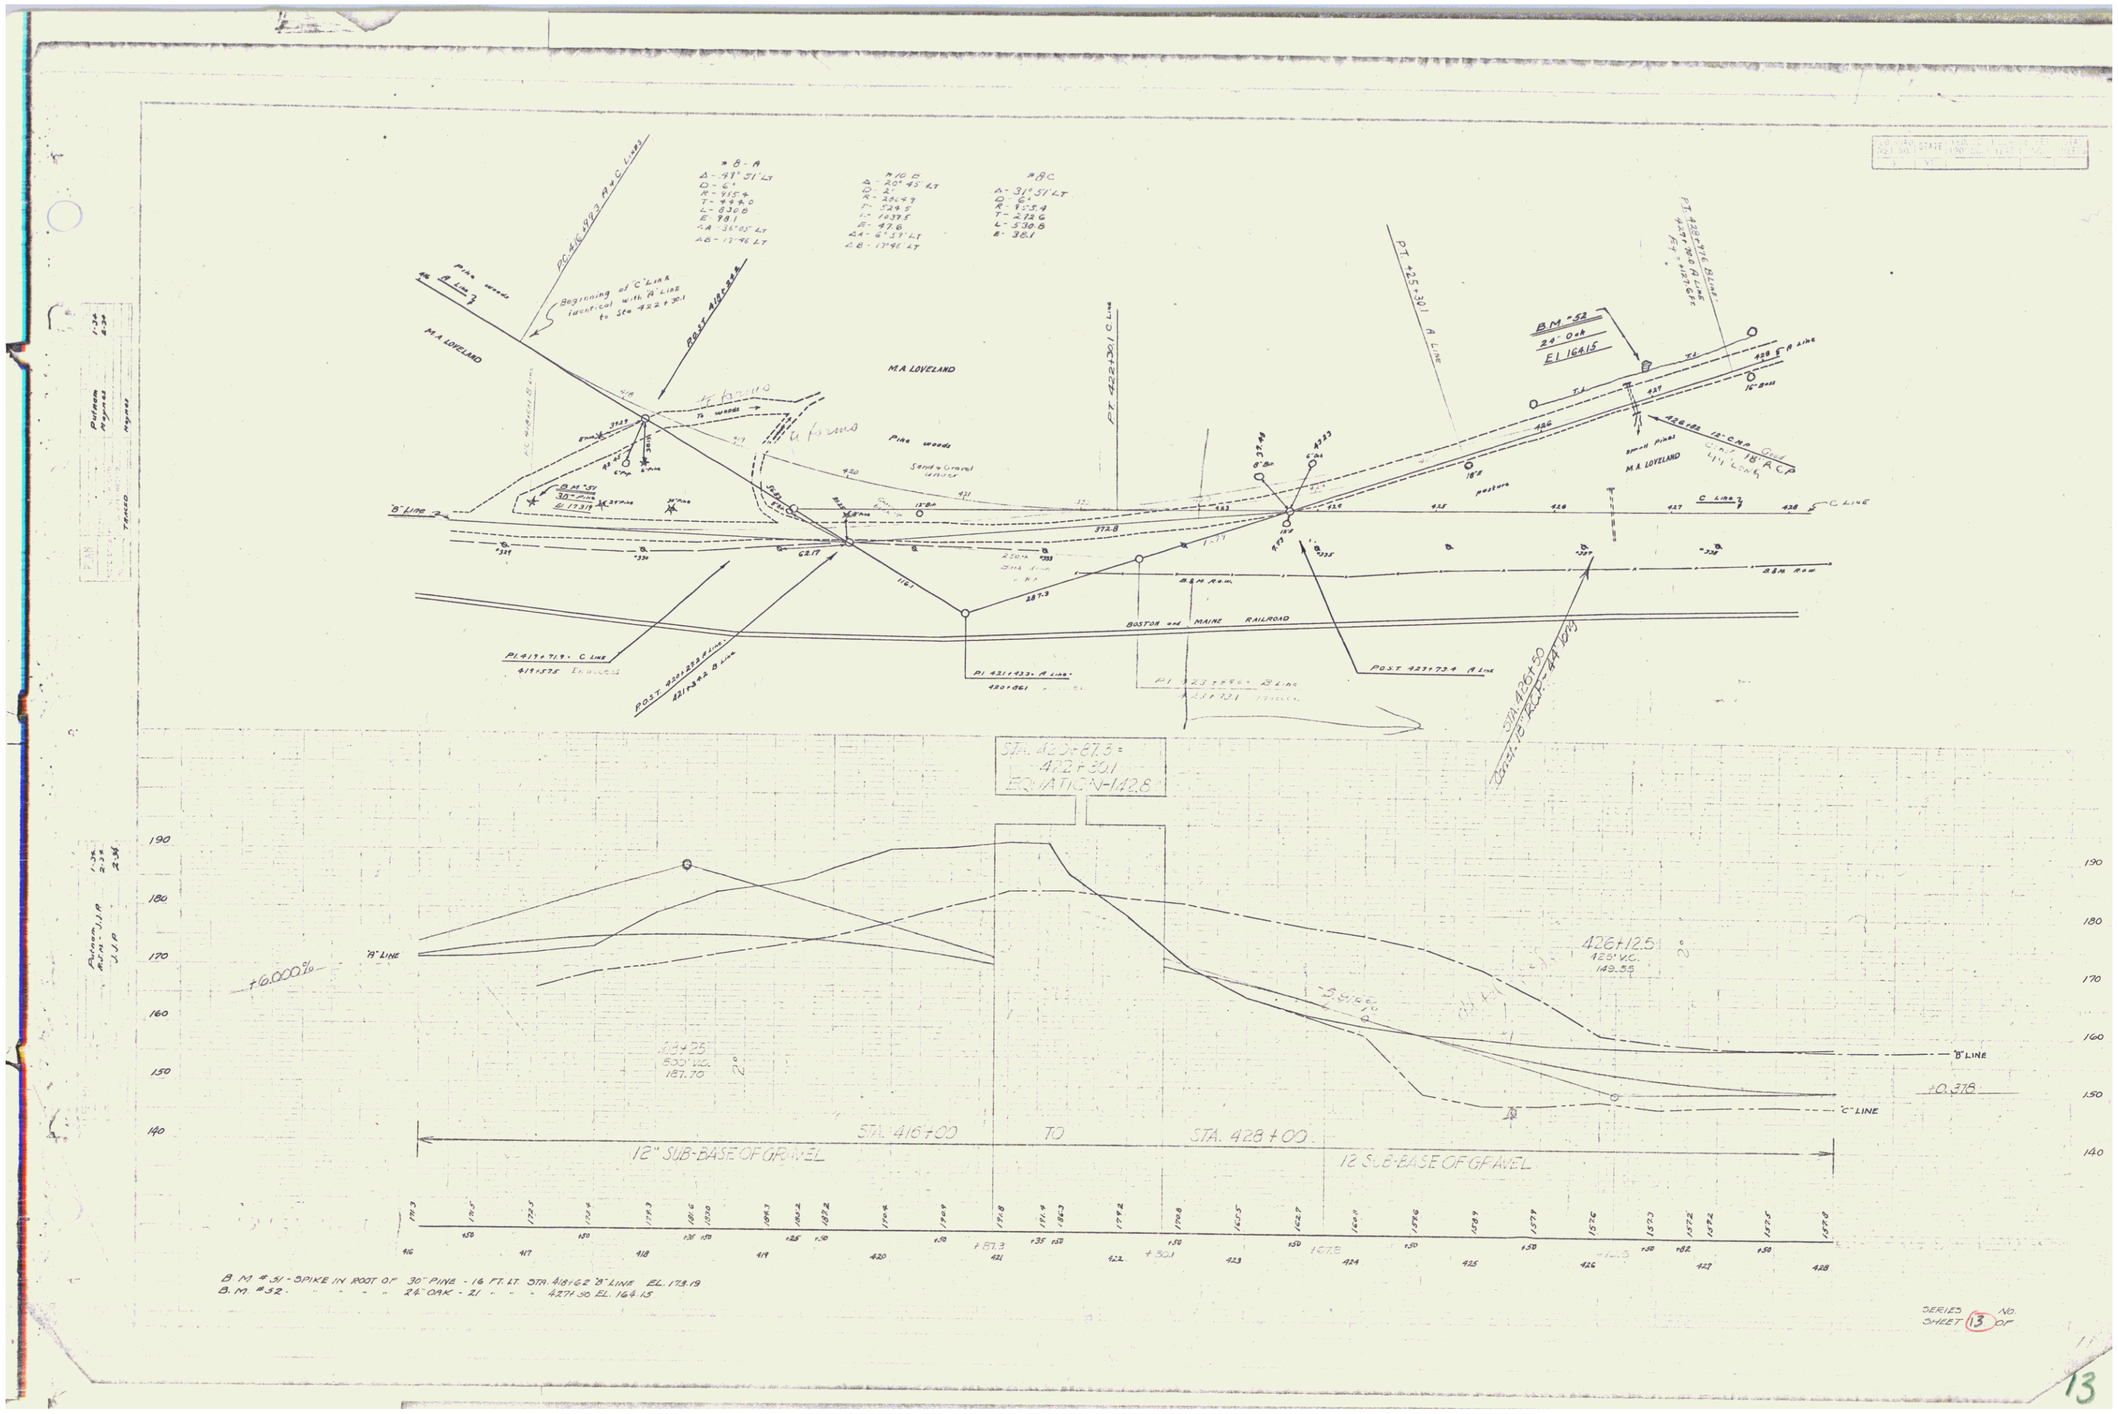
M.A. LOVELAND
Pine woods
Sand & Gravel deposit
BOSTON and MAINE RAILROAD
B&M R.O.W.
"B" LINE
"C" LINE
"A" LINE
BM #52
24" Oak
El 164.15
STA. 416+00 TO STA. 428+00
12" SUB-BASE OF GRAVEL
+6.000%
+0.37%
EQUATION-142.8
SERIES NO.
SHEET 13 OF

13