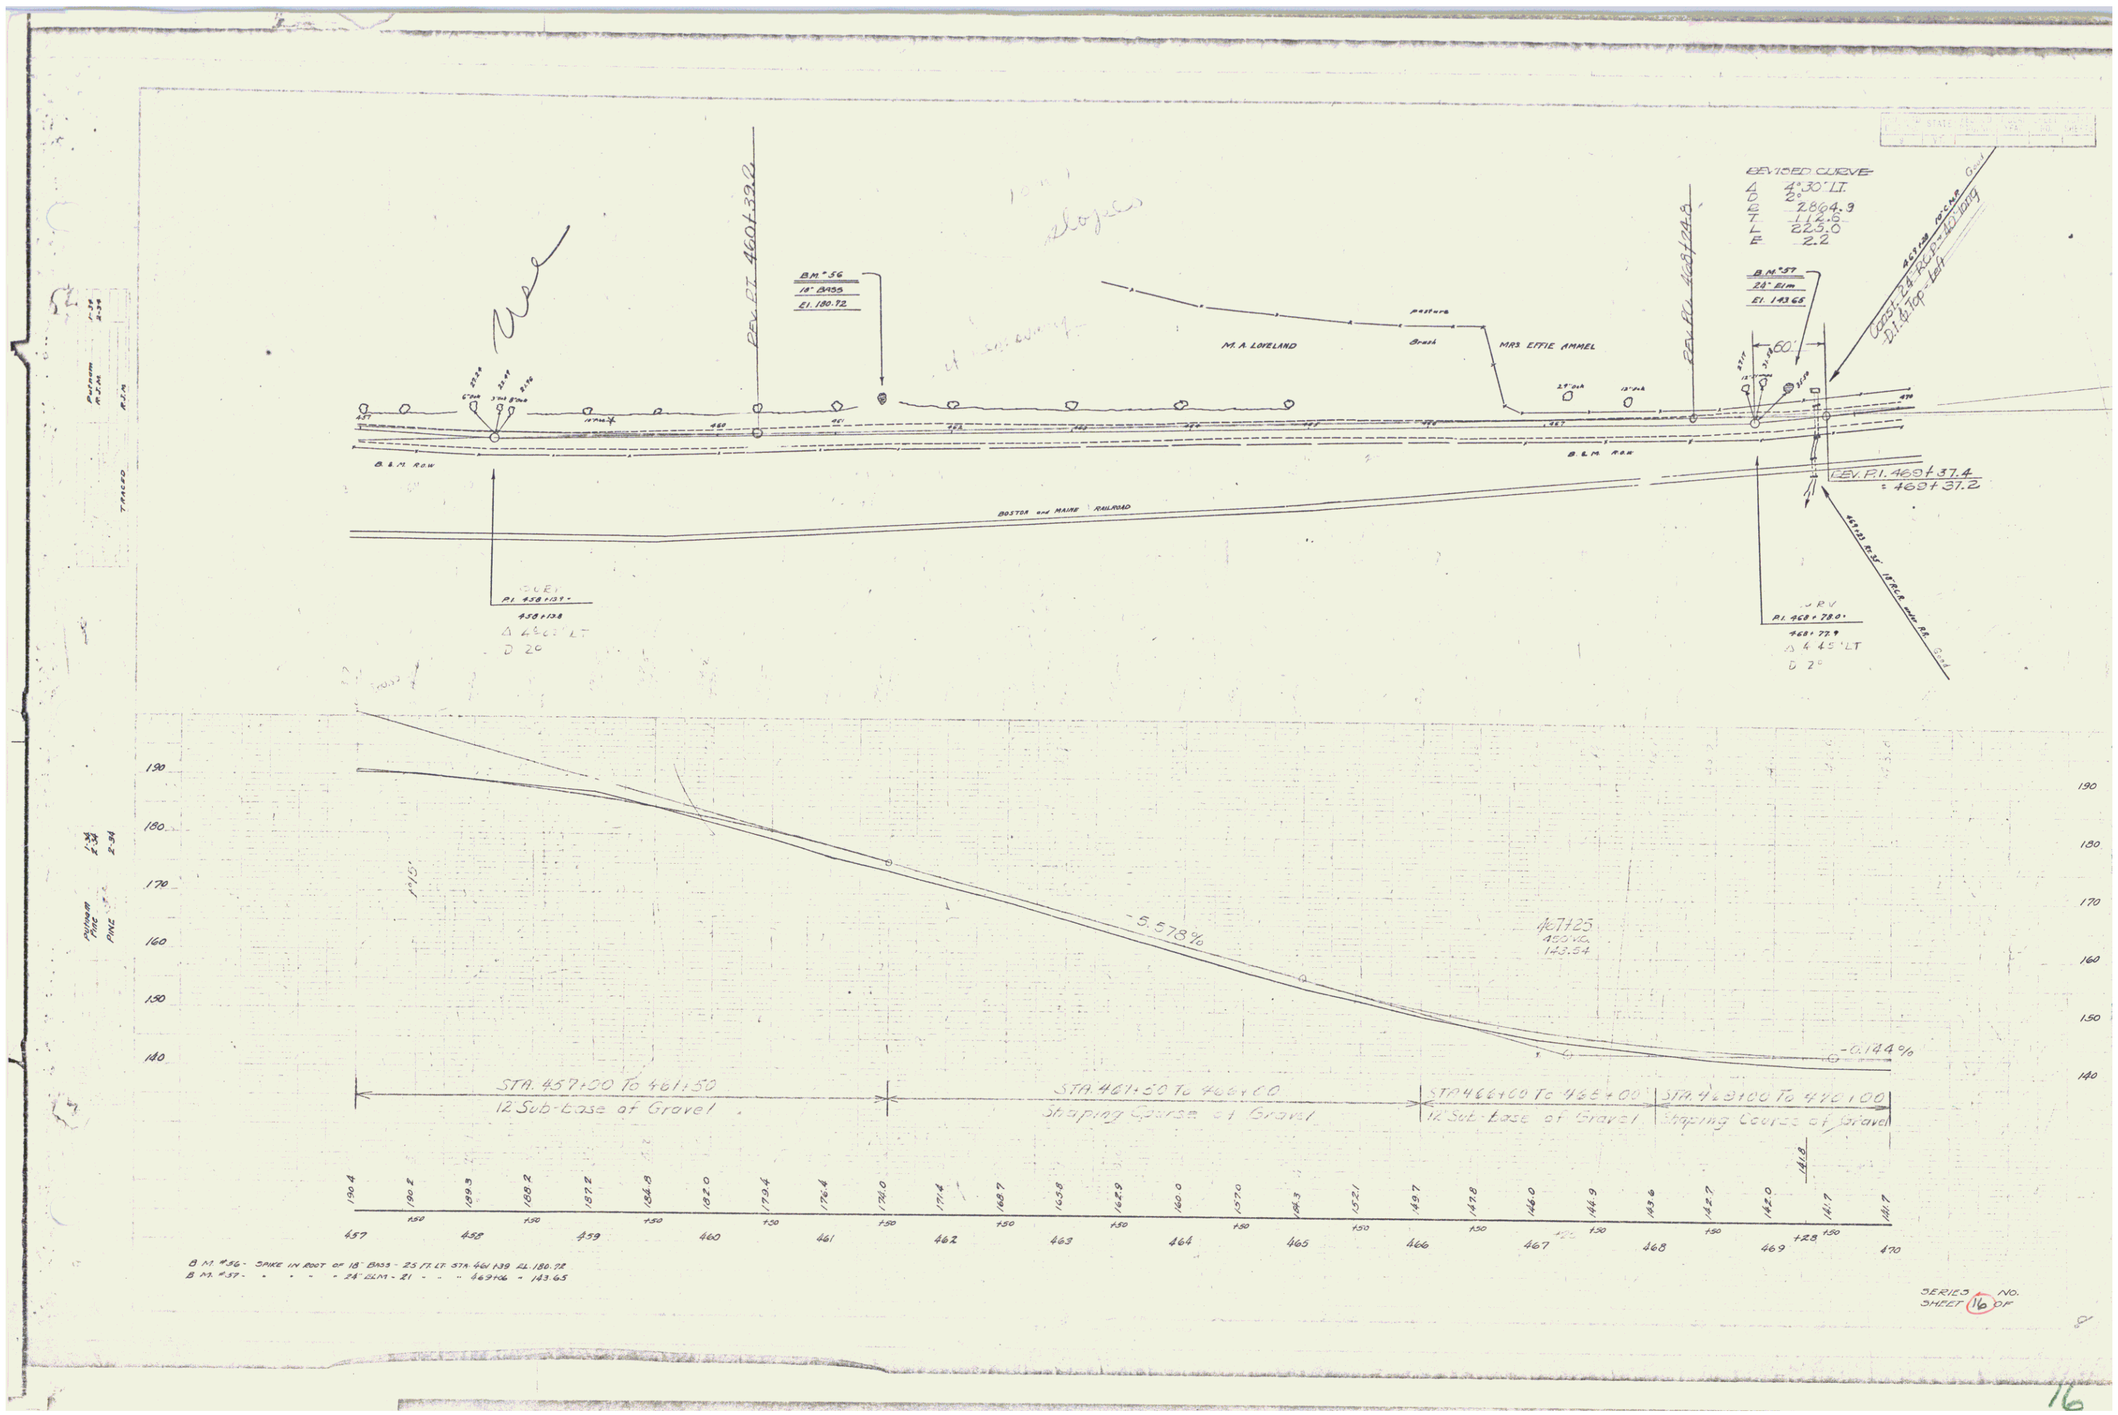
REVISED CURVE
Δ 4°30' LT
D 2°
E 2864.9
T 128.6
L 225.0
E 2.2
B.M. #56
18" BASS
El. 180.72
B.M. #57
24" ELM
El. 143.65
M. A. LOVELAND
MRS EFFIE AMMEL
B & M R.R.
BOSTON and MAINE RAILROAD
-5.578%
-0.144%
STA. 457+00 To 461+50
12 Sub-base of Gravel
STA. 461+50 To 466+00
Staging Course of Gravel
STA. 466+00 To 468+00
12 Sub-base of Gravel
STA. 468+00 To 470+00
Staging Course of Gravel
B.M. #56 - SPIKE IN ROOT OF 18" BASS - 25' FT. LT. STA. 461+39 EL. 180.72
B.M. #57 - " " " - 24" ELM - 21' " " " 469+06 - 143.65
SERIES NO.
SHEET 16 OF

16