Parcel	Kind of Instrument	Date of Instrument	Grantor	Grantee	Recorded Norwich Book	Page	Remarks
A	Q.C.D.	9-1936	Chas. S. & Susan H. Ladd	St. of Vt.	2	145-6-7	10-15-36
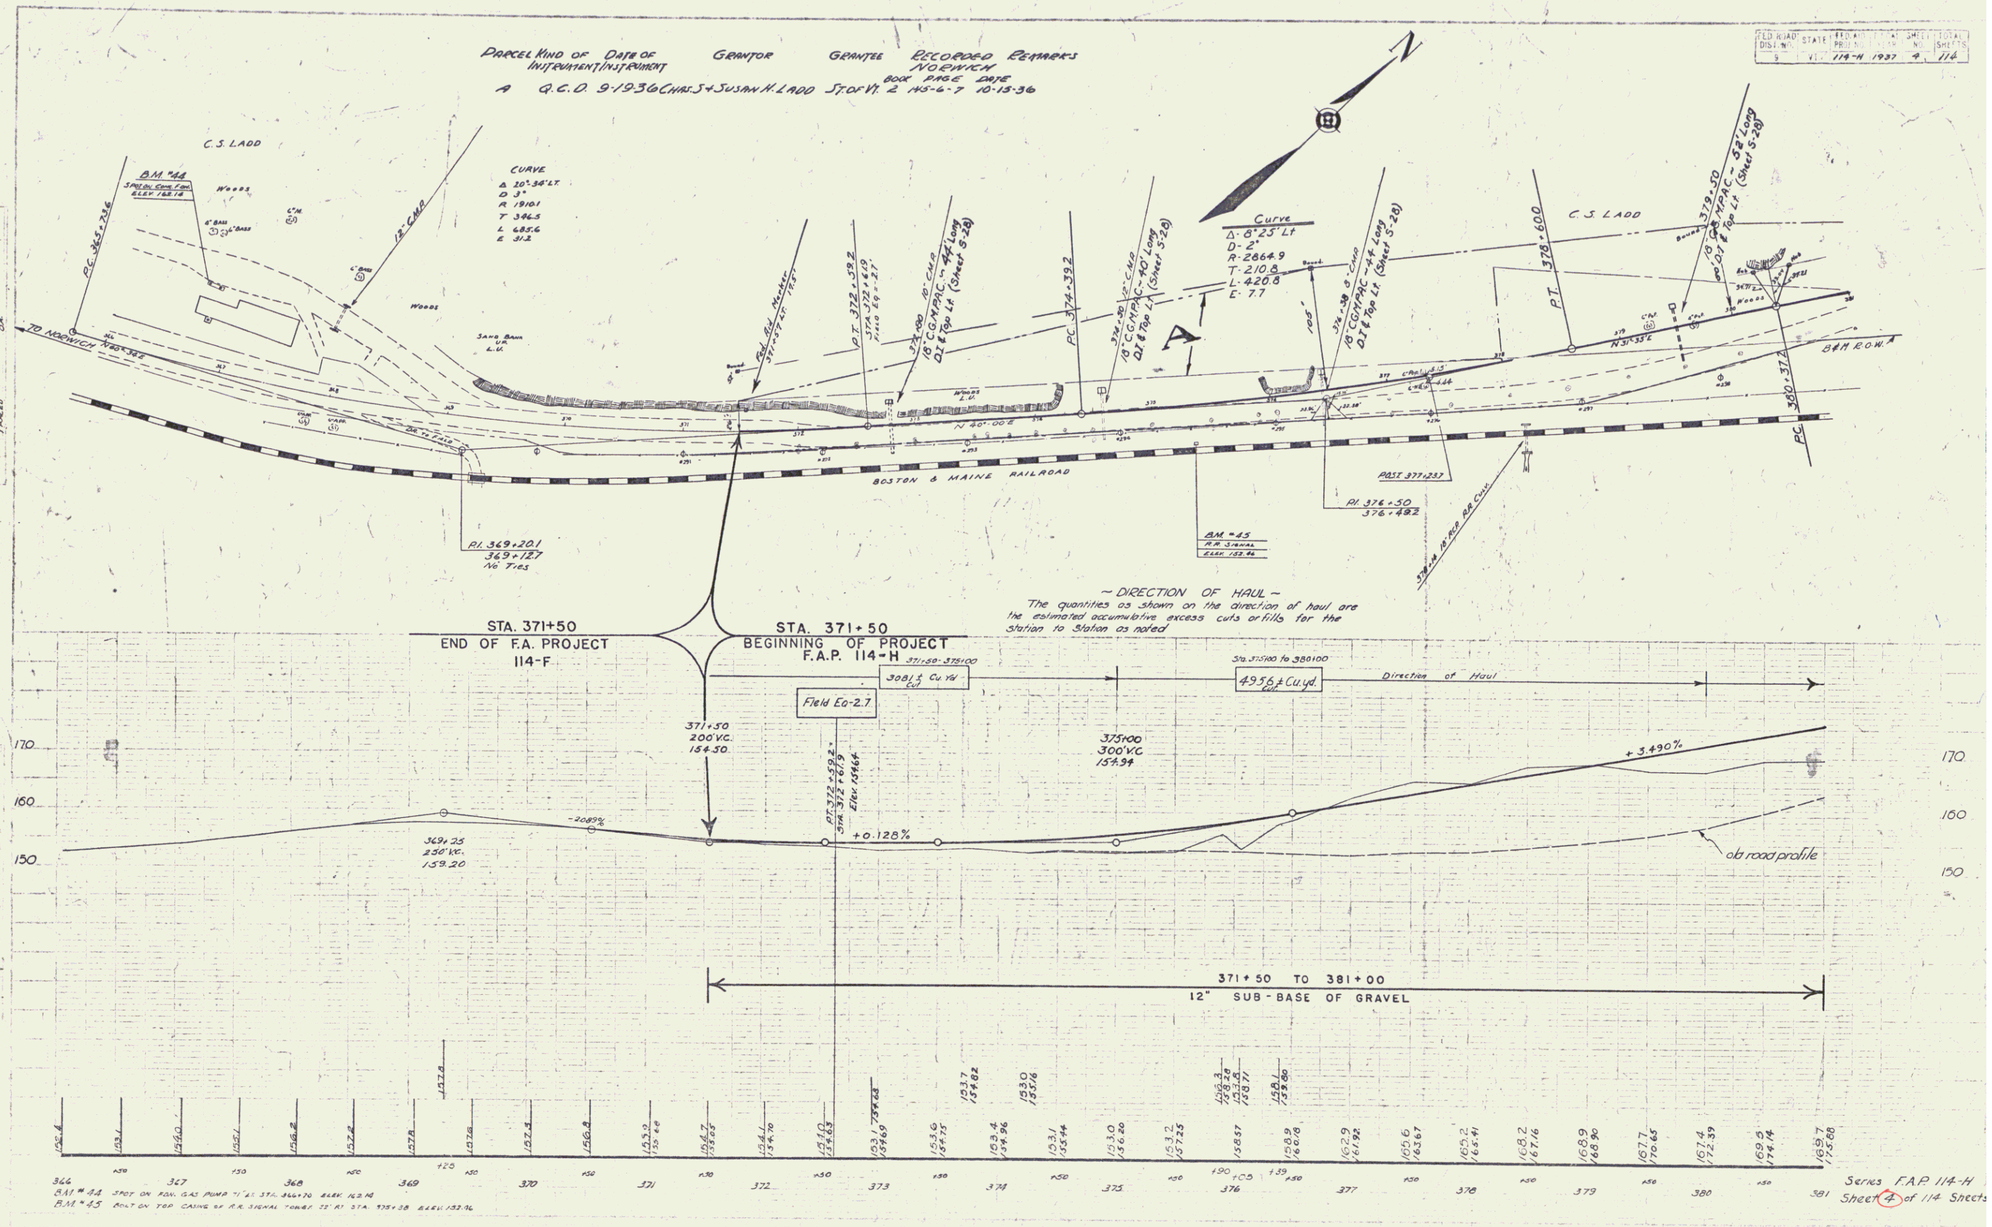
Field Road Dist. No.	State	Federal Project No.	Total Sheets	Sheet No.	Total Sheets
5	Vt.	114-H 1937	4	114