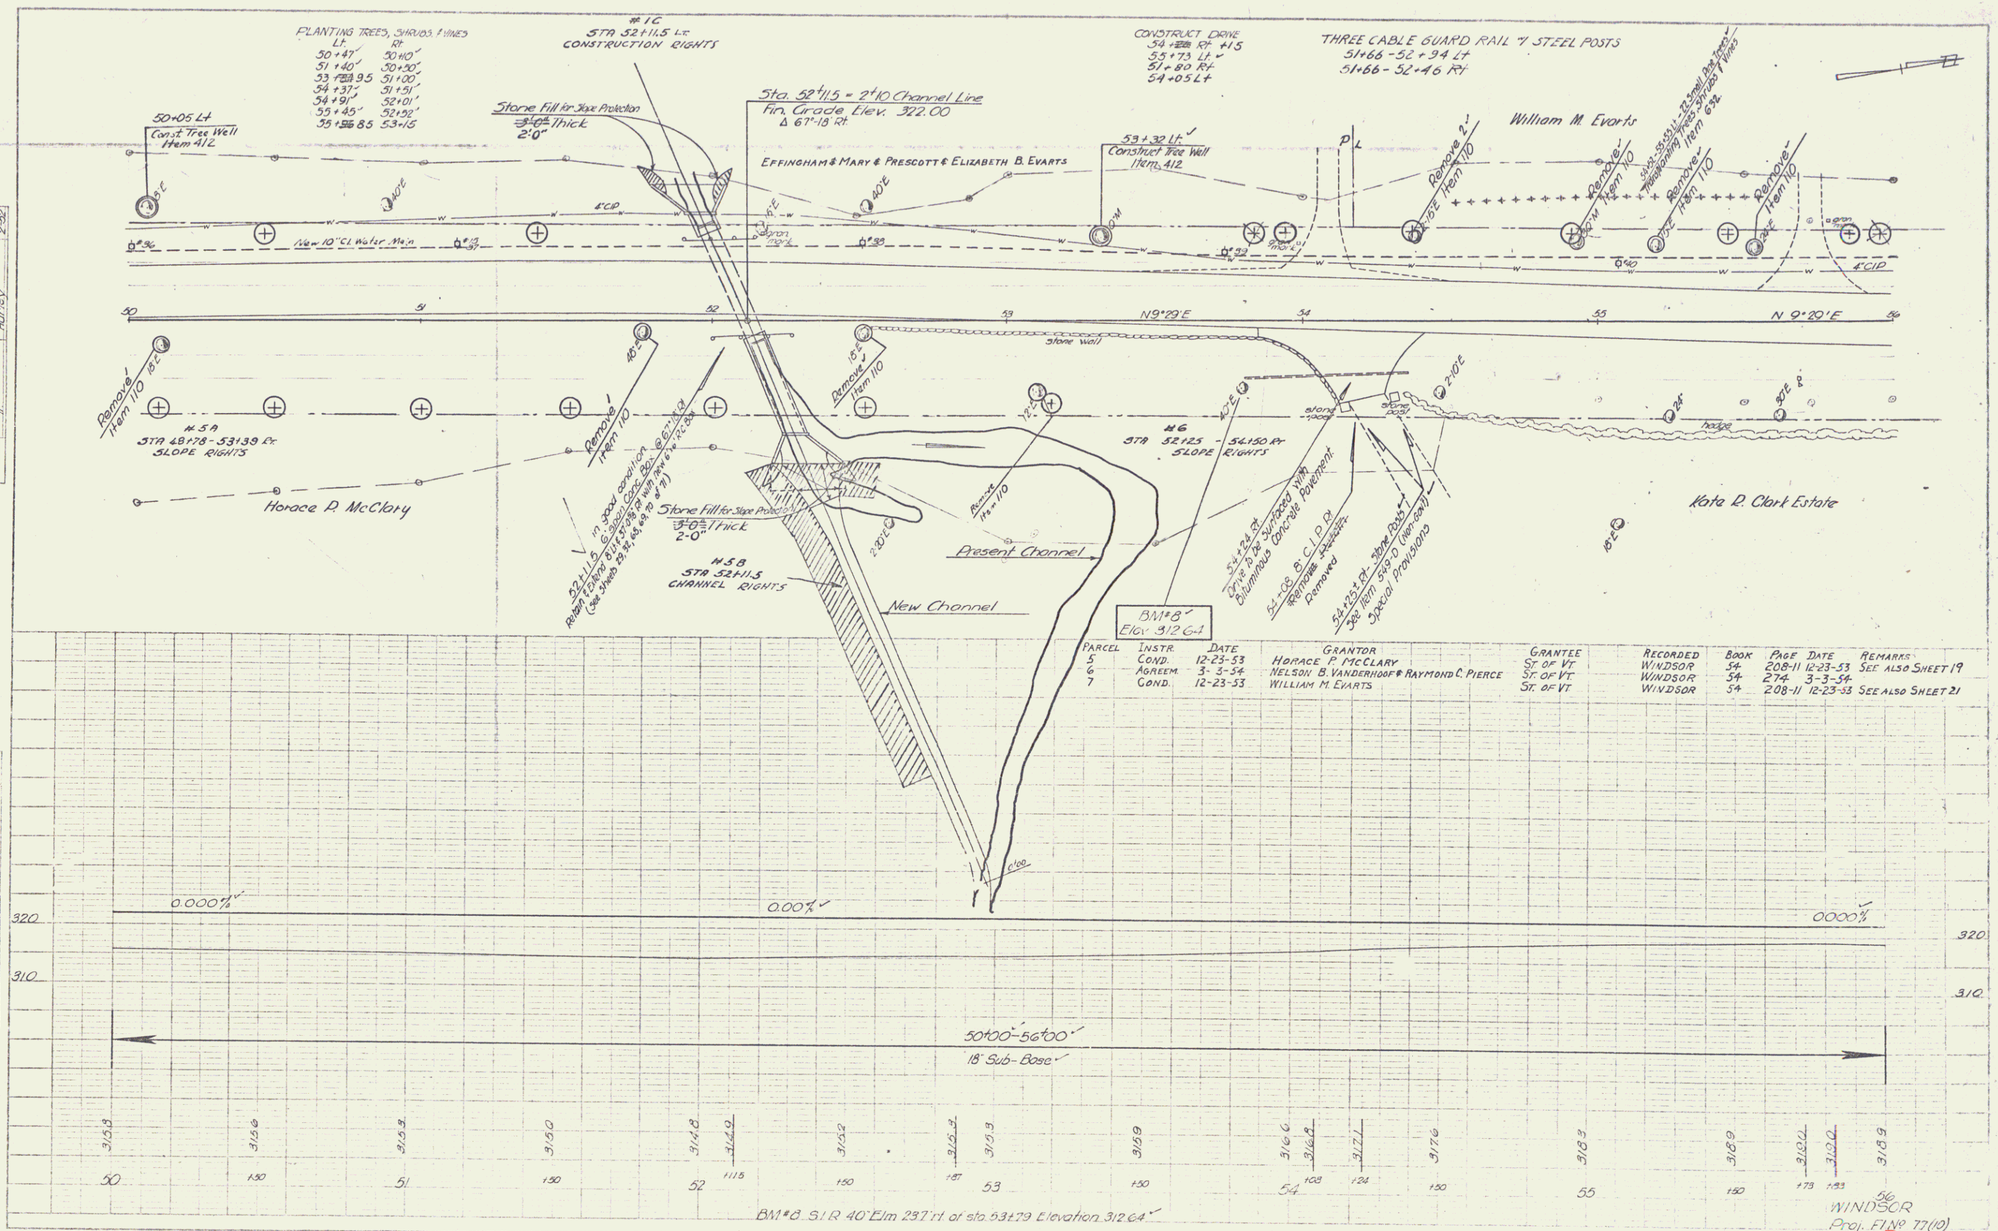

PARCEL	INSTR.	DATE	GRANTOR	GRANTEE	RECORDED	BOOK	PAGE	DATE	REMARKS
5	COND.	12-23-53	HORACE P. McCLARY	ST. OF VT.	WINDSOR	54	208-11	12-23-53	SEE ALSO SHEET 19
6	AGREEM.	3-3-54	NELSON B. VANDERHOOF & RAYMOND C. PIERCE	ST. OF VT.	WINDSOR	54	274	3-3-54	
7	COND.	12-23-53	WILLIAM M. EVARTS	ST. OF VT.	WINDSOR	54	208-11	12-23-53	SEE ALSO SHEET 21

PLAN — Drawn by M. Bliss; Traced by M. Bliss; Checked by Hurley; Date 2-58

PROFILE — Drawn by M. Bliss; Traced by M. Bliss; Checked by M. Bliss; Date 8-58

WINDSOR
Proj. F1 No 77(10)
Sheet 20 of 71

3