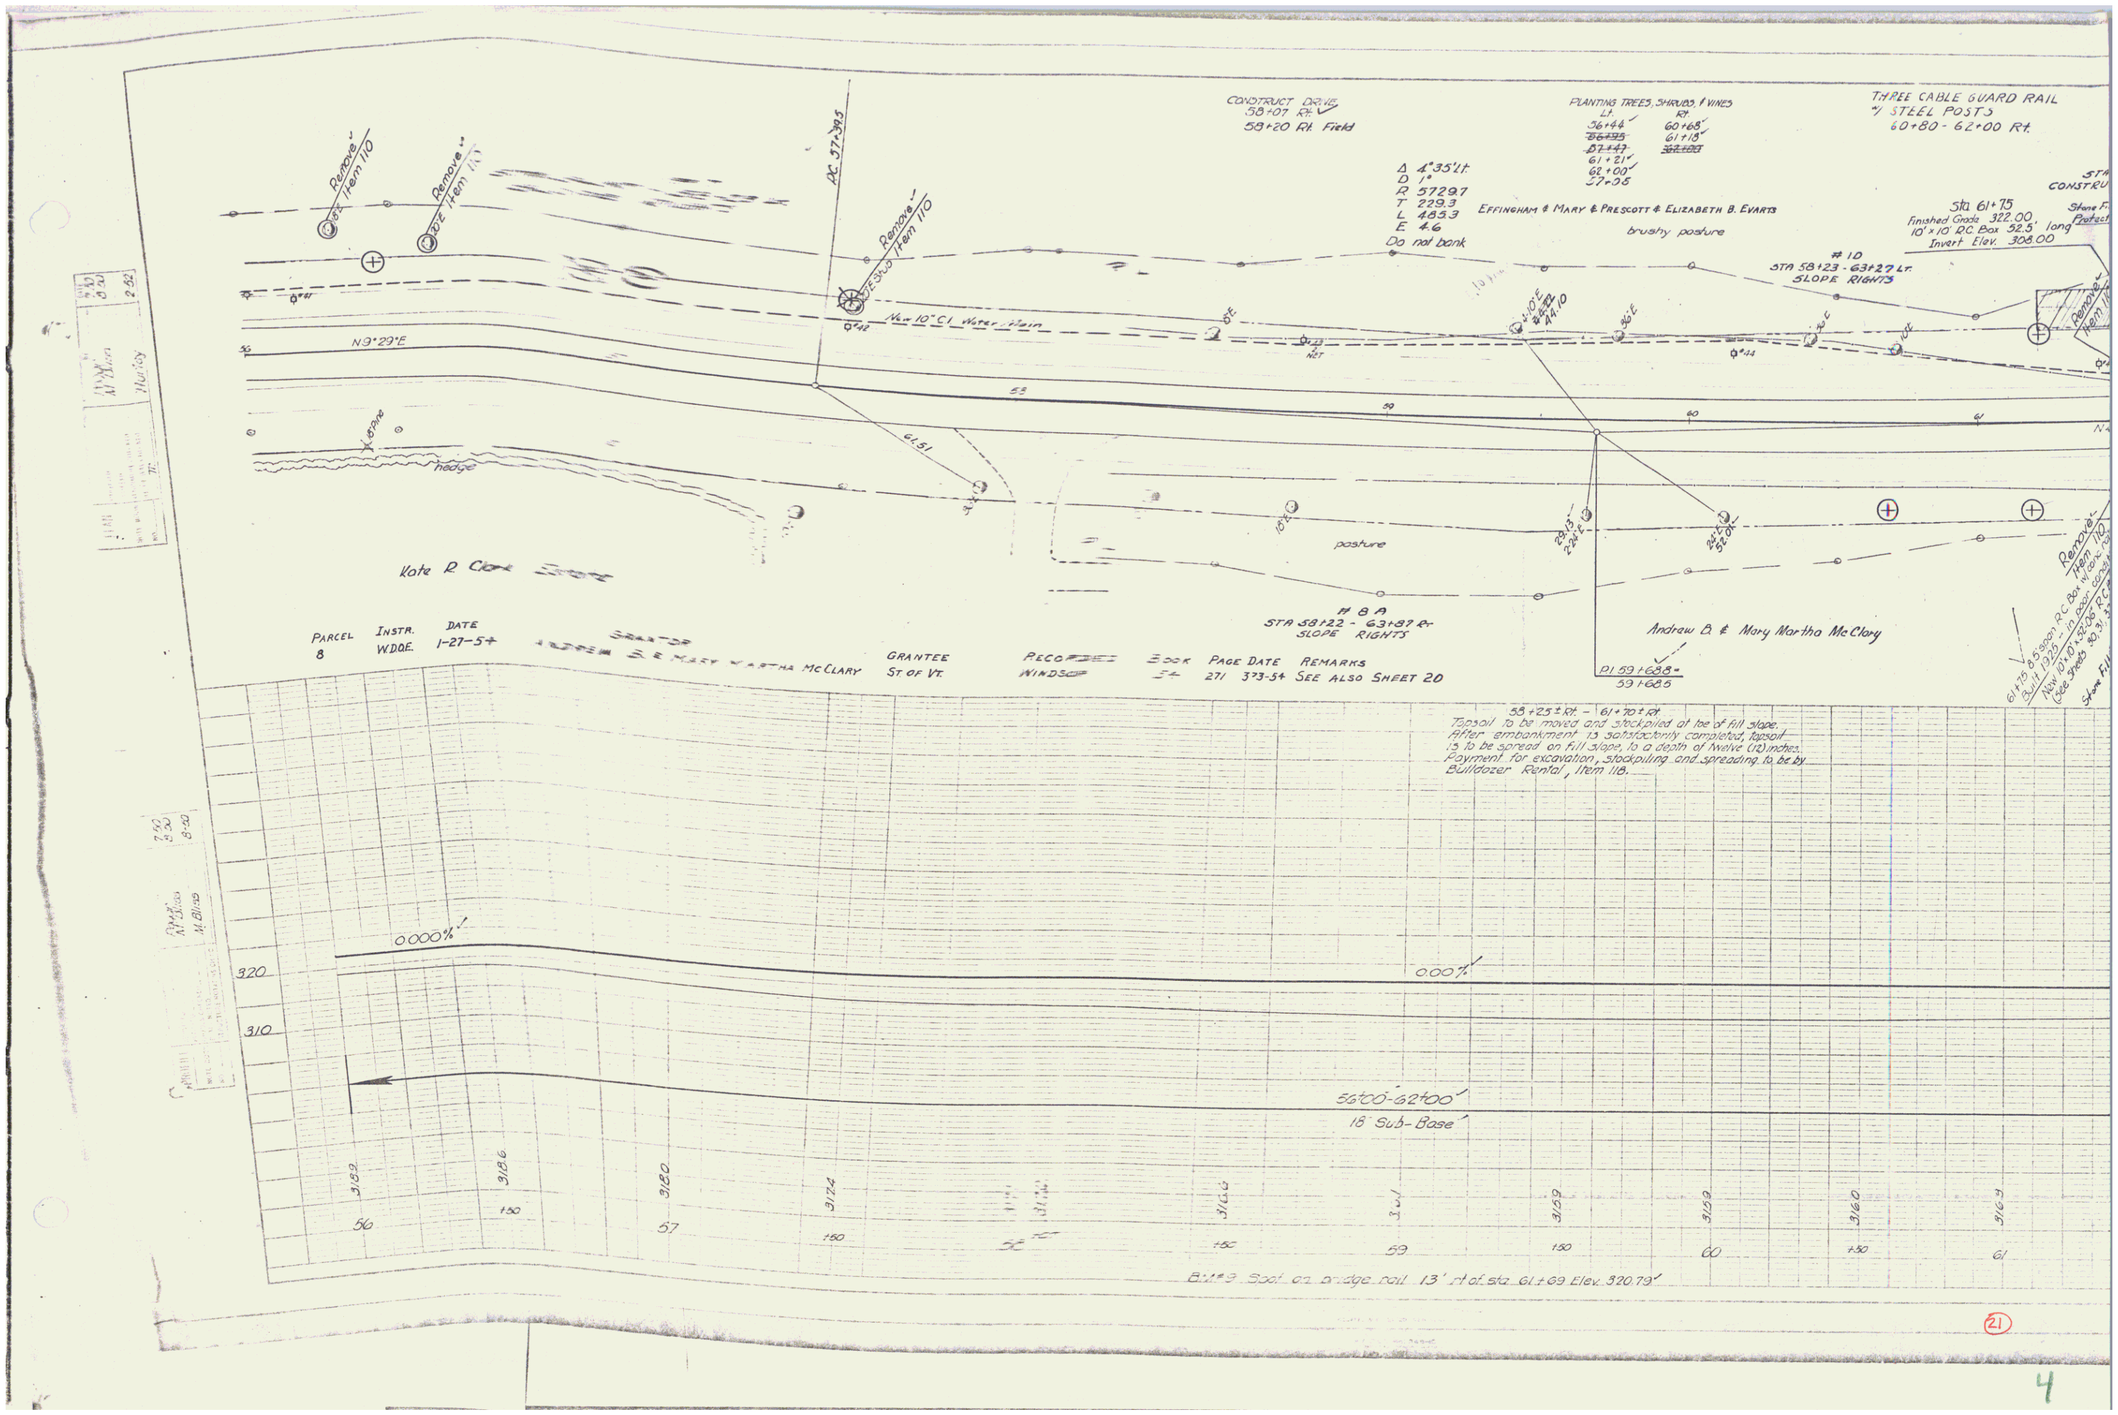
CONSTRUCT DRIVE
58+07 Rt.
58+20 Rt. Field
PLANTING TREES, SHRUBS, & VINES
Lt.
36+44
37+47
61+21
62+00
57+35
Rt.
60+68
61+18
THREE CABLE GUARD RAIL
W/ STEEL POSTS
60+80 - 62+00 Rt.
Δ 4°35' Lt.
D 1°
R 5729.7
T 229.3
L 458.3
E 4.6
Do not bank
EFFINGHAM & MARY & PRESCOTT & ELIZABETH B. EVARTS
brushy pasture
Sta. 61+75
Finished Grade 322.00
10' x 10' RC Box 52.5' long
Invert Elev. 308.00
10
STA 58+23 - 63+27 Lt.
SLOPE RIGHTS
Remove Item 110
AC 57+34.5
New 10" CI Water Main
hedge
Kate R. Clark
pasture
8A
STA 58+22 - 63+87 Rt.
SLOPE RIGHTS
Andrew B. & Mary Martha McClary
PI 59+68.8
59+68.5
61+75 8.5' span RC Box Culvert
Stone Fill
PARCEL 8
INSTR. W.D.O.E.
DATE 1-27-54
GRANTOR
ANDREW B. & MARY MARTHA McCLARY
GRANTEE St. of Vt.
RECORDED WINDSOR
BOOK 271
PAGE 373-54
DATE
REMARKS SEE ALSO SHEET 20
58+25 ± Rt. - 61+70 ± Rt.
Topsoil to be moved and stockpiled at toe of fill slope.
After embankment is satisfactorily completed, topsoil is to be spread on fill slope, to a depth of twelve (12) inches.
Payment for excavation, stockpiling and spreading to be by Bulldozer Rental, Item 118.
0.000%
0.00%
56+00-62+00
18' Sub-Base
320
310
56
57
58
59
60
61
Bench Spot on bridge rail 13' N of sta. 61+69 Elev. 320.79'
21
4