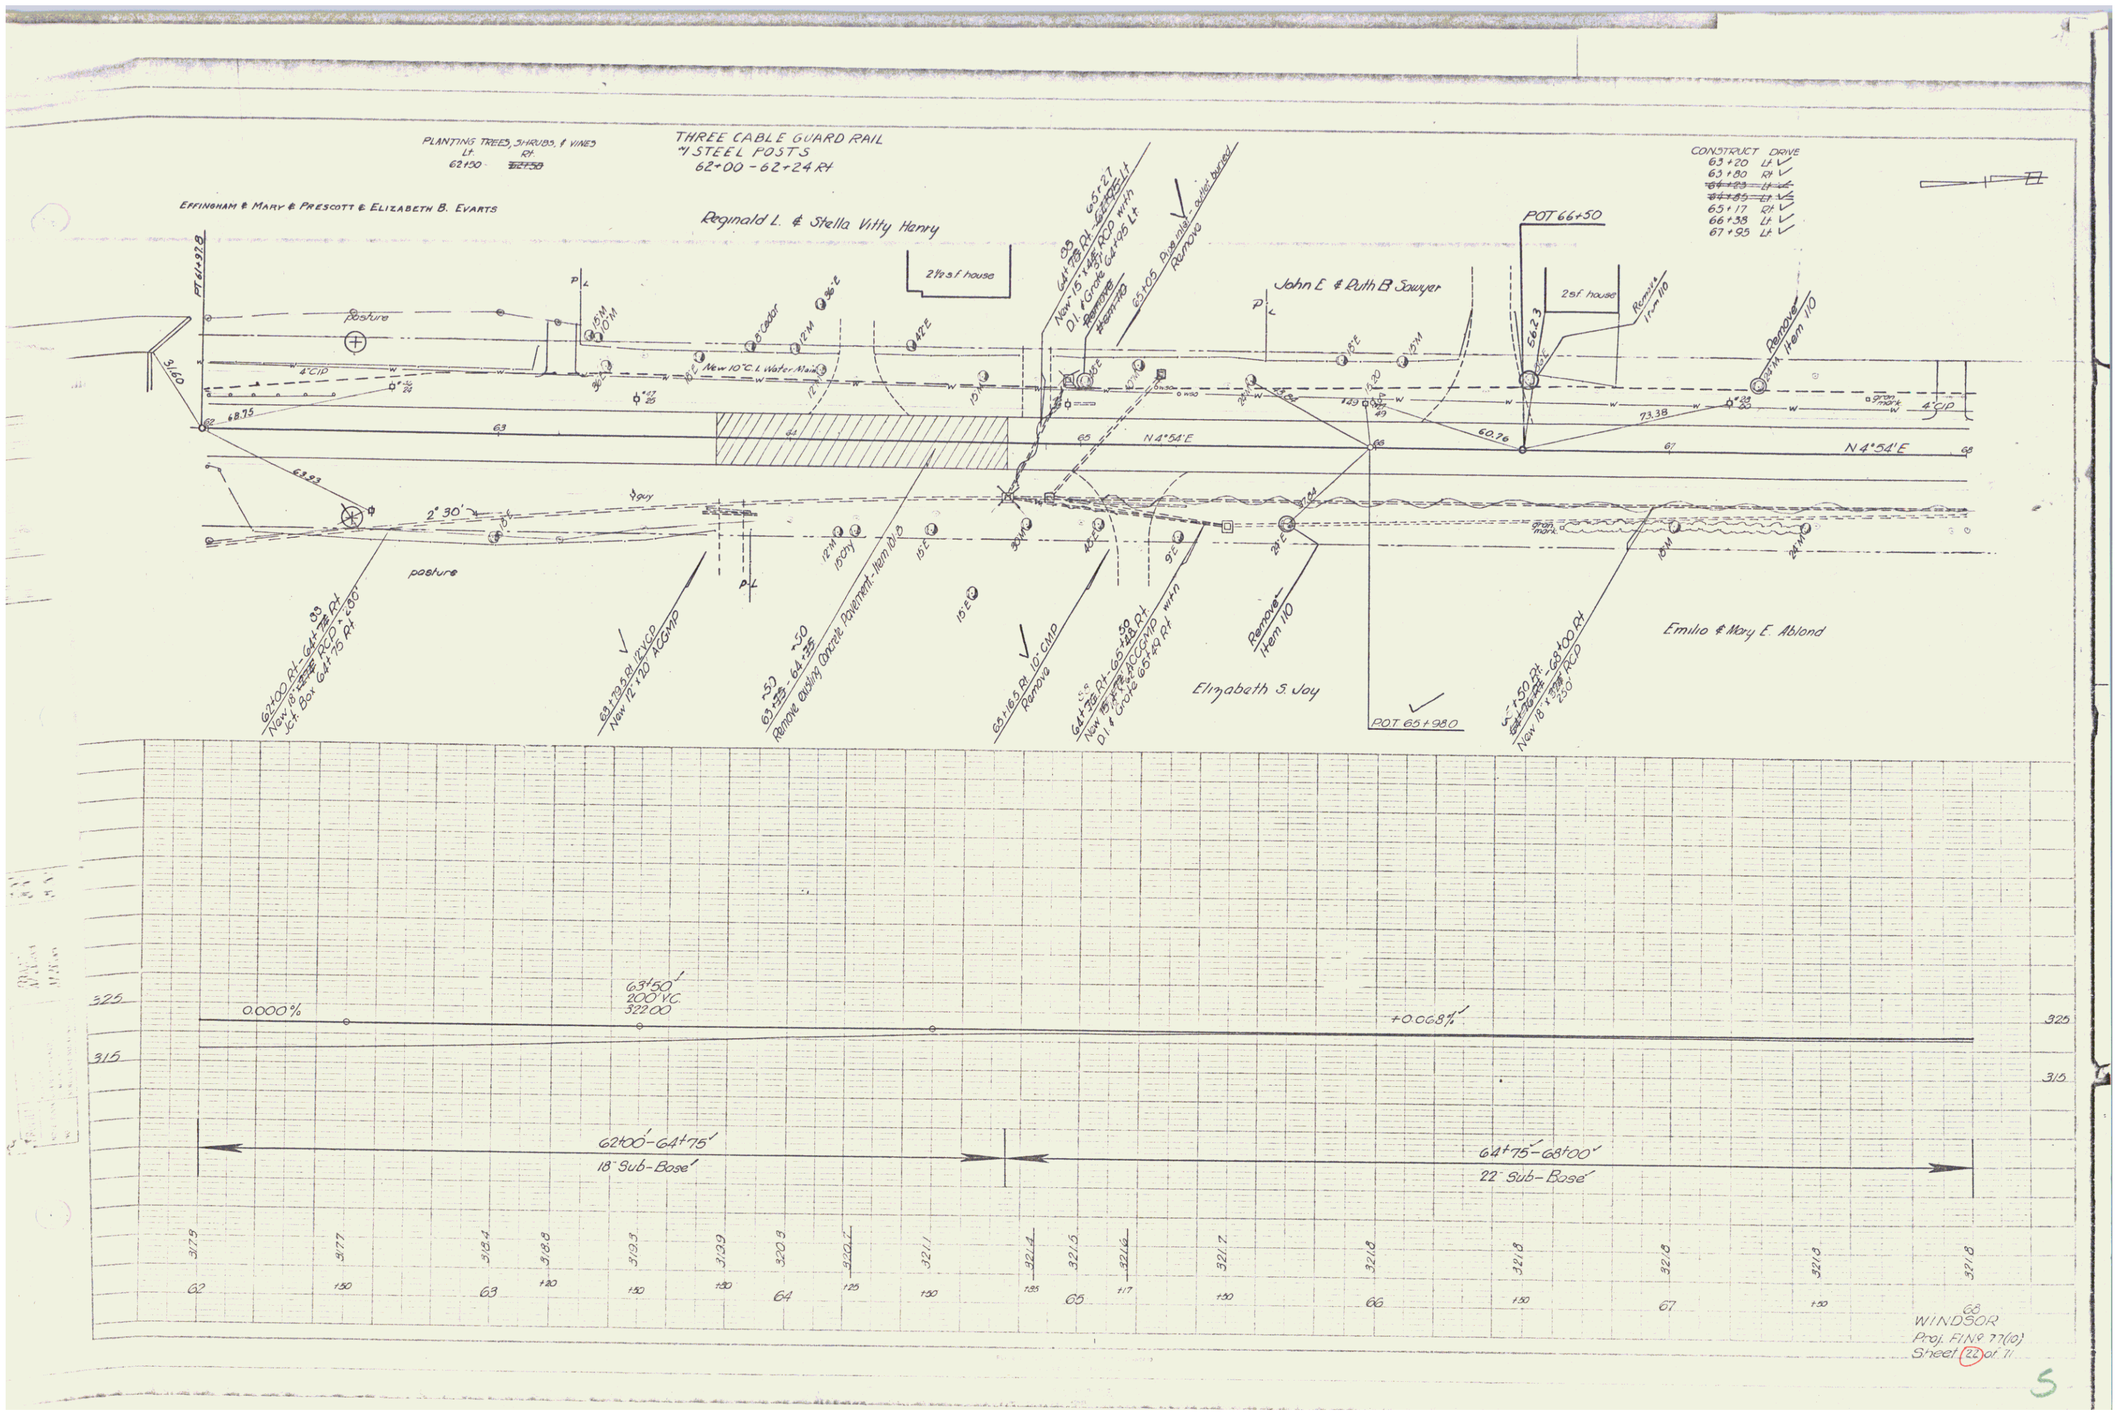
PLANTING TREES, SHRUBS, & VINES
Lt. 62+50
Rt.
THREE CABLE GUARD RAIL
4 STEEL POSTS
62+00 - 62+24 Rt
EFFINGHAM & MARY & PRESCOTT & ELIZABETH B. EVARTS
Reginald L. & Stella Vitty Henry
2½ st house
John E. & Ruth B. Sawyer
2 st house
POT 66+50
CONSTRUCT DRIVE
63+20 Lt
63+80 Rt
65+17 Rt
66+38 Lt
67+95 Lt
PT 61+97.8
Pasture
New 10" C.I. Water Main
N 4°54' E
Remove Hem 110
Emilio & Mary E. Abiond
Elizabeth S. Joy
POT 65+98.0
0.000%
+0.068%
62+00'-64+75'
18" Sub-Base'
64+75'-68+00'
22" Sub-Base'
WINDSOR
Proj. F/N 77(10)
Sheet 22 of 11