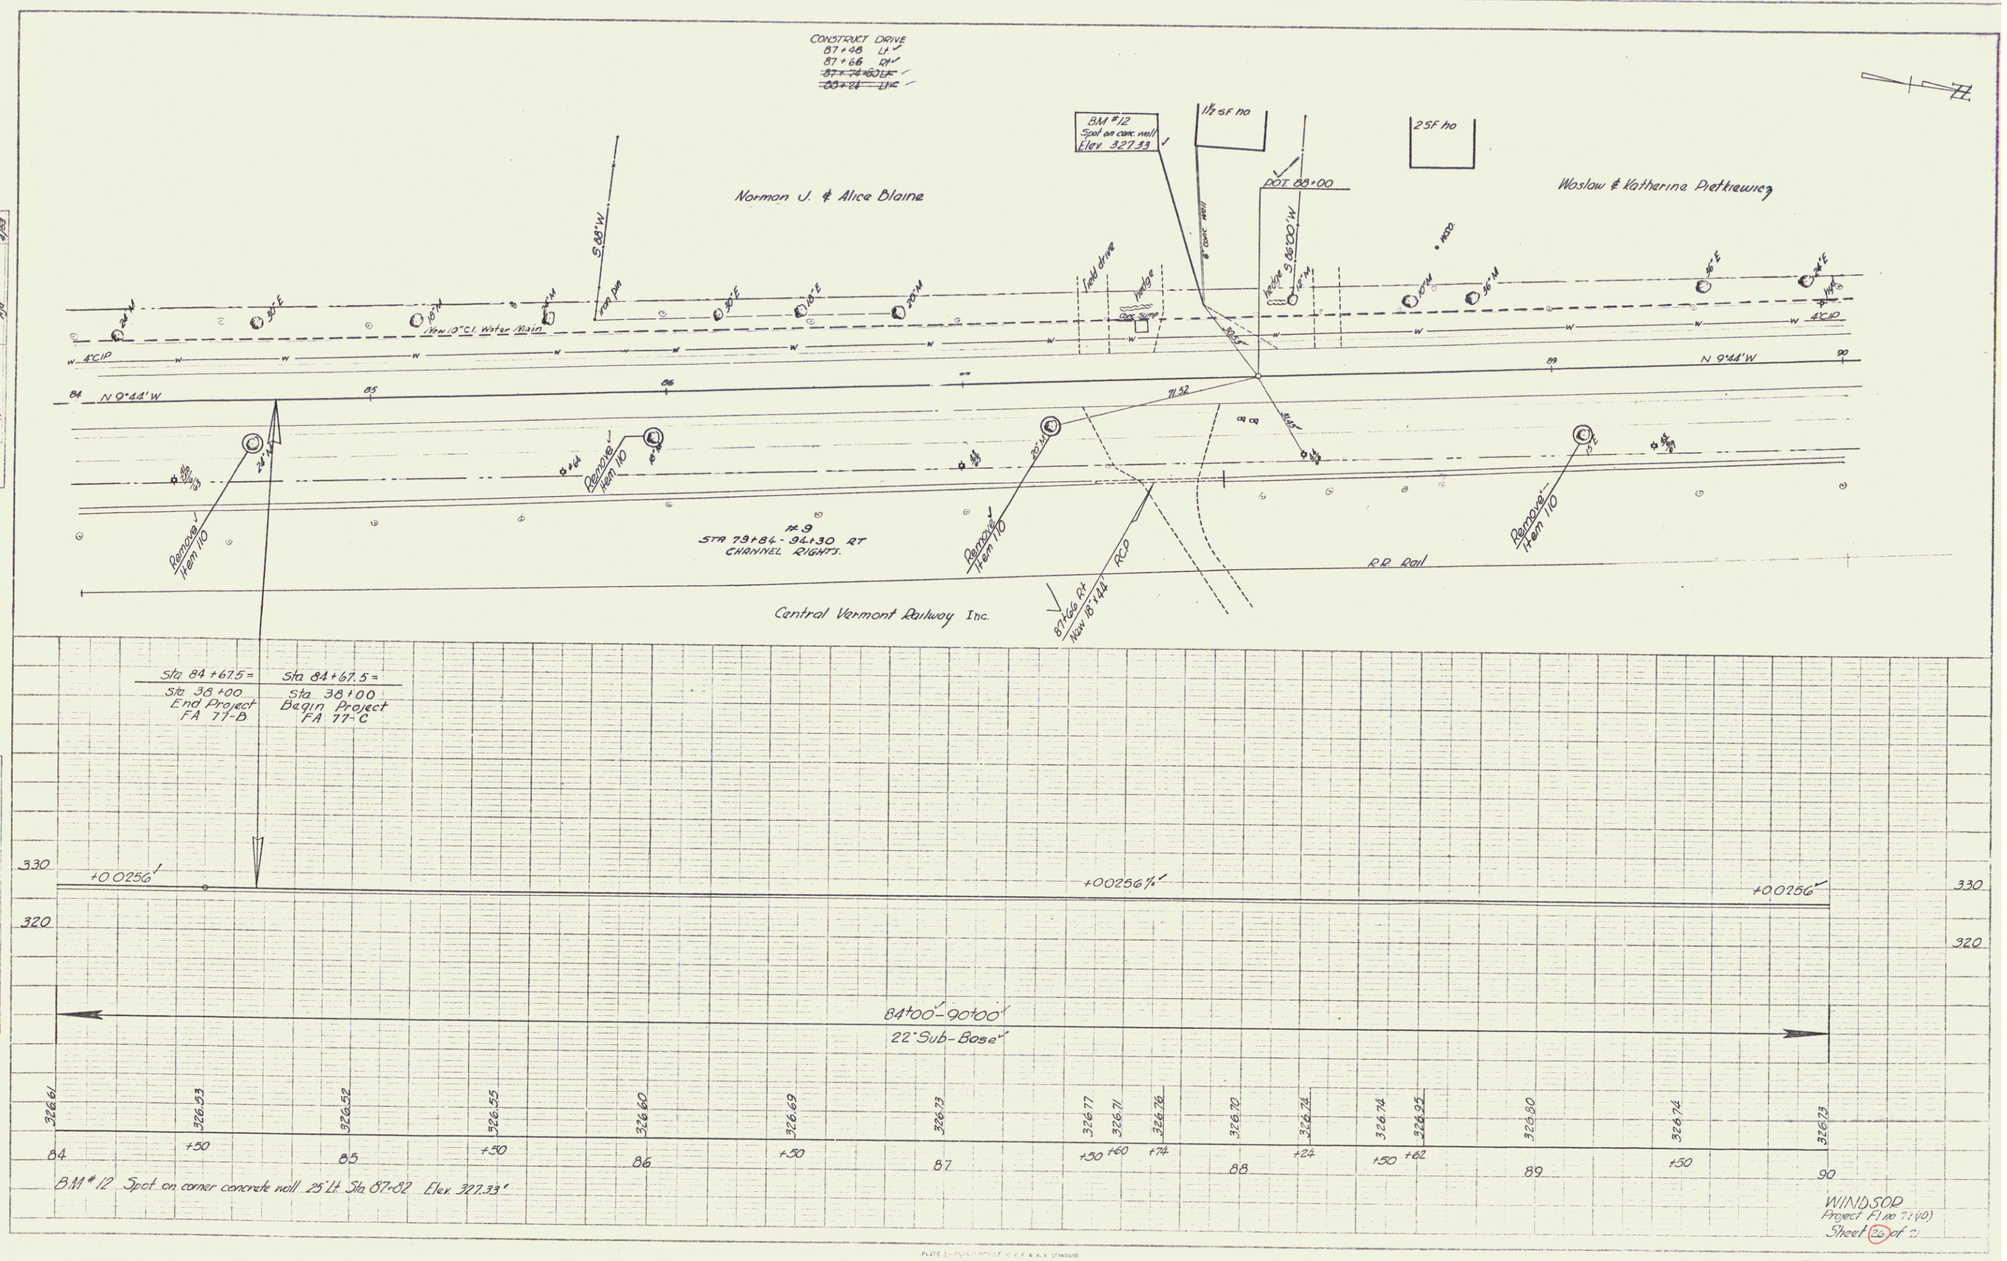
CONSTRUCT DRIVE
87+46 Lt
87+66 Rt
Norman J. & Alice Blaine
Waslaw & Katherine Dietkiewicz
BM #12
Spot on conc. wall
Elev 327.33
1½ sf ho
2 sf ho
POT 88+00
S 88°W
S 88°00' W
New 10" CI Water Main
4" CIP
N 0°44' W
Remove Item 110
#9
STA 79+84 - 94+30 RT
CHANNEL RIGHTS.
Central Vermont Railway Inc.
R.R. Rail
87+66 Rt
New 18" RCP
Sta 84+67.5 =
Sta 38+00
End Project
FA 77-B
Sta 84+67.5 =
Sta 38+00
Begin Project
FA 77-C
+0.0256'
84+00'-90+00'
22' Sub-Base
326.61
326.53
326.52
326.55
326.60
326.69
326.73
326.77
326.71
326.78
326.70
326.74
326.74
326.95
328.80
326.74
326.73
84
85
86
87
88
89
90
BM #12 Spot on corner concrete wall 25' Lt. Sta 87+82 Elev. 327.33'
WINDSOR
Project F1 no 7 (10)
Sheet 26 of 2

9