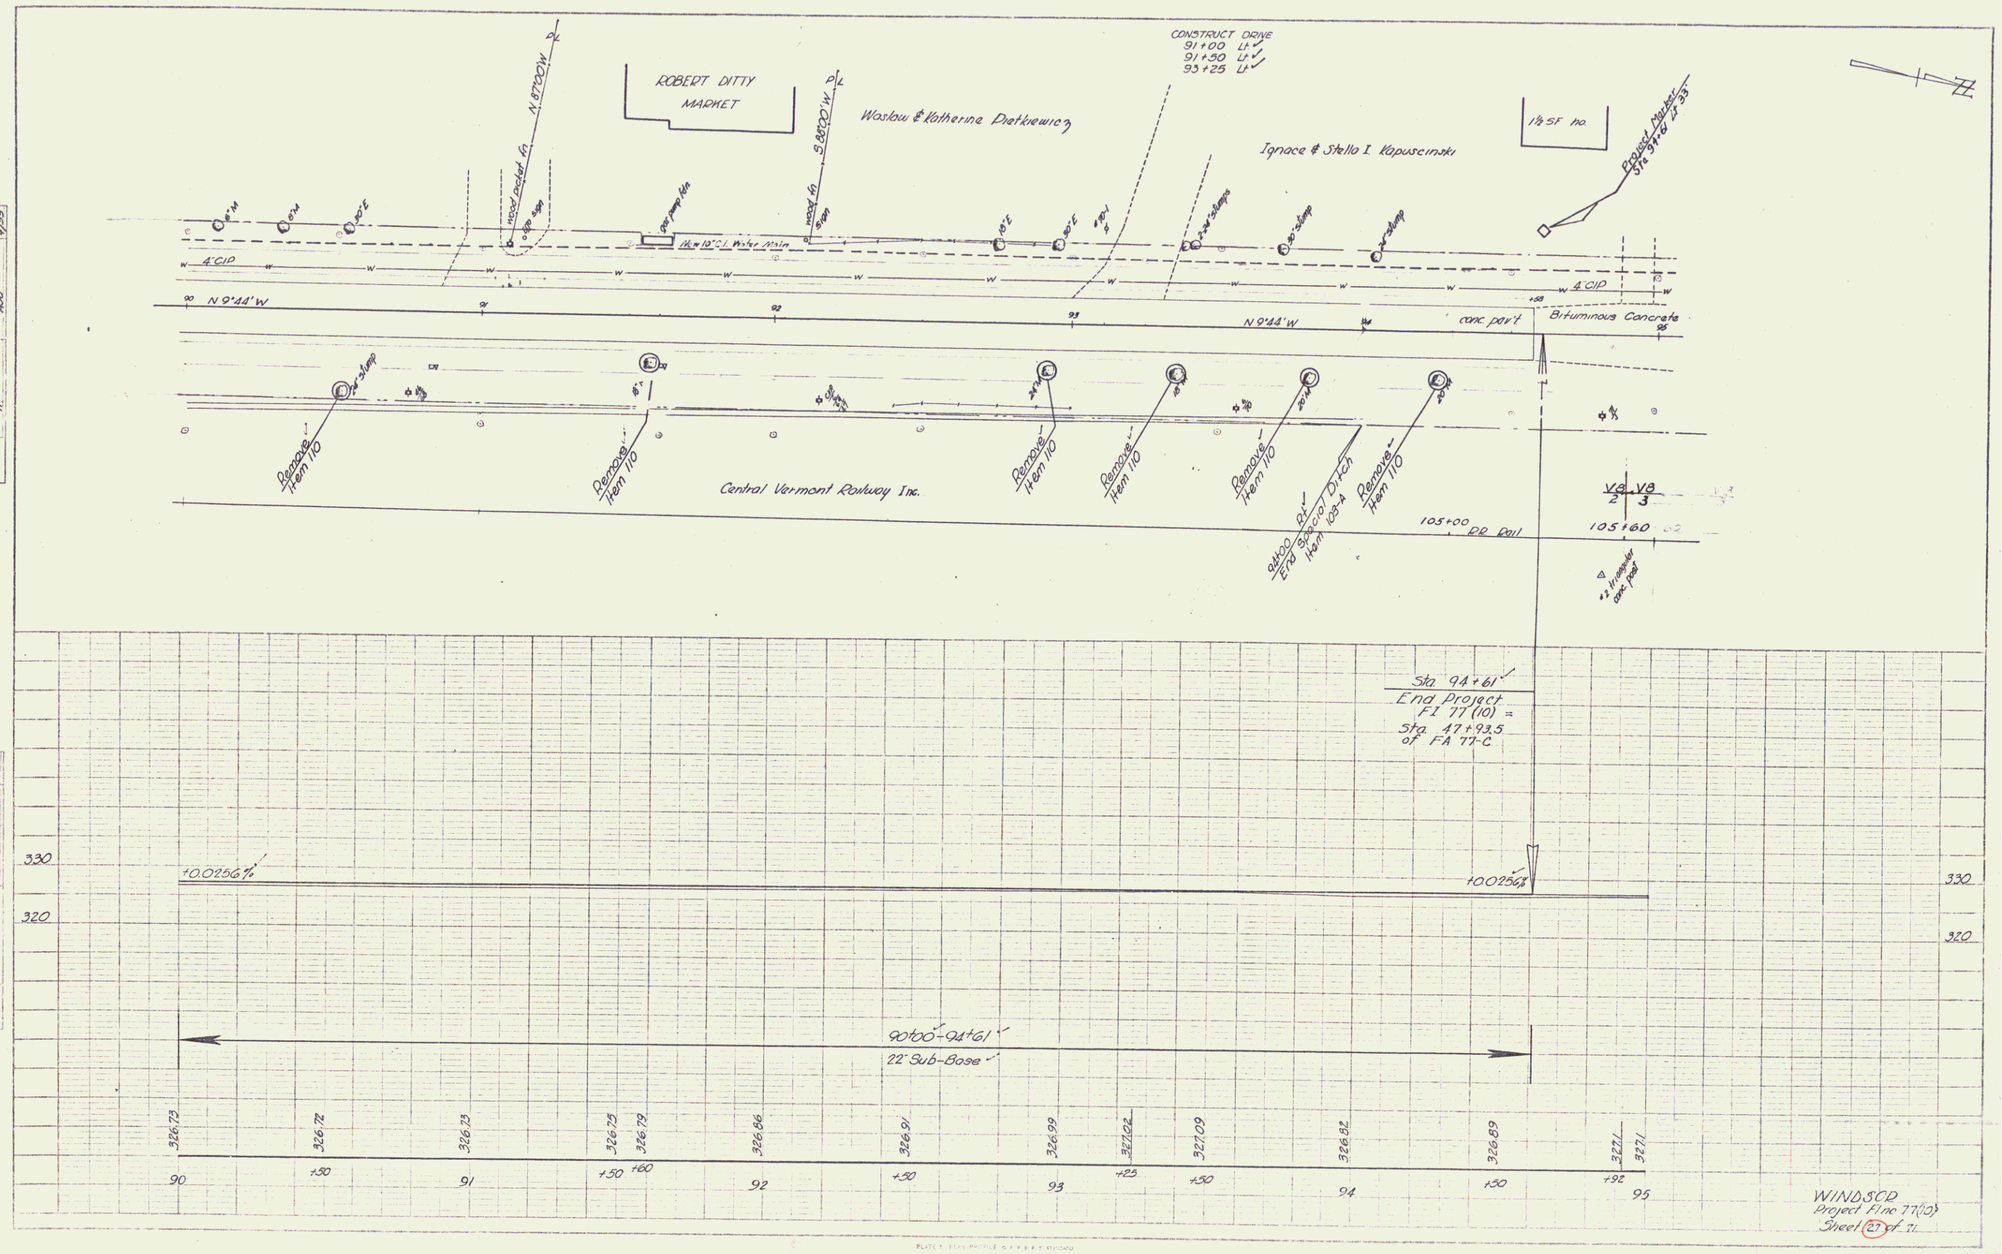
ROBERT DITTY MARKET
Waslow & Katherine Dretkiewicz
Ignace & Stella I Kapuscinski
CONSTRUCT DRIVE
91+00 Lt
91+50 Lt
93+25 Lt
1½ SF ho
Project Number Sta 91+61 = 33
N 87°00'W
S 88°00'W
P/L
Wood pocket in
Wood in
1½ w 10" CI Water Main
4" CIP
N 9°44'W
conc pav't
Bituminous Concrete
Remove Item 110
Central Vermont Railway Inc.
Sta 94+61
End Project FI 77(10) = Sta 47+93.5 of FA 77-C
105+00 RR Rail
105+60
+0.0256%
90+00-94+61
22' Sub-Base
326.73
326.72
326.73
326.75
326.72
326.86
326.91
326.99
327.02
327.09
326.82
326.89
327.1
327.1
90
91
92
93
94
95
330
320
WINDSOR
Project FI no 77(10)
Sheet 27 of 71

10