
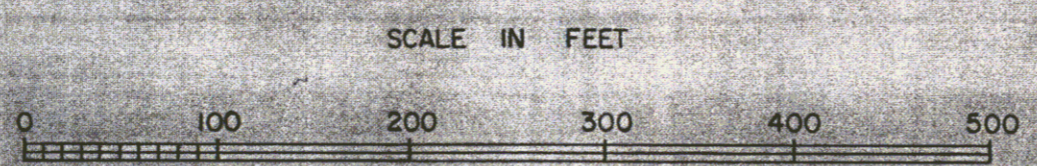
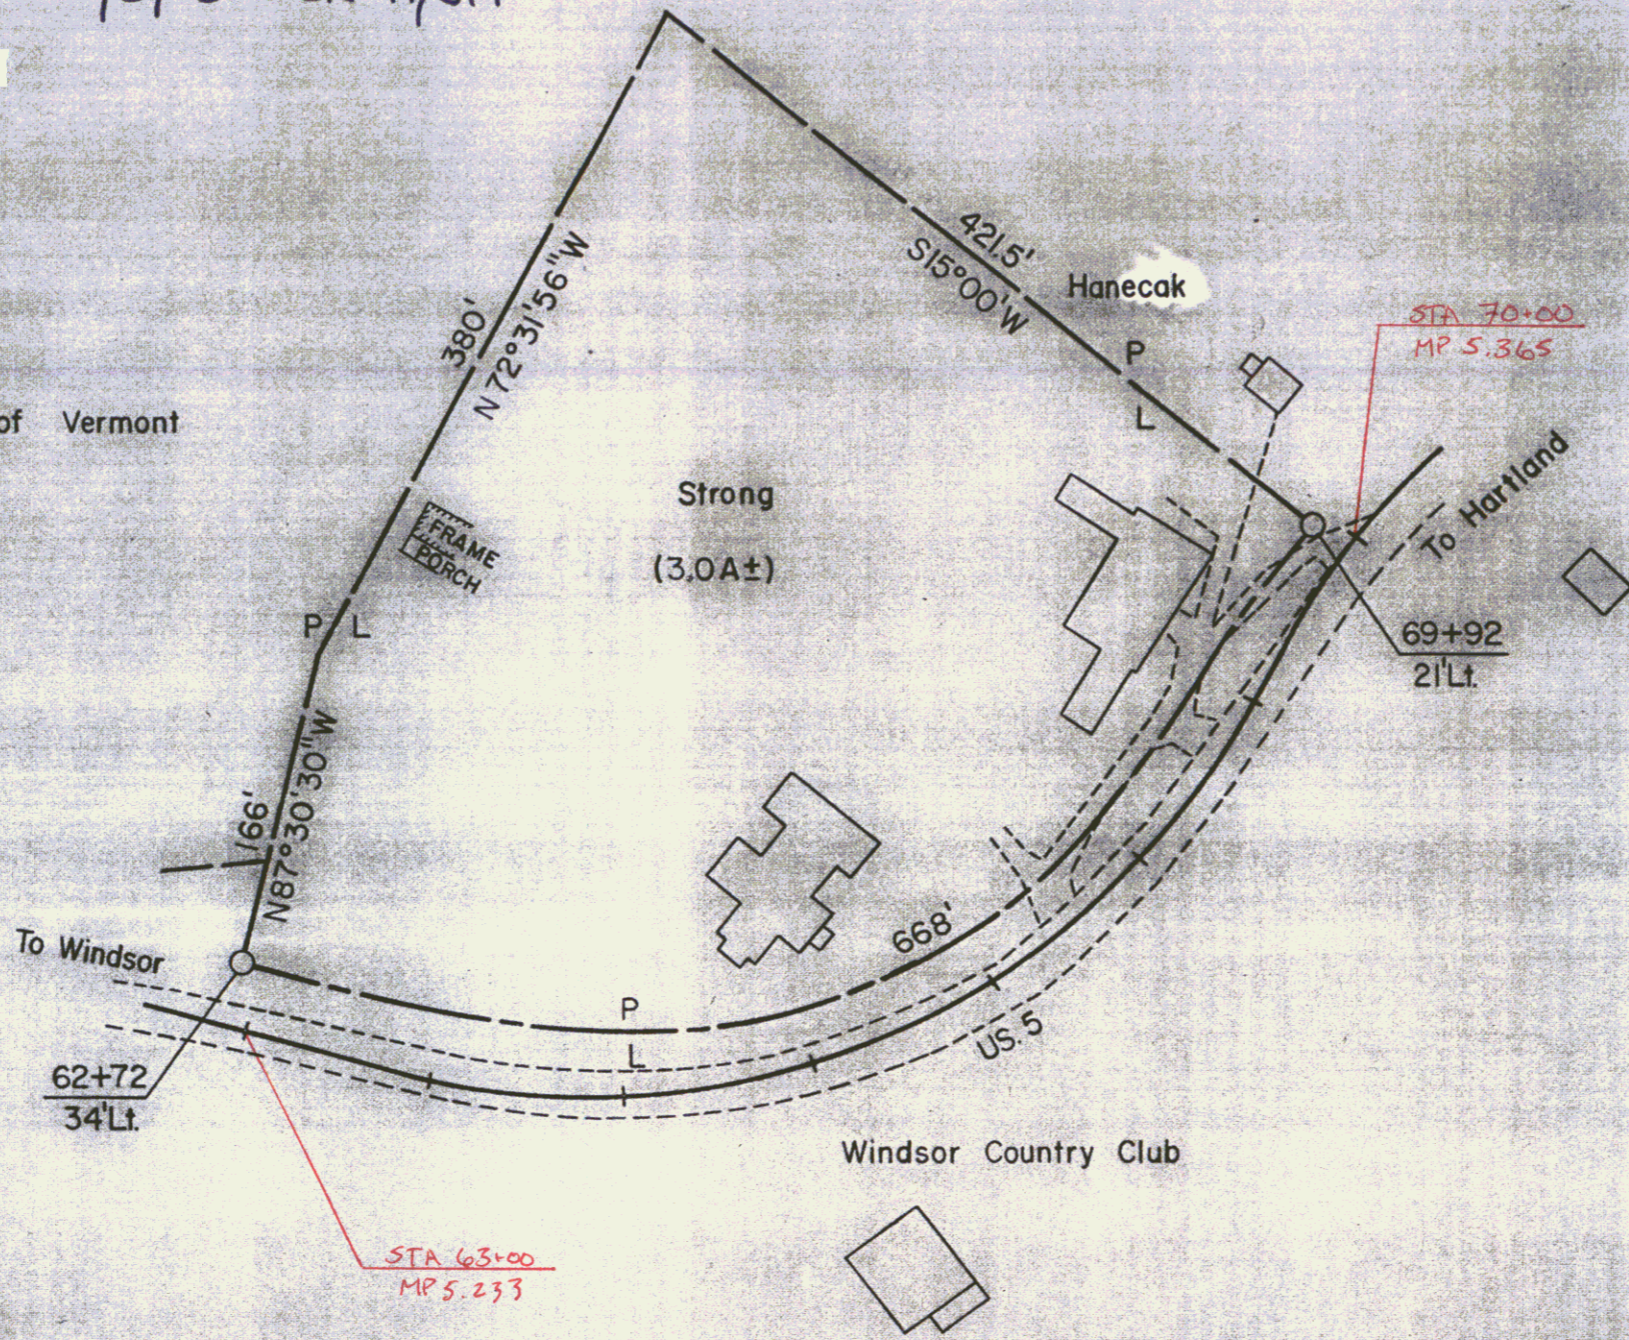


STUART STRONG TO STATE OF VERMONT
 BY OPTION OF 12/5/74 IN BK 70/317-18
 AND BY WAIVER OF 1/8/76 IN BK 71/314
 MP = [REDACTED]

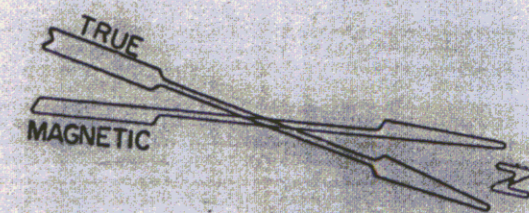

Pin # 992330

Reference: Windsor BP 041-2-7121
 BP 041-2-7308

SHEET 1

STATE OF VERMONT
 DEPT. OF HIGHWAYS

TOWN OF WINDSOR
 Route: US 5

PROJECT WINDSOR BPO41-2-7549

APPROX. SCALE 1" = 100' DATE 12-19-75 DRAWN BY ROD S.

214