


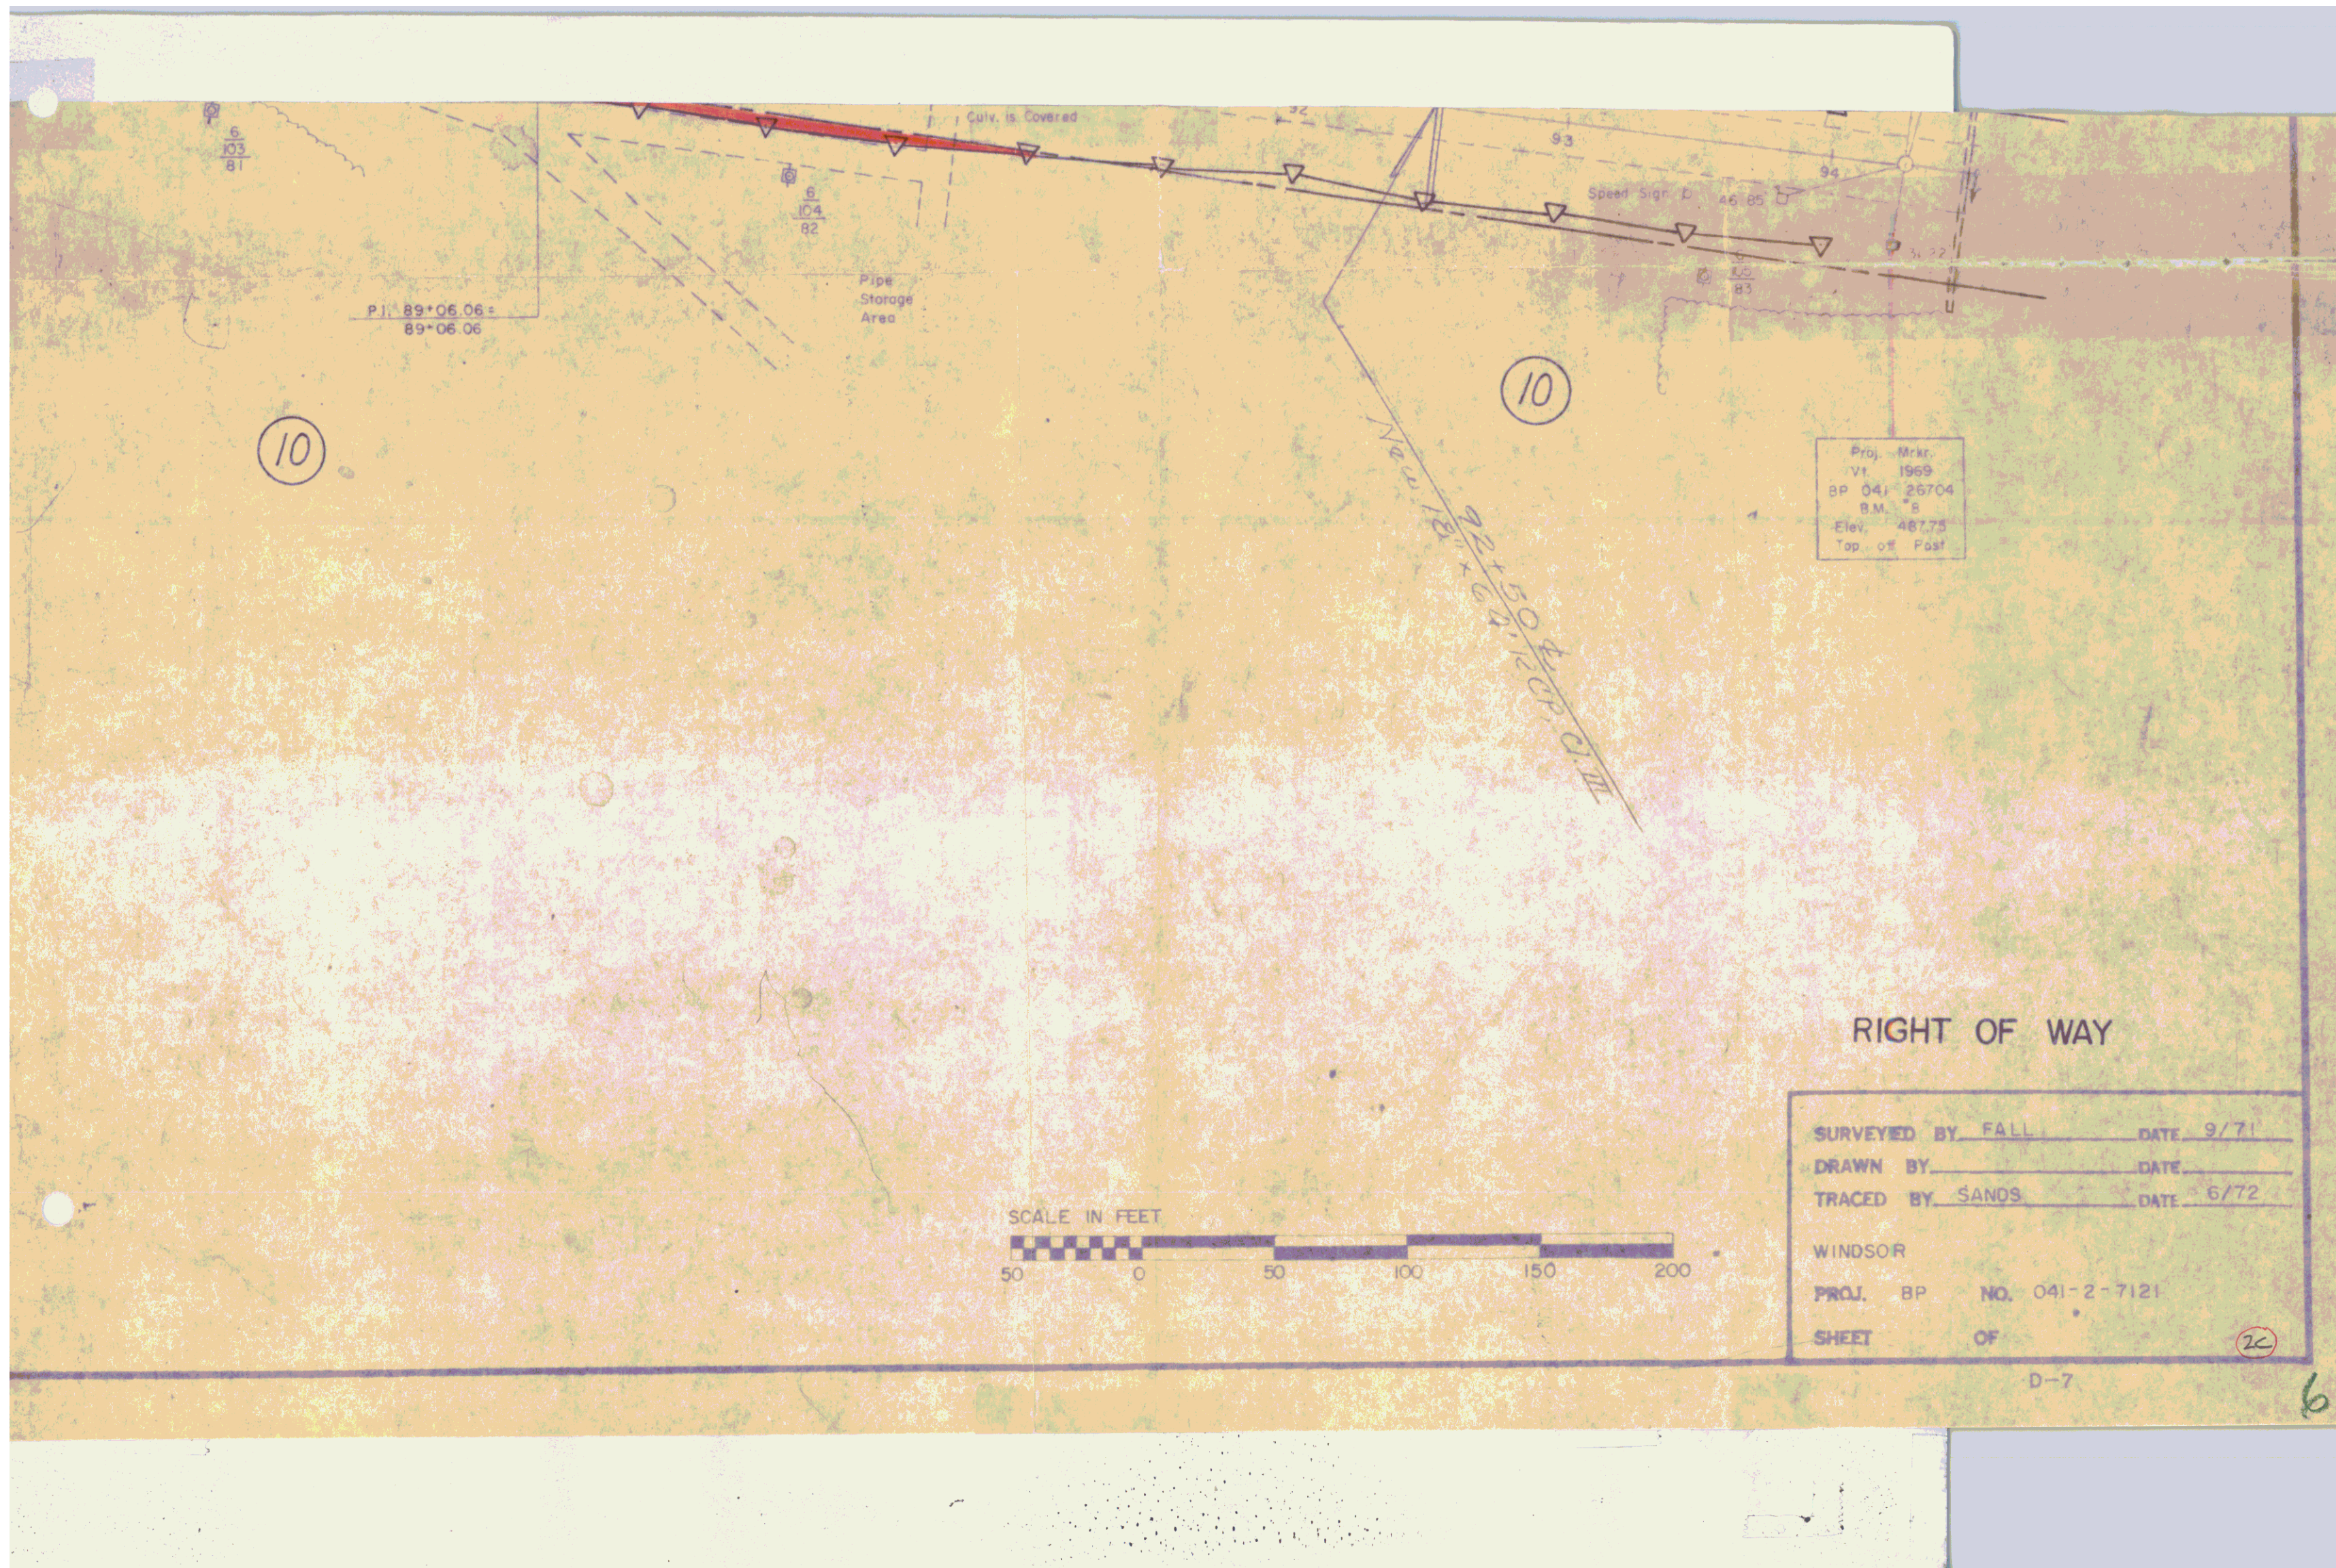

RIGHT OF WAY

SURVEYED BY	FALL	DATE	9/71
DRAWN BY		DATE	
TRACED BY	SANDS	DATE	6/72
WINDSOR			
PROJ.	BP	NO.	041-2-7121
SHEET	OF		

D-7

6