INDEX OF SHEETS

1	Title Sheet	
2	Typical Sheet	
3	Quantity Sheet	
4	Drainage Sheet	
5	Grade and Earthwork Sheet	
6-8	R.O.W. Detail Sheets	
9-12	Plan and Profile Sheets	
13	84" C.G.M.R.P. Details	
14-17	Channel Sections	
18	A-60 Solid Rock Excavation (50 M.P.H. & Over)	12/21/67 R
19	B-1 Banking Tables	7/17/67 R
20	B-5 Typical Slope Grading	3/10/65
21	B-6 Muck Excavation	3/10/65
22	B-10 Embankment on a Slope	3/10/65
23	B-11 Methods of Slope Stabilization	3/10/65
24	C-1 Curbs	5/10/68 R
25	D-2 Headwalls and Underdrain	7/25/67 R
26	D-3 Treated Gutters and Jute Matting	7/19/67 R
27	D-4 Elbows and Flushing Basins	8/ 1/66 R
28	D-6 R.C. Drop Inlets with Grates	12/23/66
29	D-10 Drop Inlet Tops	3/10/65
30	D-11 Details of Grates and Covers	3/10/65
31	D-16 Cast Iron Grates	7/18/67 R
32	Blank	
33	E-32 Road Construction Approach Signs	1/ 6/67
34	E-34 On-Project Construction Signs	5/ 3/67 R
35	E-36 Road Construction Signs-Betterment Projects	1/24/68
36	G-3 Three Cable Guard Rail with Steel Posts and Anchors	9/ 1/66 R
37	G-4 Marker Posts	12/30/65 R
38	Blank	
39	J-1 Boundary and Project Markers	3/10/65
40-57	Cross Sections	

5 Final Contract Plans Sheets
41 Total Contract Sections
11 Structure Sheets
18 Drainage Sheets

WINDSOR BP041-2-6704 BIT CONC. 2.2%

LYMAN PIT - HARTLAND, VT.
" " "
L.M. FIKE - W. LEBANON, N.H.
HUMBLE - EVERETT, MASS.
LEBANON CRUSHED STONE INC. - W. LEBANON, N.H.
"E" MILLER - W. LEBANON, N.H.
L.M. FIKE - W. LEBANON, N.H.
NORTHEASTERN CULVERT CORP. - WESTMINSTER, VT.
HUME PIPE CO. OF N.E. - WINDSOR, VT.
NORTHEASTERN CULVERT CORP. - WESTMINSTER, VT.
HUME PIPE CO. OF N.E. - WINDSOR, VT.
S.T. GRISWOLD & CO. INC. - WILLISTON, VT.
NORTHEASTERN CULVERT CORP. - WESTMINSTER, VT.

CALEDONIA INC.
ST JOHNSBURY, VT.
A.C. DAVIS
R. FULLER

JAN 6, 1969
JAN 7, 1969
(AUG. 13, 1969)

STATE OF VERMONT
DEPARTMENT OF HIGHWAYS

PROPOSED IMPROVEMENT

TOWN OF WINDSOR
COUNTY OF WINDSOR
U.S. ROUTE 5
WINDSOR — HARTLAND ROAD

BEGINNING AT A POINT 0.996 MILES SOUTHERLY OF THE WINDSOR–HARTLAND TOWN LINE AND EXTENDING NORTHERLY 0.524 MILES

LENGTH OF PROJECT 2,766.4 FEET = 0.524 MILES

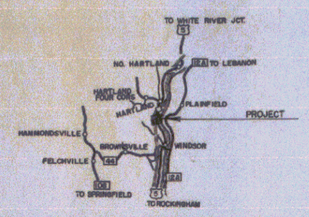

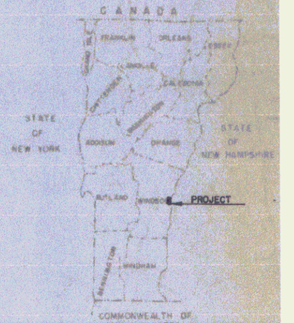

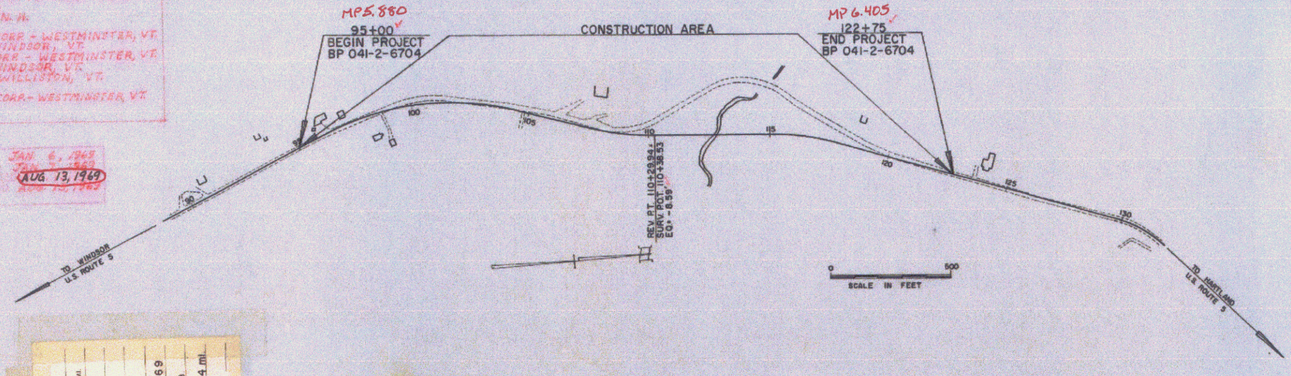

CONVENTIONAL SIGNS

POINT OF ACCESS
LIMITS OF ACCESS
COUNTY LINE
TOWN LINE
FENCE LINE
STONE WALL
UNFENCED PROPERTY
GUARD RAIL
TRAMBLED WAY
RAILROAD
RETAINING WALL
CENTER LINE
SURVEY LINE
GULLEY
DROP PILE
TROLLEY POLE
POWER POLE
TELEPHONE POLE
TREES
HOUSE

SLOPE
GROUND
GRADE
DEFLECTION
DOUBLE
RADIUS
TANGENT
LENGTH
EXTERNAL
POINT OF
POINT OF
POINT OF
POINT OF

PROJECT WINDSOR
NUMBER BP 041-2-6704
LENGTH 0.524 mi.
TYPE BITUMINOUS CONCRETE PAVEMENT
CONTRACTOR CALEDONIA INC.
ST. JOHNSBURY, VT.
YEAR 1969
CAUSE Beginning at a point 0.996 miles southerly of the Windsor - Hartland town line and extending northerly 0.524 mi.

FOR RIGHT OF WAY DETAILS, SEE RIGHT OF WAY PLANS FOR THIS PROJECT.

NOTE: ANY FURTHER INFORMATION CONCERNING FINAL QUANTITIES, AMOUNTS OR OTHER DETAILS RELATIVE TO THIS PROJECT MAY BE FOUND IN EITHER THE FIELD BOOKS OR THE ESTIMATE FILE.

THESE PLANS ARE SUBJECT TO SUCH REVISIONS AS MAY BE REQUIRED BY THE BUREAU OF PUBLIC ROADS OR THE COMMISSIONER OF HIGHWAYS.

CONSTRUCTION IS TO BE CARRIED ON IN ACCORDANCE WITH THESE PLANS AND THE STANDARD SPECIFICATIONS FOR HIGHWAY AND BRIDGE CONSTRUCTION DATED APRIL, 1964, AS APPROVED BY THE BUREAU OF PUBLIC ROADS ON OCTOBER 15, 1964, INCLUDING ALL SUBSEQUENT APPROVED REVISIONS AND SUCH REVISED SPECIFICATIONS AND SPECIAL PROVISIONS AS ARE INCORPORATED IN THESE PLANS.

Pin # 99R322

APPROVED		APPROVED		APPROVED		APPROVED		APPROVED	
J.S. Chase		R.J. Funk		A.W. Born		G.M. Lane		E.H. Stickney	R.H. Crowell
DISTRICT ENGINEER		CONSTRUCTION ENGINEER		MATERIALS ENGINEER		HIGHWAY CONTRACTS		ASST. CHIEF ENGINEER	CHIEF ENGINEER
DATE 5/31/67		DATE 5/31/67		DATE 6/1/67		DATE 5/31/67		DATE 5/31/67	DATE 5/31/67

DEPARTMENT OF TRANSPORTATION
BUREAU OF PUBLIC ROADS

APPROVED

DIVISION ENGINEER DATE

PROJECT BP NO. 041-2-6704

SHEET 1 OF 57 SHEETS