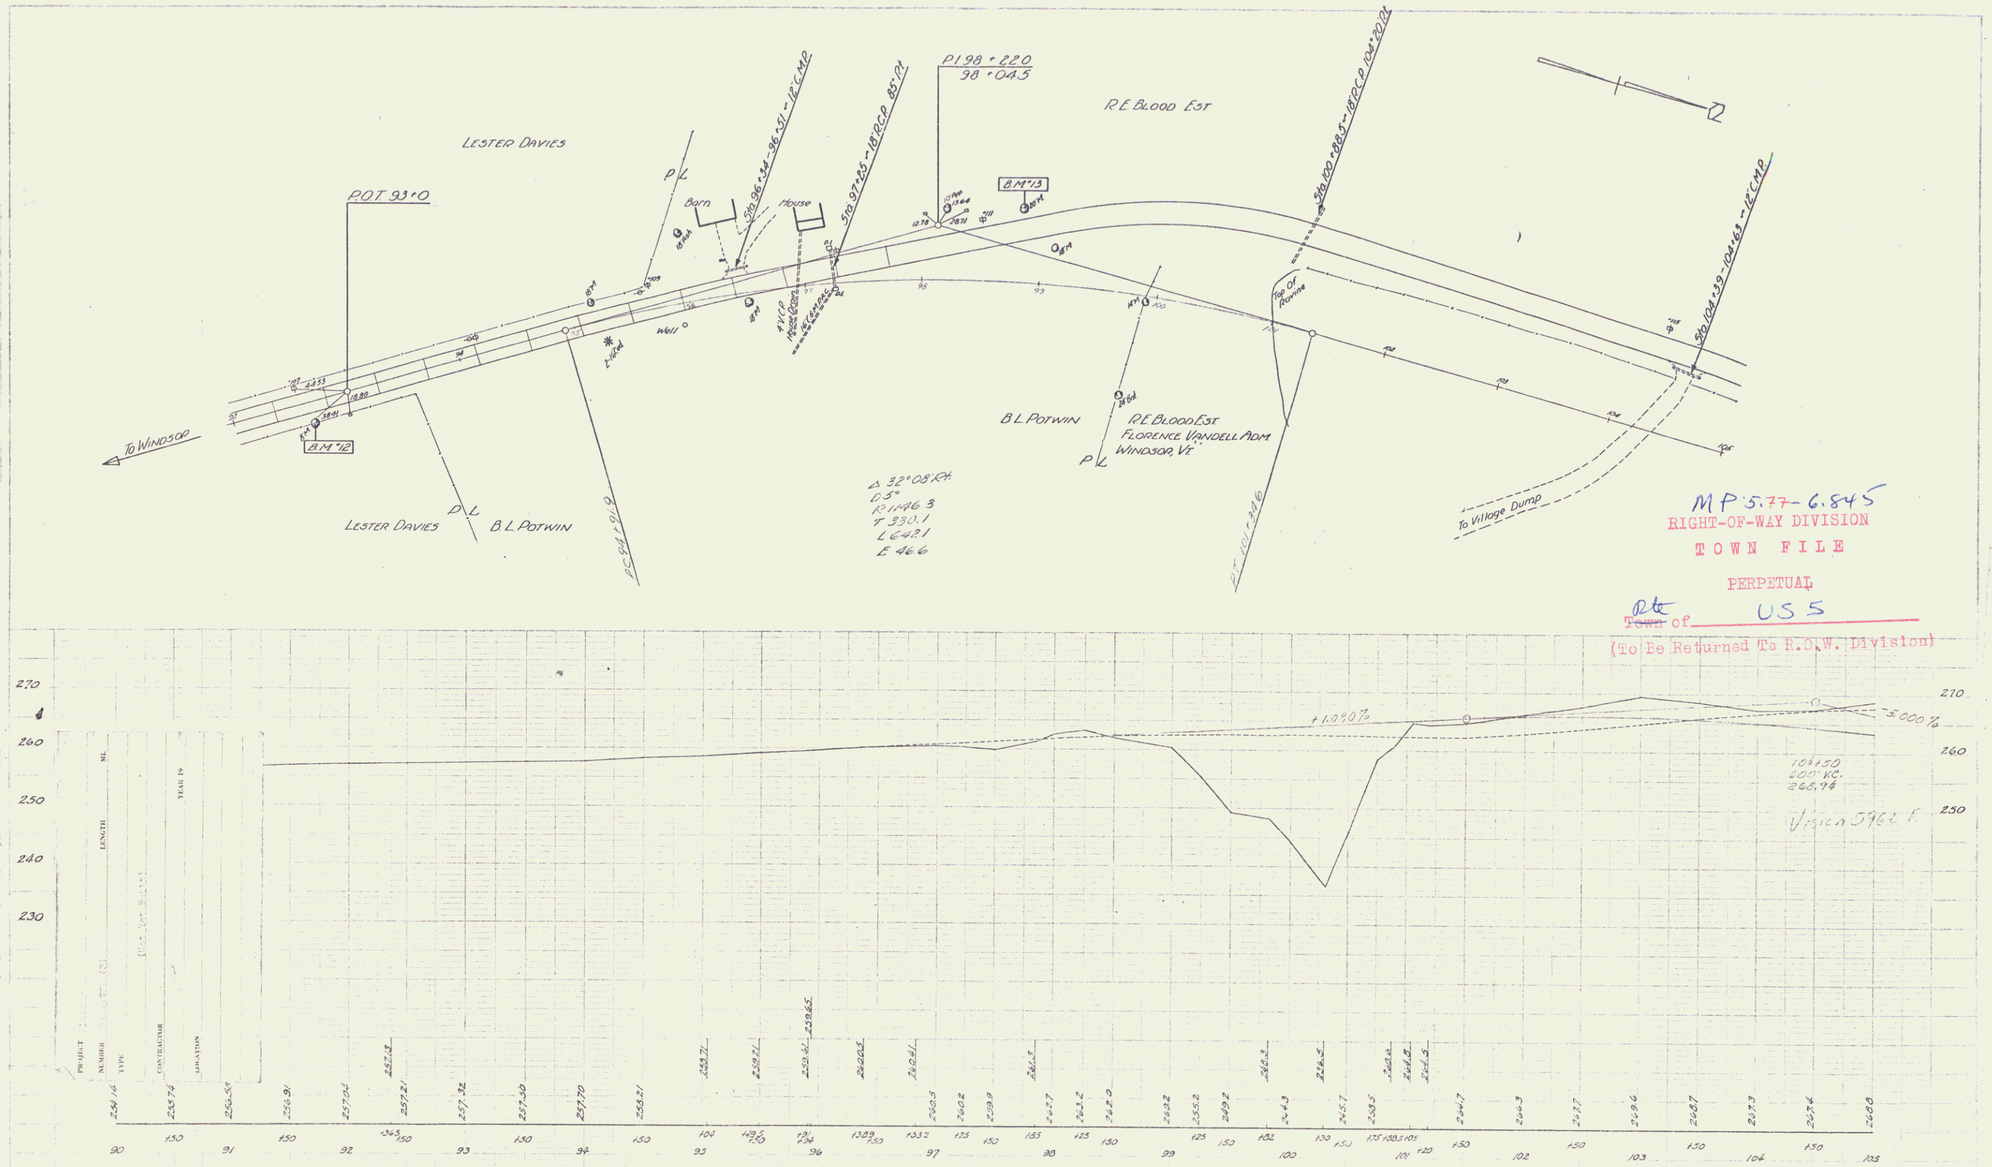

MP 5.77-6.845
RIGHT-OF-WAY DIVISION
TOWN FILE
PERPETUAL
~~Town~~ Rte of US 5
(To Be Returned To R.O.W. Division)

Town: WINDSOR
SERIES F77D(3) No
SHEET 1 OF
Route: US5
Project: F77D(3)
1/1/41
99R324
DIST. #4 PLANS