POOR ORIGINAL COPY

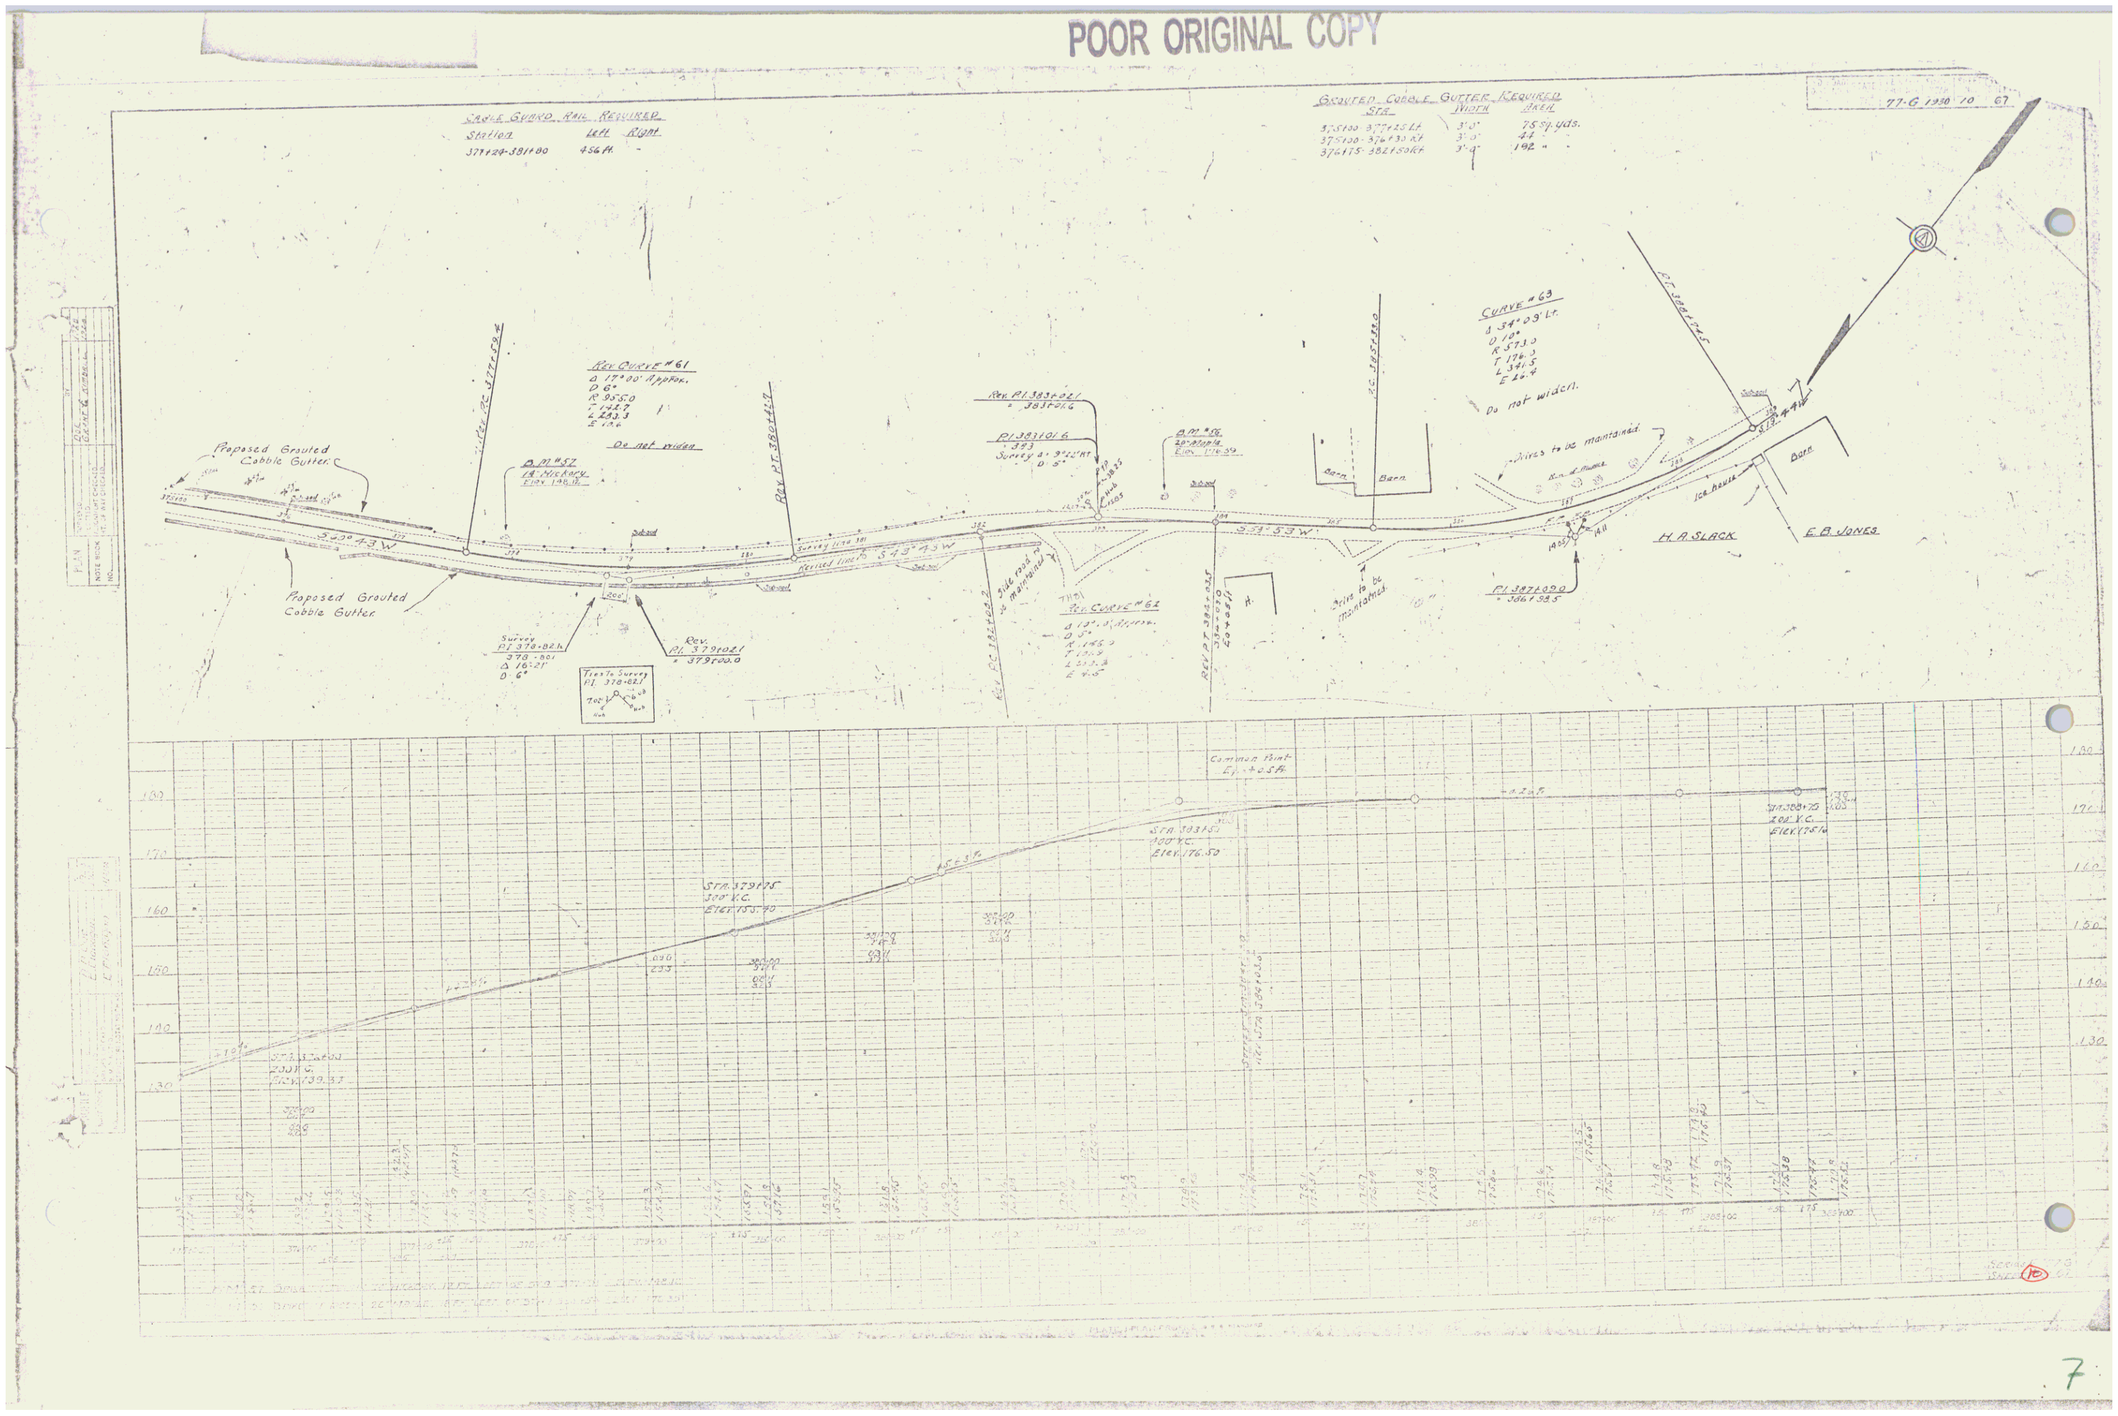

7