7.7.6	1930	24	67	

STEEL GUARD RAIL REQUIRED

STATION	LT.	RIGHT
593+14	24 ft	24 ft
601+24	24 ft	24 ft

NEW REINF. CONC. PIPE CULVERTS REQUIRED

Station	Diam	Leng	Conc. C.	Steel
593+14	15"	44 ft	30 cy	33#
601+24	18"	44 ft	30 cy	33#

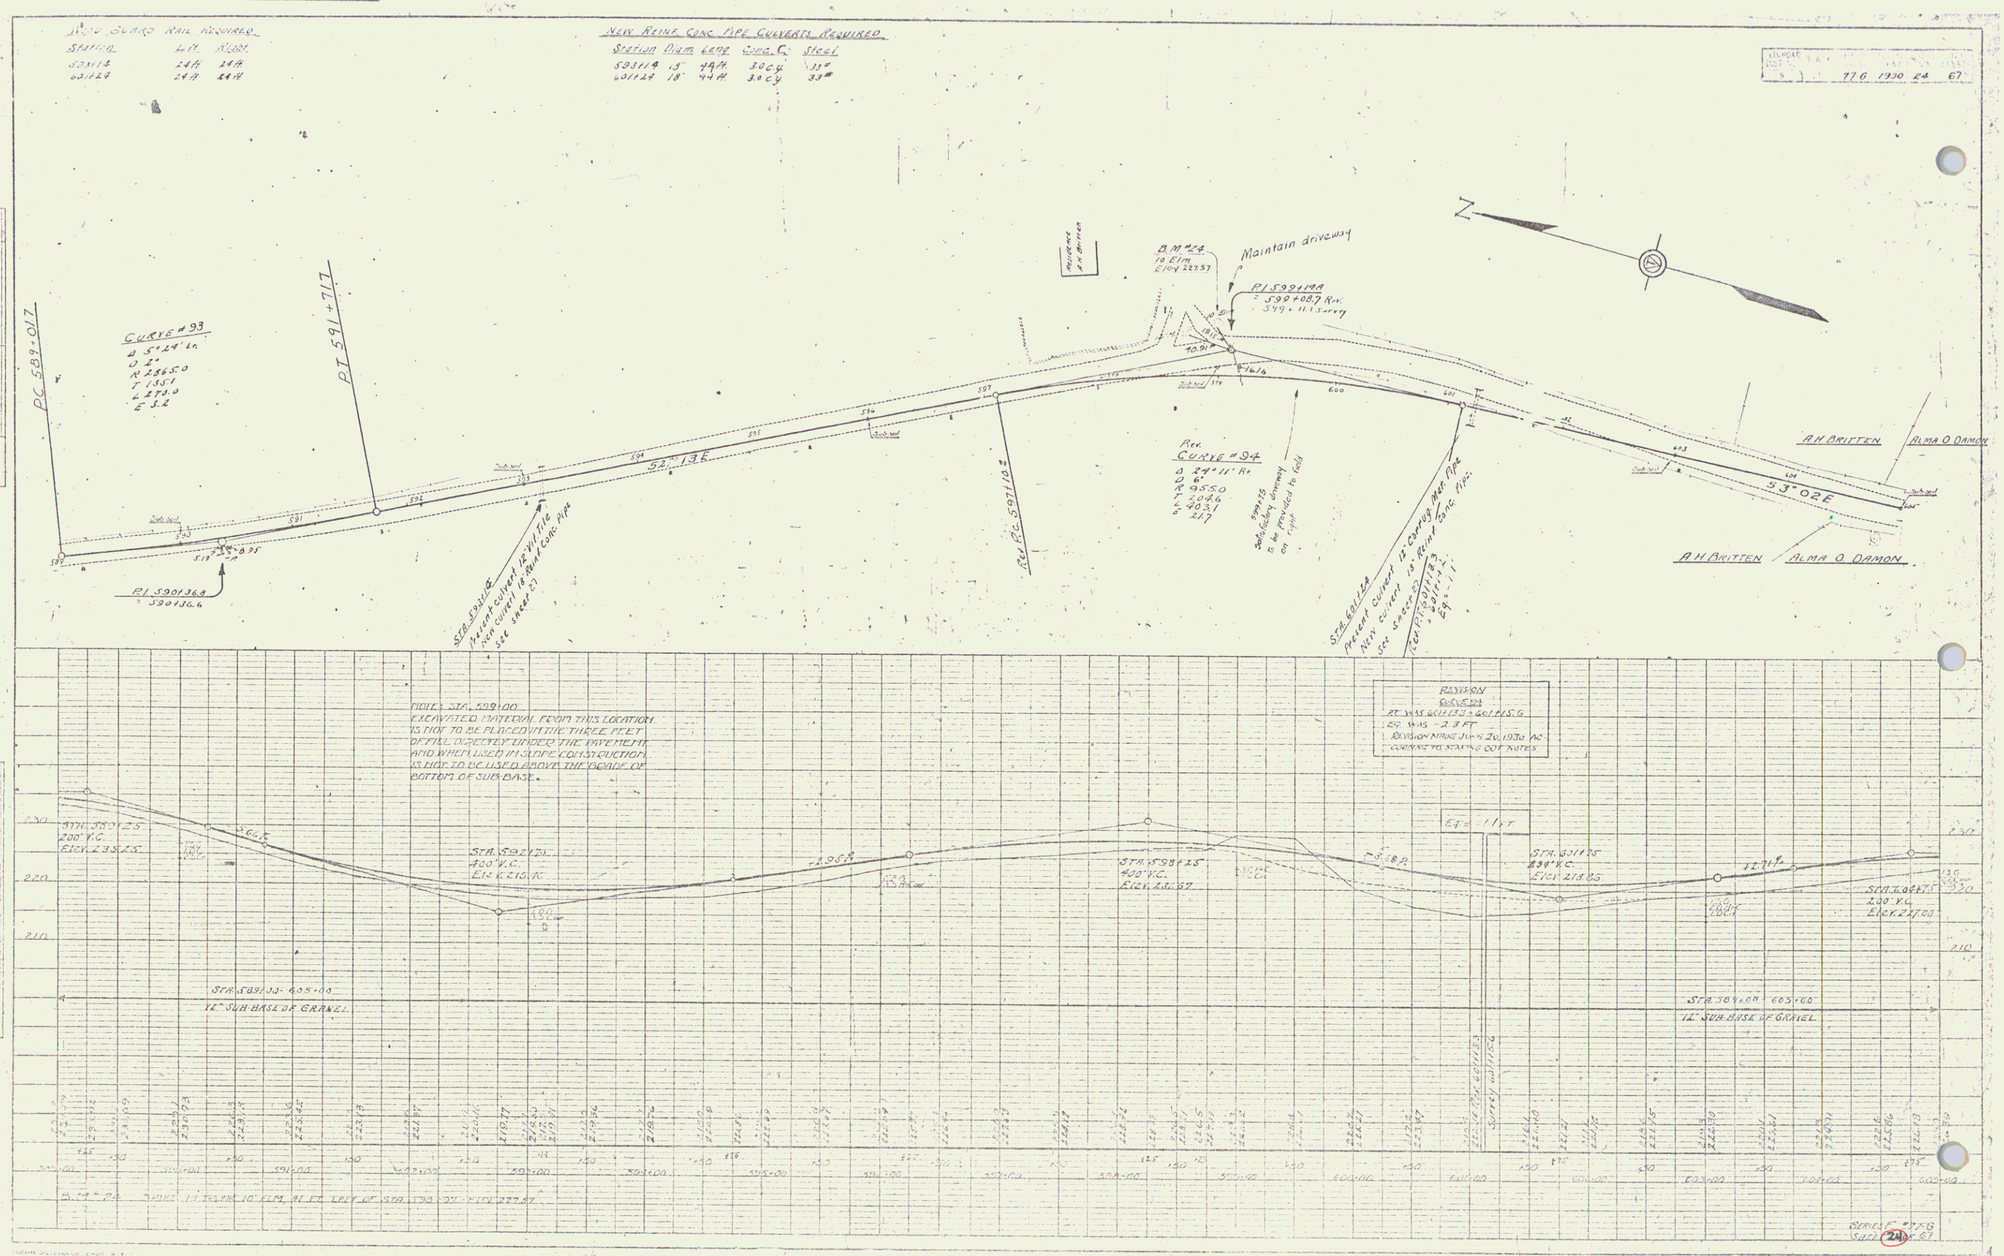

23