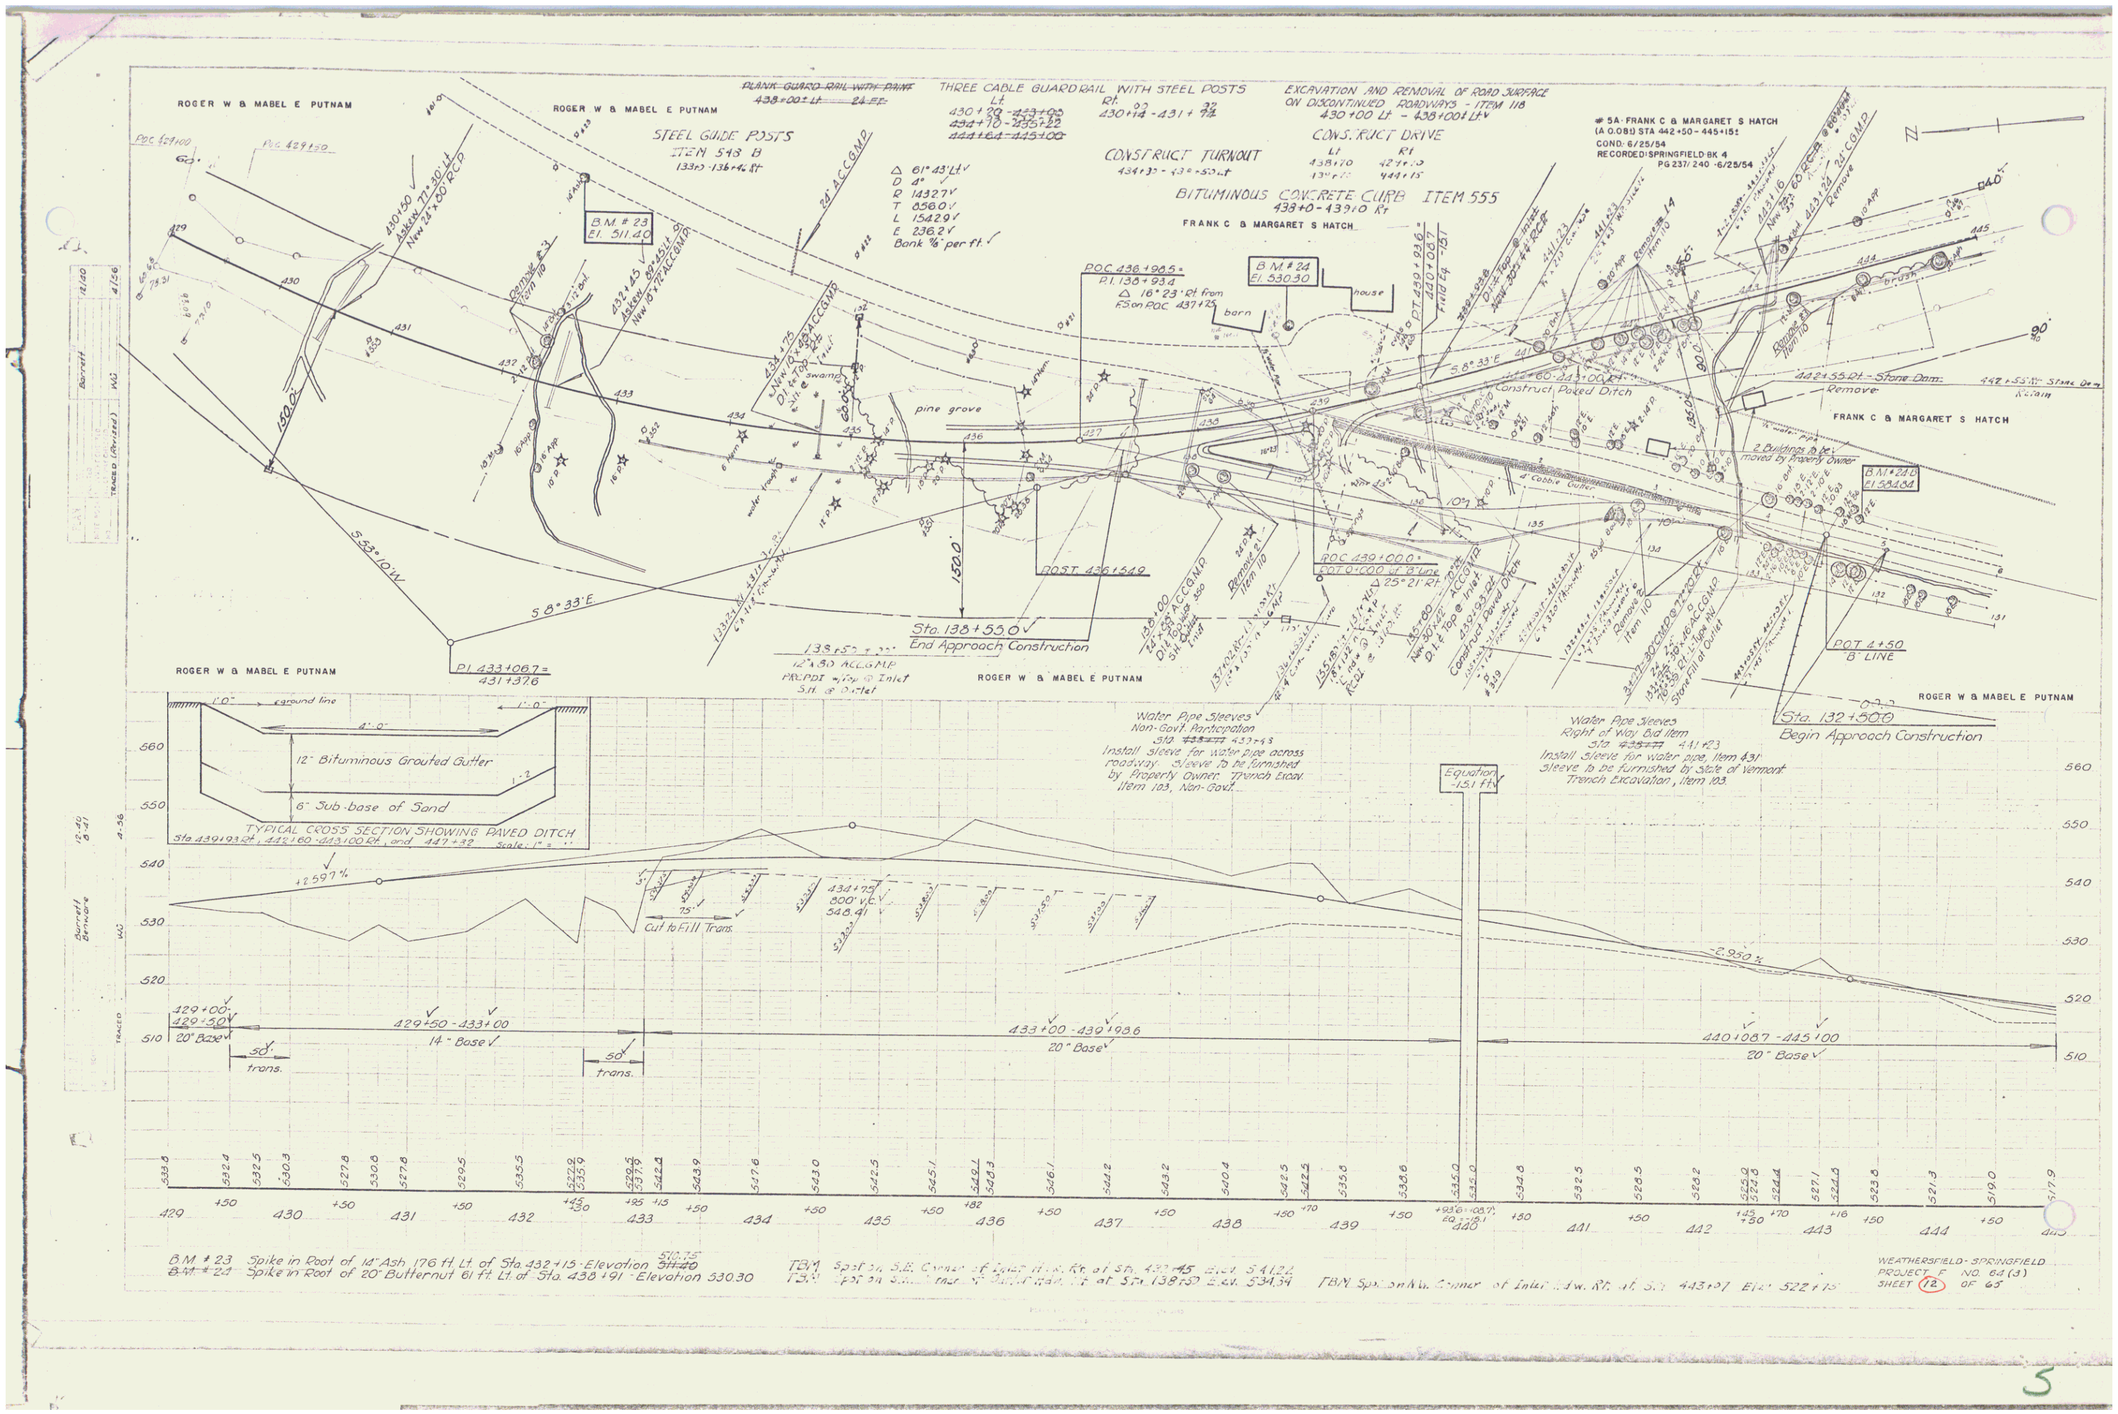
ROGER W & MABEL E PUTNAM
STEEL GUIDE POSTS
ITEM 518 B
THREE CABLE GUARDRAIL WITH STEEL POSTS
CONSTRUCT TURNOUT
BITUMINOUS CONCRETE CURB ITEM 555
FRANK C & MARGARET S HATCH
EXCAVATION AND REMOVAL OF ROAD SURFACE ON DISCONTINUED ROADWAYS - ITEM 118
CONSTRUCT DRIVE
#5A FRANK C & MARGARET S HATCH
(A.O.D.B) STA 442+50 - 445+15±
COND: 6/25/54
RECORDED: SPRINGFIELD BK 4 PG 237/240 - 6/25/54
B.M. # 23 El. 511.40
B.M. # 24 El. 530.30
house
barn
pine grove
Construct Paved Ditch
Remove Stone Dam
2 Buildings to be moved by Property Owner
Sta. 138+55.0
End Approach Construction
Sta. 132+50.0
Begin Approach Construction
POT 4+50 B' LINE
Water Pipe Sleeves Non-Govt. Participation
Install sleeve for water pipe across roadway. Sleeve to be furnished by Property Owner. Trench Excav. Item 103, Non-Govt.
Water Pipe Sleeves Right of Way Bid Item
Install sleeve for water pipe, Item 431 Sleeve to be furnished by State of Vermont Trench Excavation, Item 103.
Equation -15.1 ft
TYPICAL CROSS SECTION SHOWING PAVED DITCH
12" Bituminous Grouted Gutter
6" Sub-base of Sand
Cut to Fill Trans.
429+00 - 429+50 20" Base
429+50 - 433+00 14" Base
433+00 - 439+98.6 20" Base
440+08.7 - 445+00 20" Base
B.M. # 23 Spike in Root of 14" Ash 176 ft. Lt. of Sta. 432+15 - Elevation 510.75
B.M. # 24 Spike in Root of 20" Butternut 61 ft. Lt. of Sta. 438+91 - Elevation 530.30
WEATHERSFIELD - SPRINGFIELD
PROJECT F NO. 64(3)
SHEET 12 OF 65

5