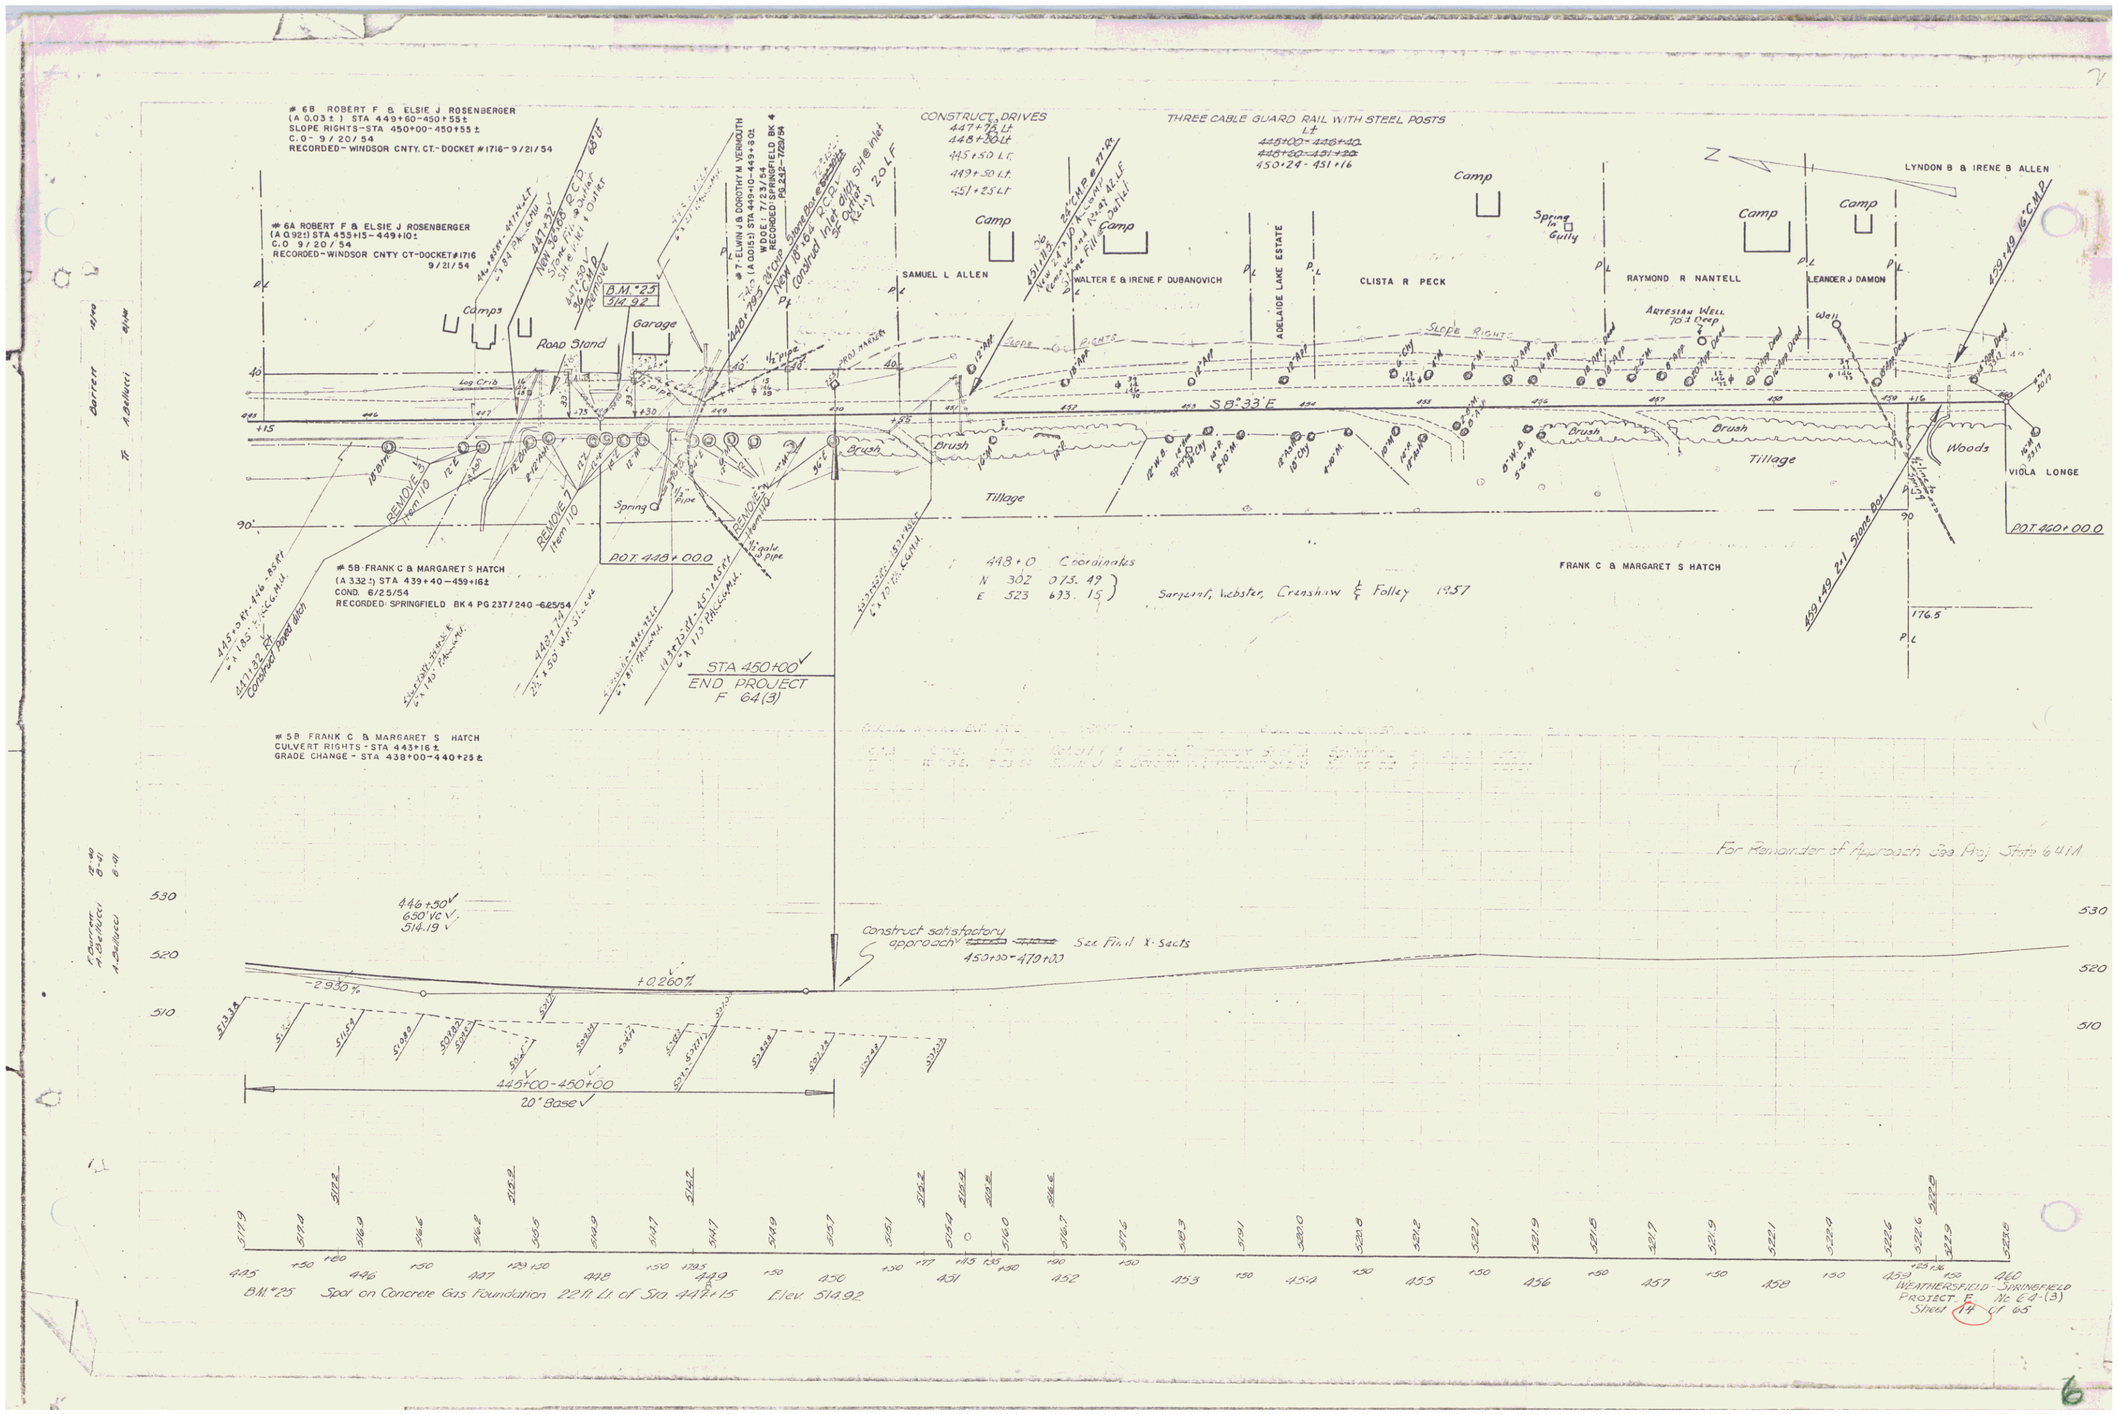
#6B ROBERT F & ELSIE J ROSENBERGER
(A 0.03 ±) STA 449+60-450+55±
SLOPE RIGHTS-STA 450+00-450+55 ±
C.O- 9/20/54
RECORDED-WINDSOR CNTY. CT.-DOCKET #1716-9/21/54
#6A ROBERT F & ELSIE J ROSENBERGER
(A 0.92±) STA 455+15-449+10±
C.O 9/20/54
RECORDED-WINDSOR CNTY CT-DOCKET #1716 9/21/54
#7 ELWIN J & DOROTHY M VERHOUTH
(A 0.03 ±) STA 449+60-449+82
W.D.E. 7/23/54
RECORDED SPRINGFIELD BK 4 PG 232-7/23/54
CONSTRUCT DRIVES
447+70 Lt.
448+30 Lt.
445+50 Lt.
449+50 Lt.
451+25 Lt.
THREE CABLE GUARD RAIL WITH STEEL POSTS
Lt
450+00-451+16
LYNDON B & IRENE B ALLEN
SAMUEL L ALLEN
WALTER E & IRENE F DUBANOVICH
ADELAIDE LAKE ESTATE
CLISTA R PECK
RAYMOND R NANTELL
LEANDER J DAMON
VIOLA LONGE
FRANK C & MARGARET S HATCH
Camps
Camp
Road Stand
Garage
Log Crib
Spring
Spring in Gully
Artesian Well 70' Deep
Well
Brush
Tillage
Woods
SLOPE RIGHT
S 8°33' E
B.M. #25
Elev 92
POT 448+00.0
POT 450+00.0
448+0 Coordinates
N 302 073.49
E 523 633.15
Sargent, Webster, Crenshaw & Folley 1957
#5B FRANK C & MARGARET S HATCH
(A 3.32 ±) STA 439+40-459+16±
COND. 6/25/54
RECORDED SPRINGFIELD BK 4 PG 237/240-6/25/54
REMOVE Item 110
STA 450+00
END PROJECT
F 64(3)
#5B FRANK C & MARGARET S HATCH
CULVERT RIGHTS - STA 443+16±
GRADE CHANGE - STA 438+00-440+25±
For Remainder of Approach See Proj. State 6411
446+50
650' VC
514.19
-2.930%
+0.260%
Construct satisfactory approach
450+00-470+00
See Final X-Sects
445+00-450+00
20' Base
BM #25 Spot on Concrete Gas Foundation 22 ft. Lt. of Sta 447+15 Elev 514.92
WEATHERSFIELD - SPRINGFIELD
PROJECT F No 64-(3)
Sheet 14 Of 65